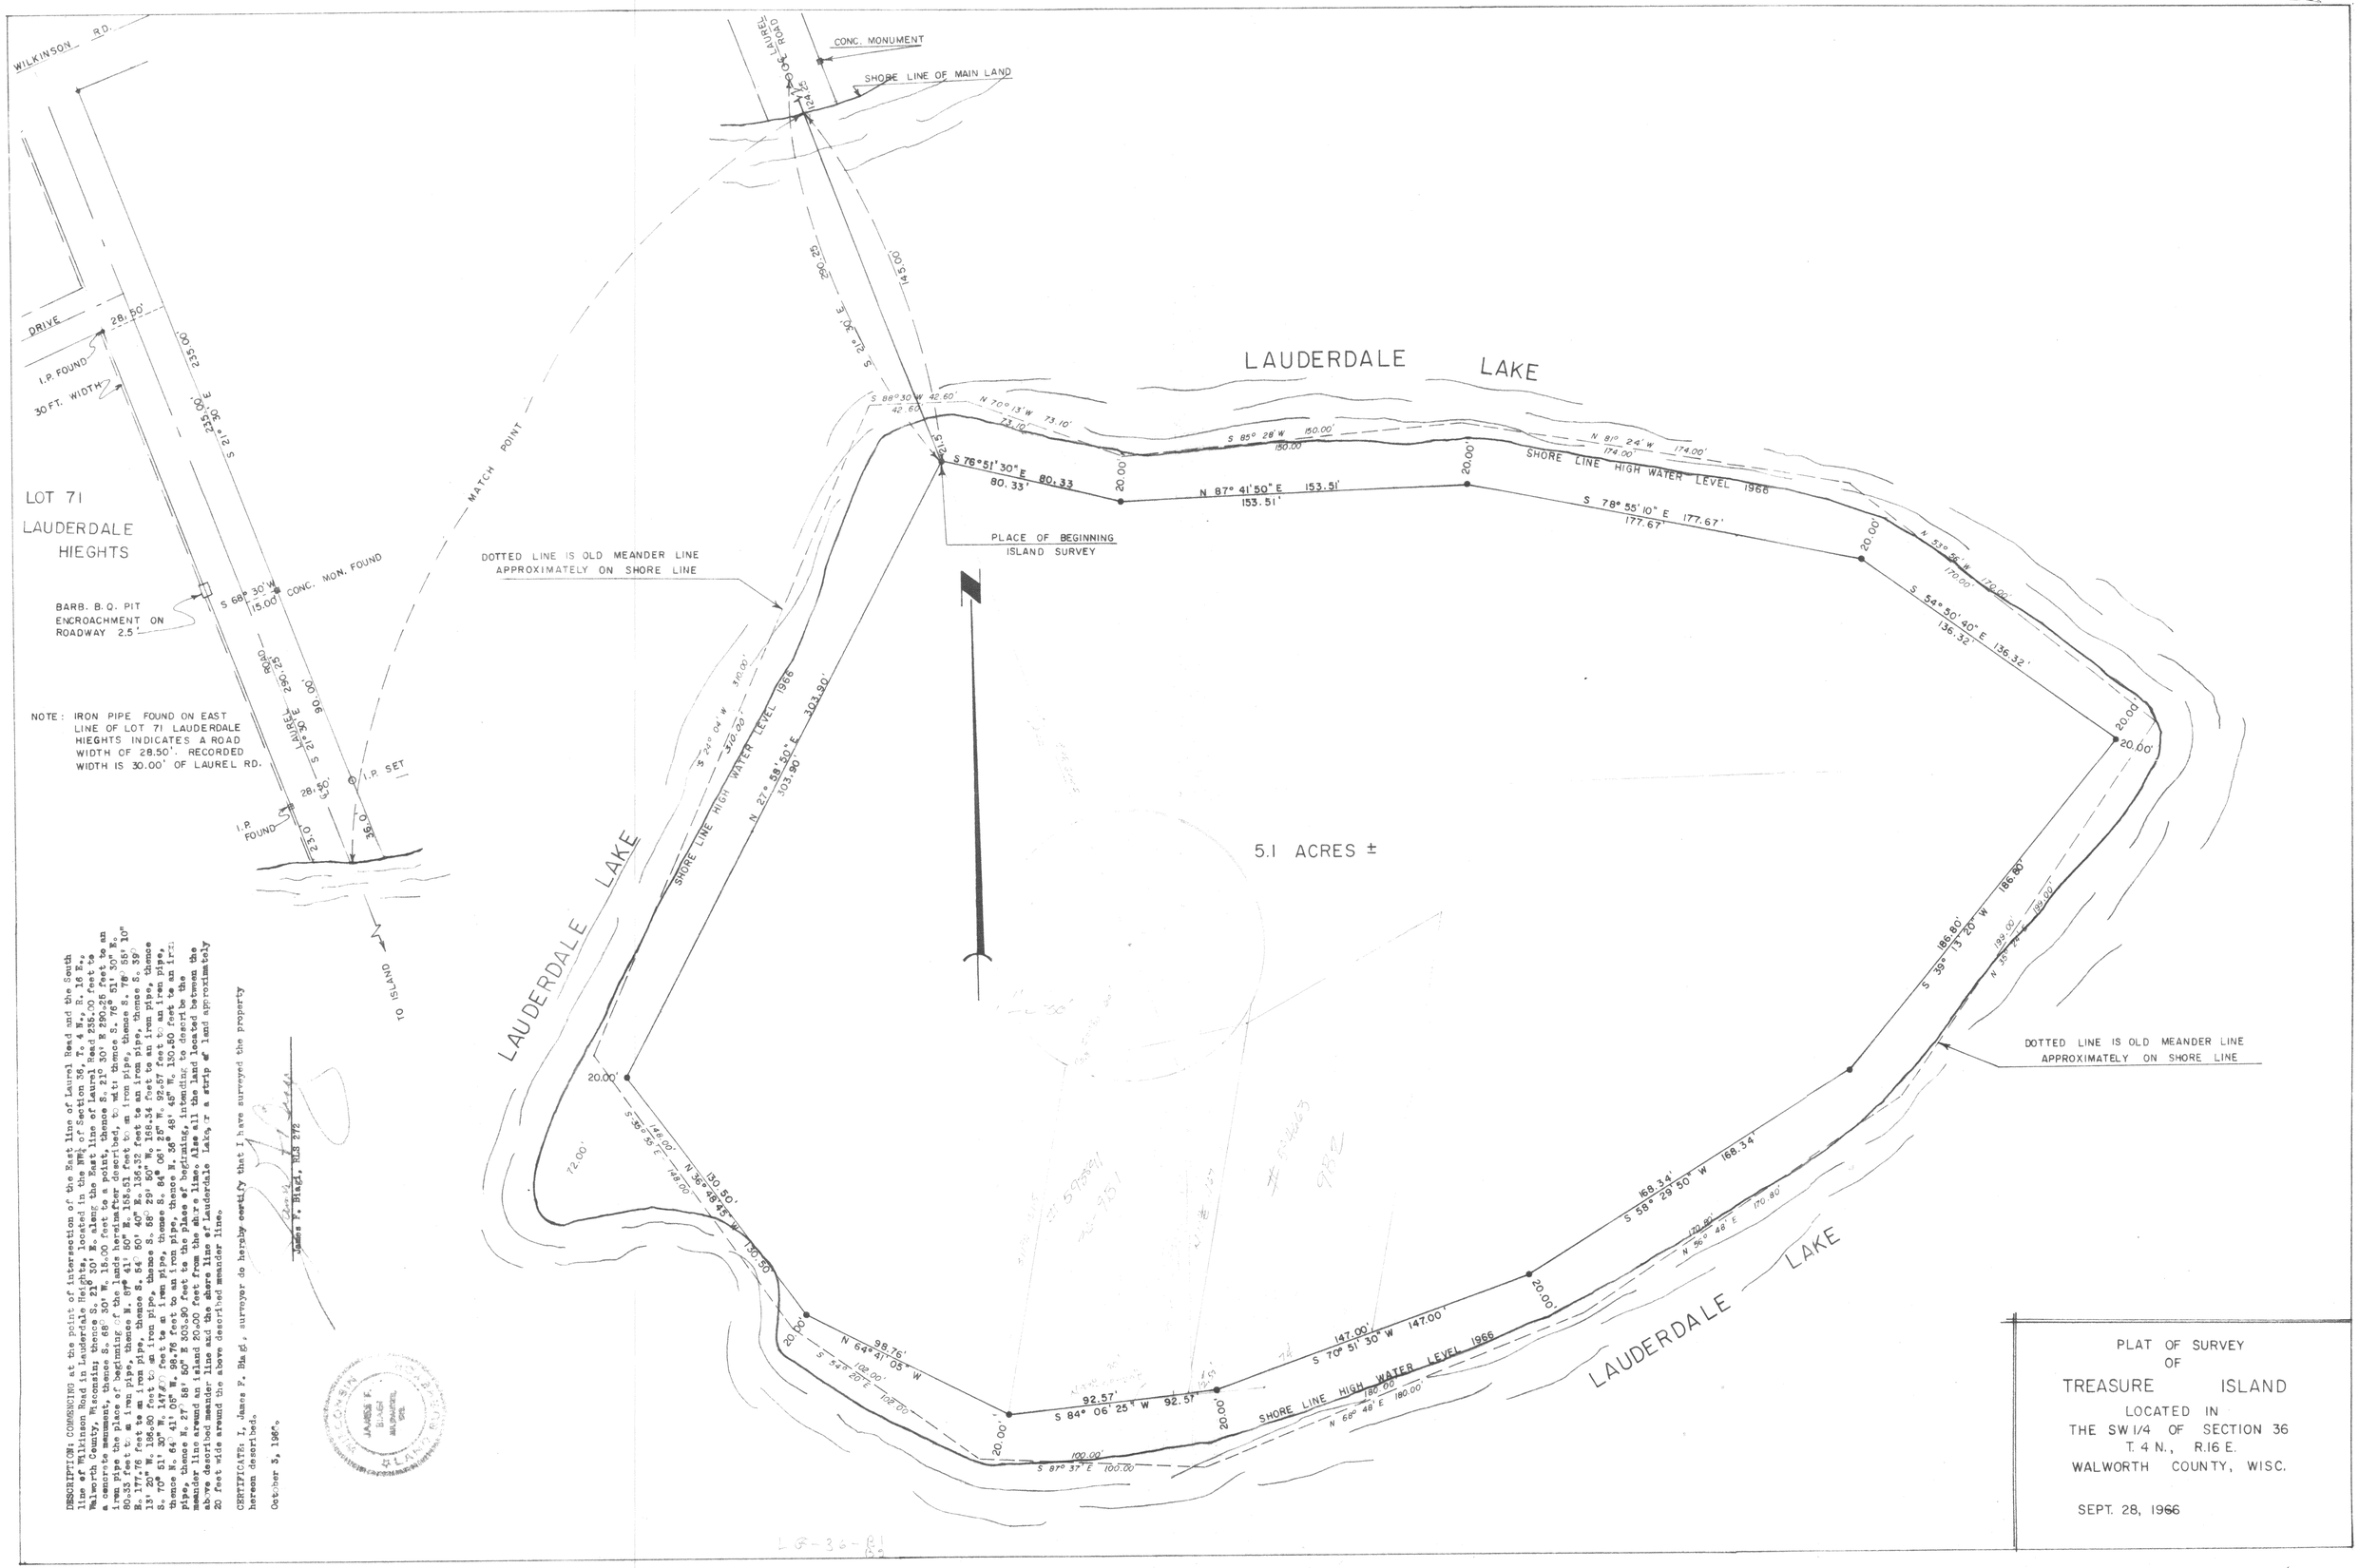

DESCRIPTION: COMMENCING at the point of intersection of the East line of Laurel Road and the South line of Wilkinson Road in Lauderdale Heights, located in the NW¼ of Section 36, T. 4 N., R. 16 E., Walworth County, Wisconsin; thence S. 21° 30' E. along the East line of Laurel Road 235.00 feet to a concrete monument, thence S. 68° 30' W. 15.00 feet to a point, thence S. 21° 30' E 290.25 feet to an iron pipe the place of beginning of the lands hereinafter described, to wit: thence S. 76° 51' 30" E. 80.33 feet to an iron pipe, thence N. 87° 41' 50" E. 153.51 feet to an iron pipe, thence S. 78° 55' 10" E. 177.67 feet to an iron pipe, thence N. 33° 56' W. 170.00 feet to an iron pipe, thence S. 54° 50' 40" E. 136.32 feet to an iron pipe, thence S. 39° 13' 20" W. 186.80 feet to an iron pipe, thence S. 58° 29' 50" W. 168.34 feet to an iron pipe, thence S. 70° 51' 30" W. 147.00 feet to an iron pipe, thence S. 84° 06' 25" W. 92.57 feet to an iron pipe, thence N. 64° 41' 05" W. 98.76 feet to an iron pipe, thence N. 36° 48' 45" W. 130.50 feet to an iron pipe, thence N. 27° 58' 50" E 303.90 feet to the place of beginning, intending to describe the meander line around an island 20.00 feet from the shore line. Also all the land located between the above described meander line and the shore line of Lauderdale Lake, or a strip of land approximately 20 feet wide around the above described meander line.

CERTIFICATE: I, James F. Blagg, surveyor do hereby certify that I have surveyed the property hereon described.

October 5, 1966.

James F. Blagg, R.L.S. 272

JAMES F. BLAGG
WALWORTH
WISC.
LAND SURVEYOR

PLAT OF SURVEY
OF
TREASURE ISLAND
LOCATED IN
THE SW 1/4 OF SECTION 36
T. 4 N., R.16 E.
WALWORTH COUNTY, WISC.

SEPT. 28, 1966

LG-36-P1

416-51