DUNHAM SURVEYING, S.C.
SURVEYING & SUBDIVIDING
DELAVAN, WISCONSIN 53115

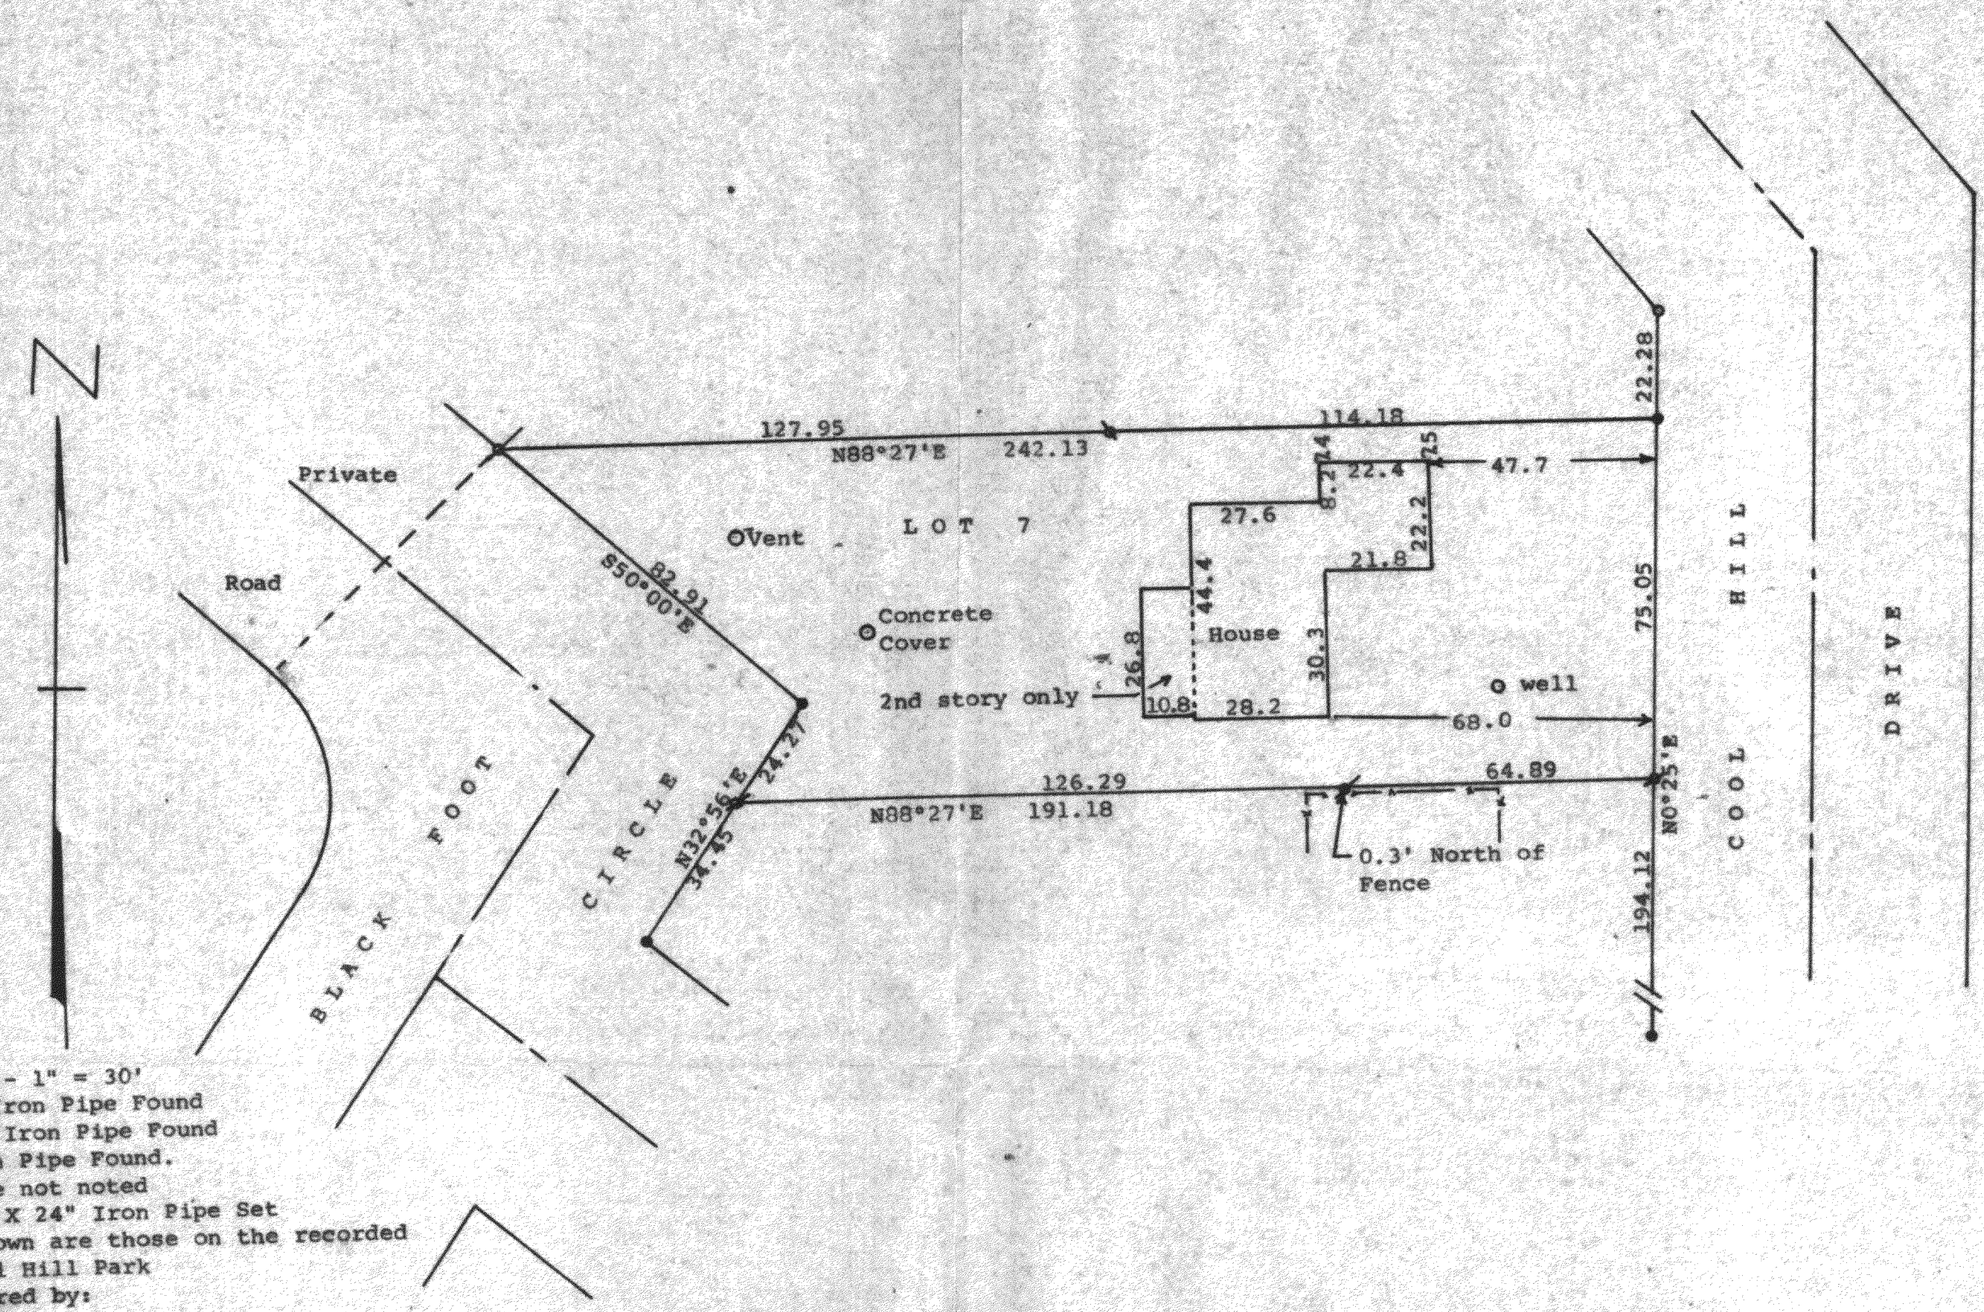

Scale - 1" = 30'
● = 2" Iron Pipe Found
ø = 1¼" Iron Pipe Found
o = Iron Pipe Found. Size not noted
⊗ = 1¼" X 24" Iron Pipe Set

Bearings shown are those on the recorded plat of Cool Hill Park

Survey ordered by:
The Rauland AGency
118 Kenosha
Walworth, WI 53184

STATE OF WISCONSIN) SS
COUNTY OF WALWORTH)

I, George T. Dunham, Surveyor, certify that I have surveyed the property described as follows:

Lot 7 in Block 2 of Cool Hill Park, a subdivision located in Section 35, T 4 N, R 16 E, Walworth County, Wisconsin,

and that the plat shown hereon is a correct representation thereof and shows the size and location of the property, its exterior boundaries, the location of all visible structures and dimensions of all principal buildings thereon, boundary fences, apparent easements, roadways and visible encroachments, if any, and that I have surveyed the property hereon described, according to the official records, to the best of my knowledge and belief.

April 12, 1988

RECEIVED
AUG 29 1988

George T. Dunham, Surveyor

WISCONSIN
GEORGE T. DUNHAM
S-306
DELAVAN WIS.
LAND SURVEYOR

78307
GMB 1020

HCH-13

416-514