
PLAT OF SURVEY

- OF -

LOT 1 BLOCK 2, LOT 5 BLOCK 1, AND PART OF OAK ROAD, ALL IN COOPERS MID LAKES SUBDIVISION, LOCATED IN SECTION 35, T 4 N, R 16 E, TOWN OF LAGRANGE, WALWORTH COUNTY, WISCONSIN

ORDERED BY: WILLIAM SEYMOUR
23 N. WISCONSIN ST.
ELKHORN, WI 53121

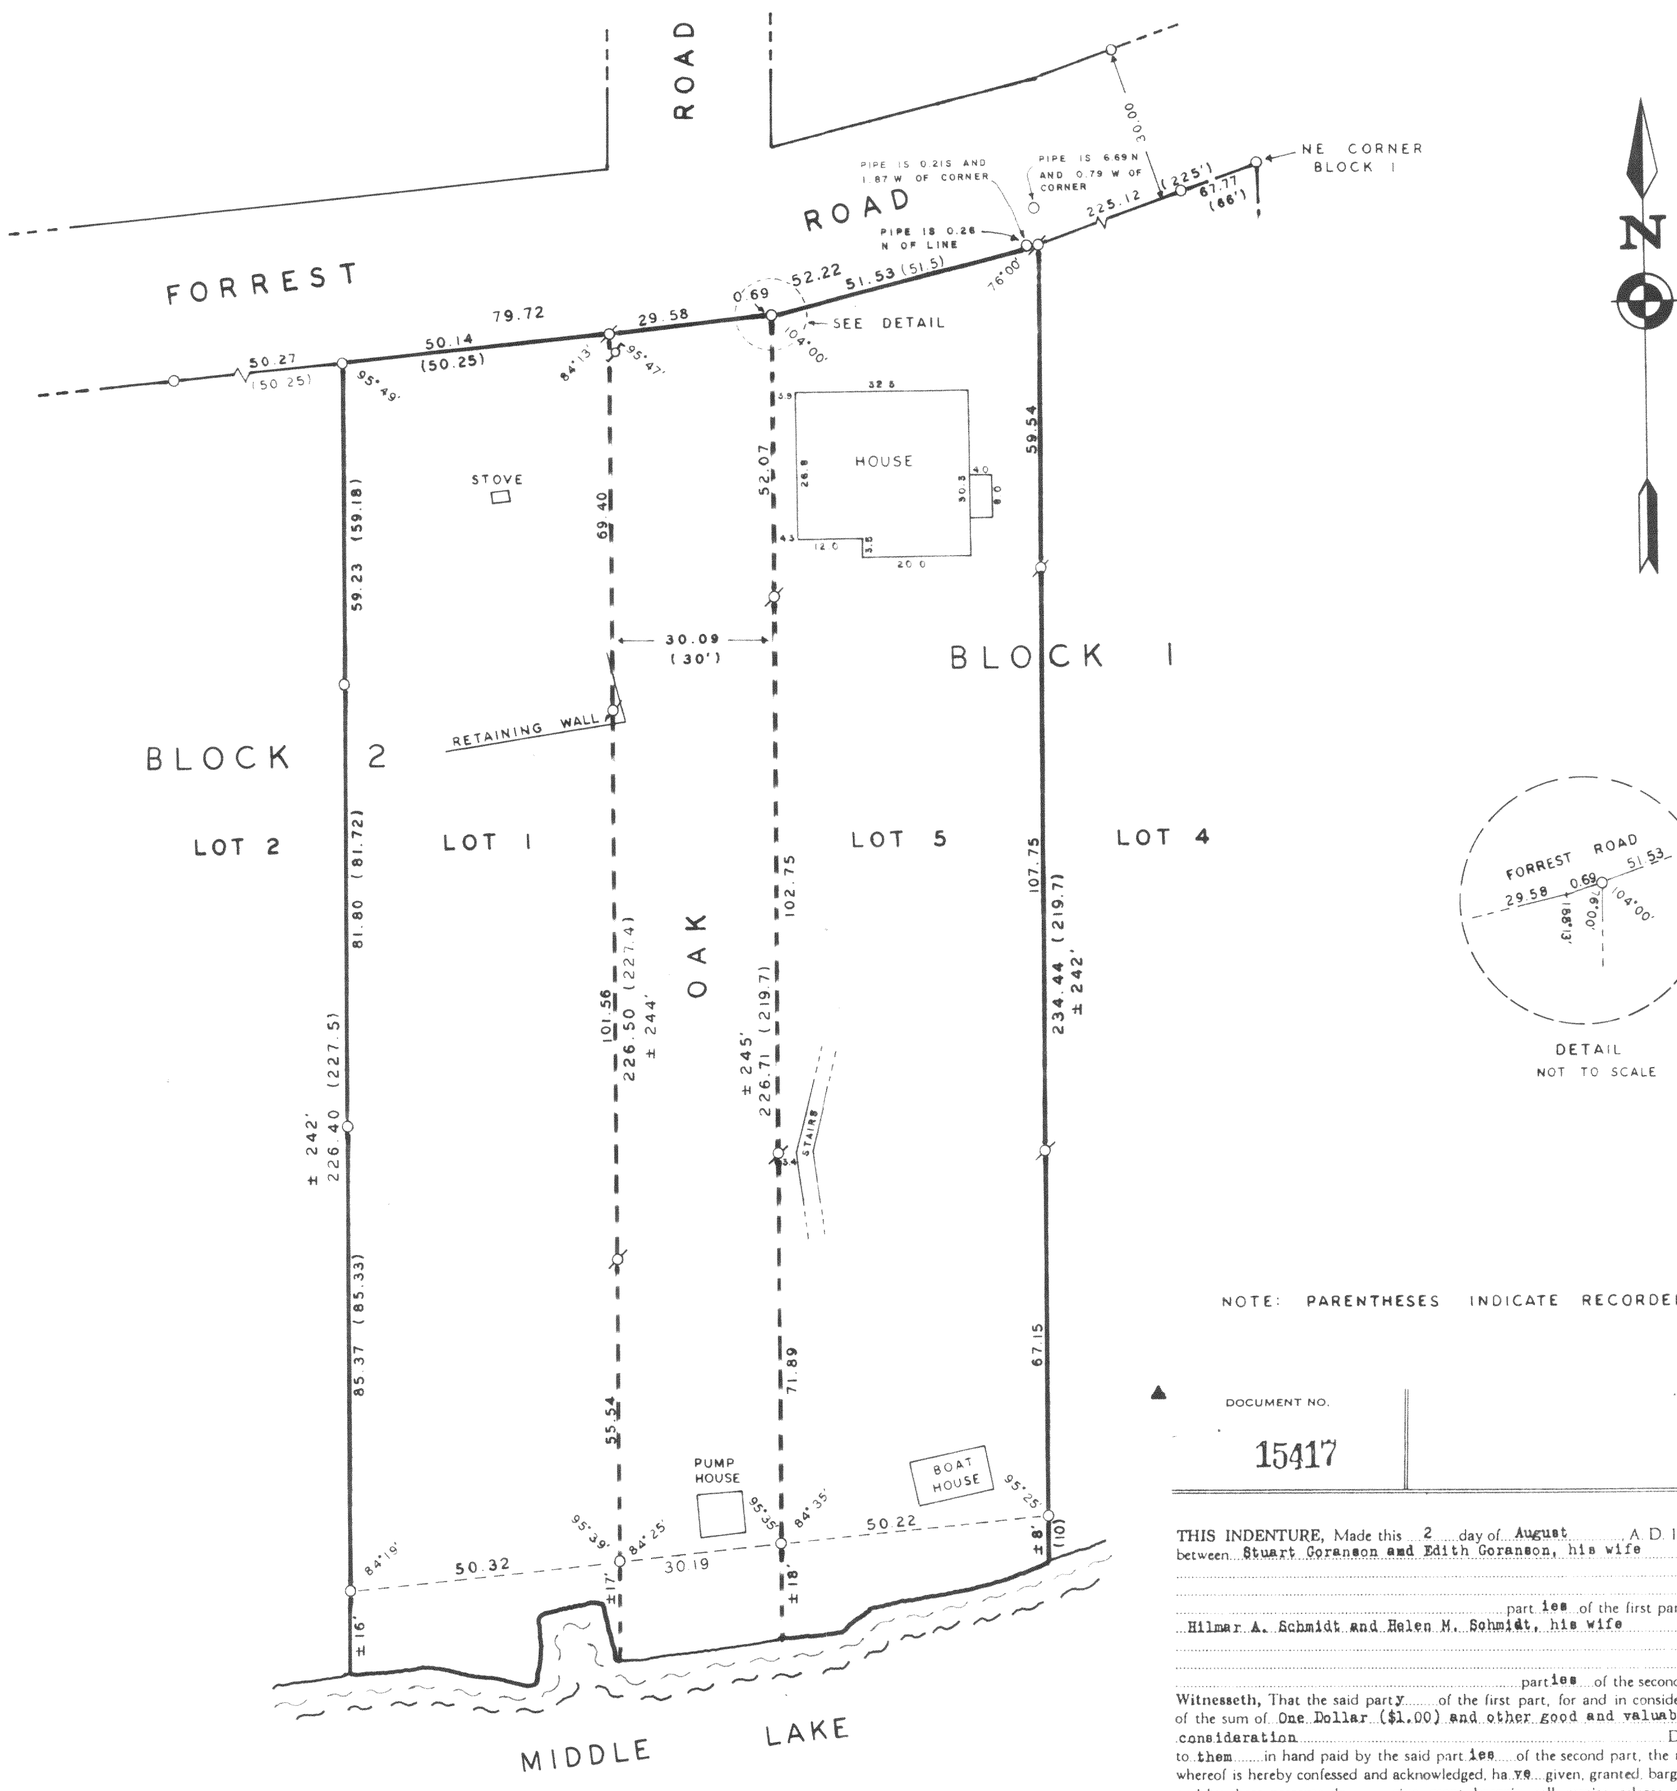

DETAIL
NOT TO SCALE

NOTE: PARENTHESES INDICATE RECORDED DIMENSIONS

▲ DOCUMENT NO. 15417

QUIT CLAIM DEED
STATE OF WISCONSIN - FORM 11

THIS SPACE RESERVED FOR RECORDING DATA

RECORDED IN VOL 182
PAGE 283
'77 APR 15 PM 12 09
LOIS M. [illegible] JENSEN
REG. OF DEEDS
WALWORTH COUNTY, WIS

RETURN TO Hilmar Schmidt
916 Hillcrest Lane
Elmhurst, Il 60126

THIS INDENTURE, Made this 2 day of August, A. D. 1968, between Stuart Goranson and Edith Goranson, his wife

part ies of the first part, and Hilmar A. Schmidt and Helen M. Schmidt, his wife

parties of the second part,

Witnesseth, That the said party of the first part, for and in consideration of the sum of One Dollar ($1.00) and other good and valuable consideration Dollars, to them in hand paid by the said parties of the second part, the receipt whereof is hereby confessed and acknowledged, ha ve given, granted, bargained, sold remised, released, and quit-claimed, and by these presents do give, grant, bargain, sell, remise, release, and quit-claim unto the said parties of the second part, and to their heirs and assigns forever, the following described real estate, situated in the County of Walworth and State of Wisconsin, to-wit:

That land as lies between Lot five (5) in Block One (1) and Lot One in Block Two (2) of Cooper's Mid-Lakes Subdivision as per plat recorded in the office of the Register of Deeds in Volume eight (8) of plats on page 42.

I, Thomas P.A. Jensen, Wisconsin Registered Land Surveyor, do hereby certify that this survey was performed by me, or under my direction, in full compliance with the owner's/agent's instructions and Chapter A-E 5 of the Wisconsin Administrative Code "Minimum Standards For Property Surveys"; and that this map is an accurate representation thereof to the best of my knowledge and belief.

Thomas P.A. Jensen R.L.S-1084
Jensen Surveying & Mapping S.C.

Note: This survey plat is not certified unless signed and sealed in red ink.

Copyright © 1988 by Jensen Surveying & Mapping S.C.

All rights reserved. No part of this survey plat may be reproduced or transmitted in any form by any means - graphic, electronic, or mechanical, including photocopying, tracing, or information storage and retrieval systems - without permission in writing from Thomas P.A. Jensen, Jensen Surveying & Mapping S.C.

RECEIVED
OCT 20 1988

416 533

1988.028

Sheet no. 1 of 1 sheets.

Job reference number 1988.028

Legend
- O FOUND IRON PIPE
- ⌀ SET IRON PIPE
- ⌀ POWER POLE

JENSEN SURVEYING & MAPPING S.C.
45 South Wisconsin Street P.O. Box 322
Elkhorn, Wisconsin 53121
(414) 723-3434

Scale: 1" = 20'
20 10 0 20 40

Mapping date: 4-20-88

Revisions: 5-16-88