ABERNATHY and ASSOCIATES
Kenneth B. Abernathy Jr.
Wisconsin Registered Land Surveyor S-1594

Rt. 3, Box 273
Elkhorn, Wisconsin 53121
Phone: (414) 723-4260 (office)
(414) 723-4813 (residence)

PLAT OF SURVEY

LEGAL DESCRIPTION : Lot 8 of Baywood Park Subdivision, Located in the South 1/2 of Section 35, Town 4 North, Range 16 East, Town of La Grange, and the North 1/2 of Section 2, Town 4 North, Range 16 East, Town of Sugar Creek, County of Walworth, State of Wisconsin.

Tax Key Index Number HBP 00008

Current Owners: Mr. & Mrs. David Ingham
Route 1, Box 710
Elkhorn, Wisconsin
53121

Ordered by: Steve Hoyt
Post Office Box 96
Lake Geneva, Wisconsin
53147

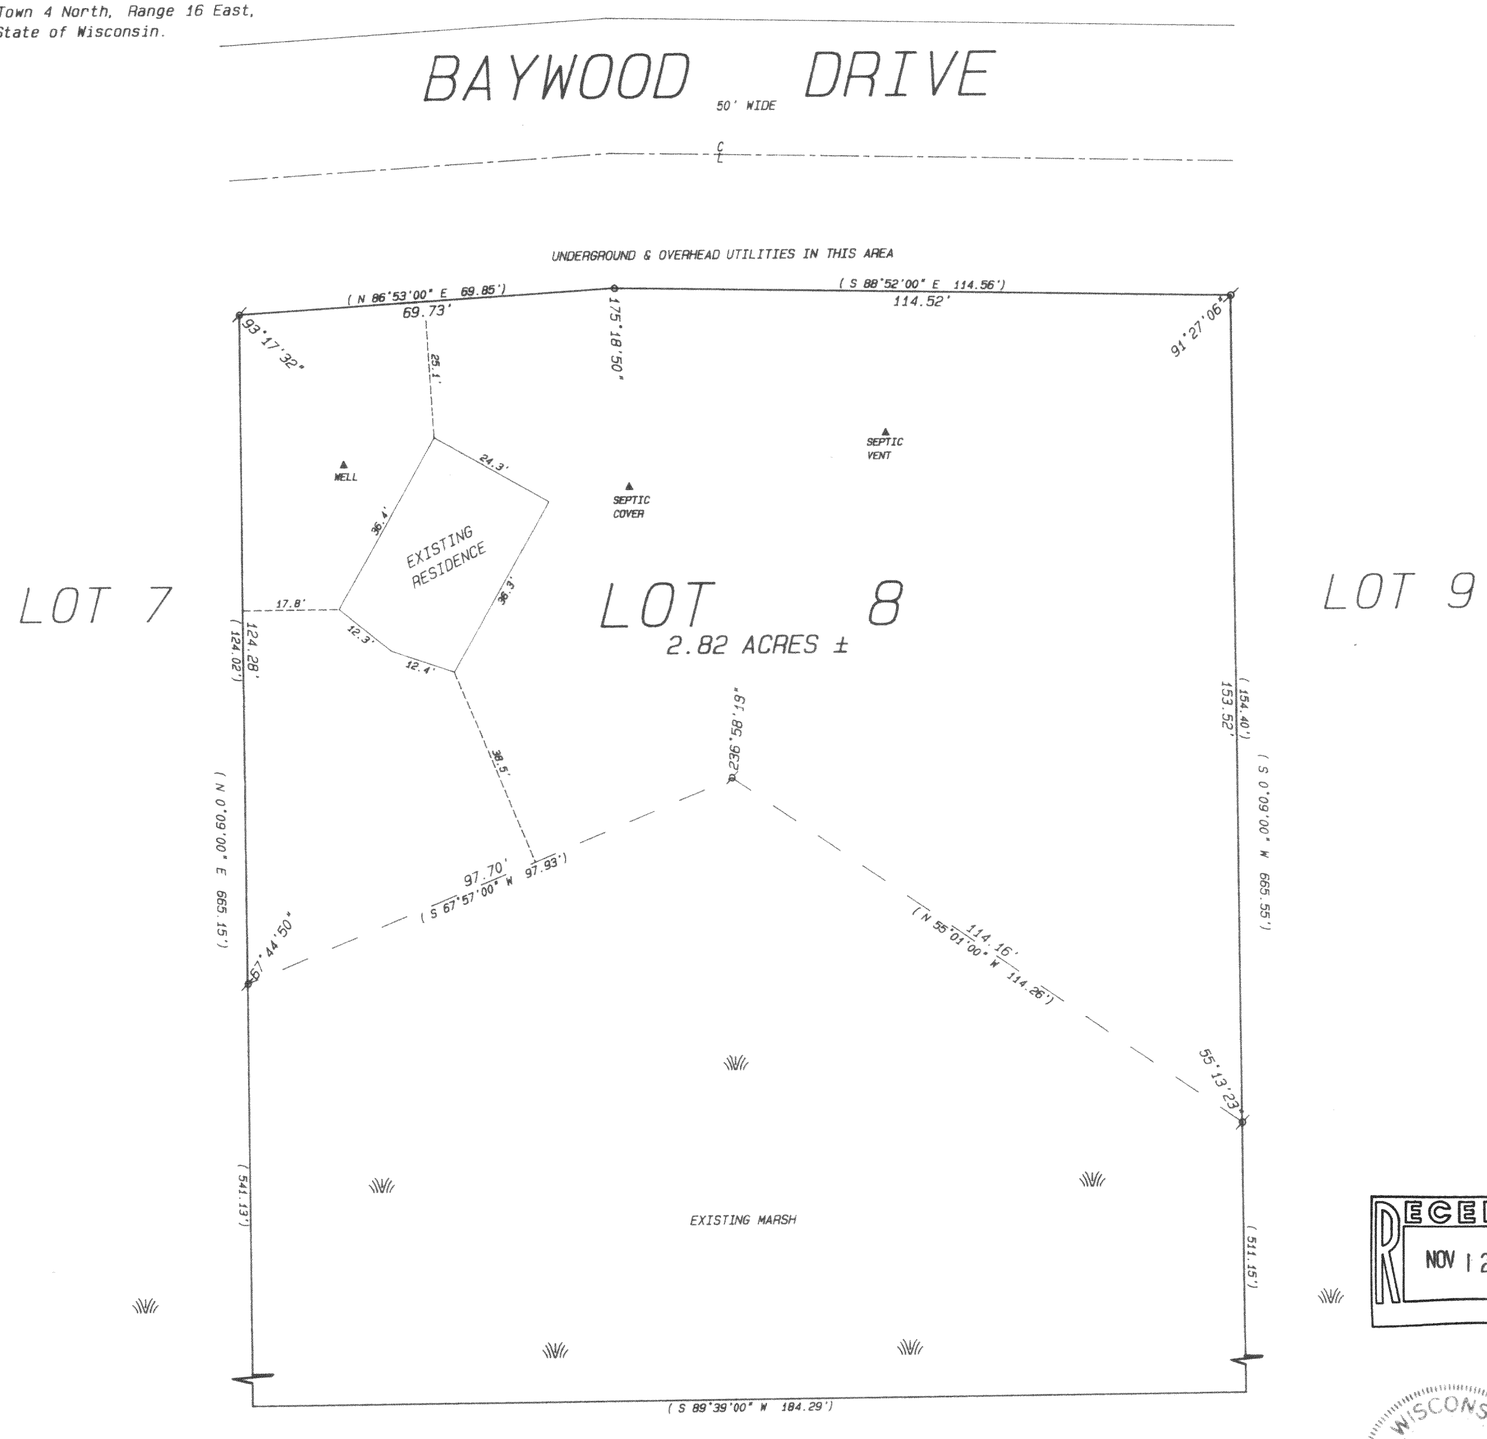

Legend

- FOUND IRON PIPE
- FOUND IRON ROD
- FOUND BRASS CAPPED MONUMENT
- FOUND CONCRETE MONUMENT
- CHISEL CUT IN CONCRETE
- SET IRON ROD, 24" LONG, WEIGHING 1.5 LBS. LINEAL FT., 3/4" DIA.
- SET IRON ROD, 30" LONG, WEIGHING 4.5 LBS. LINEAL FT., 1 11/16" DIA.
- (xx) RECORDED AS DIMENSION
- —x—x— EXISTING FENCE

N

SCALE: 1" = 20 FEET

RECEIVED
NOV 12 1990

"I hereby certify that I have surveyed the above described property and that the above map is a true representation thereof and shows the size and location of the property, its exterior boundaries, the location of all visible structures and dimensions of all principal buildings thereon, boundary fences, apparent easements, roadways and visible encroachments, if any."

"This survey is made for the use of the present owners of the property, and also those who purchase, mortgage, or guarantee the title thereto within one year from date hereof."

WISCONSIN KENNETH B. ABERNATHY JR. S-1594 ELKHORN, WI LAND SURVEYOR

KENNETH B. ABERNATHY, JR.
WISCONSIN REGISTERED LAND SURVEYOR,
S-1594

Date: October 9, 1990 Job No. 1990.1006

Tax Key # – HBP 00008

4116-1053