# PLAT OF SURVEY

FOR

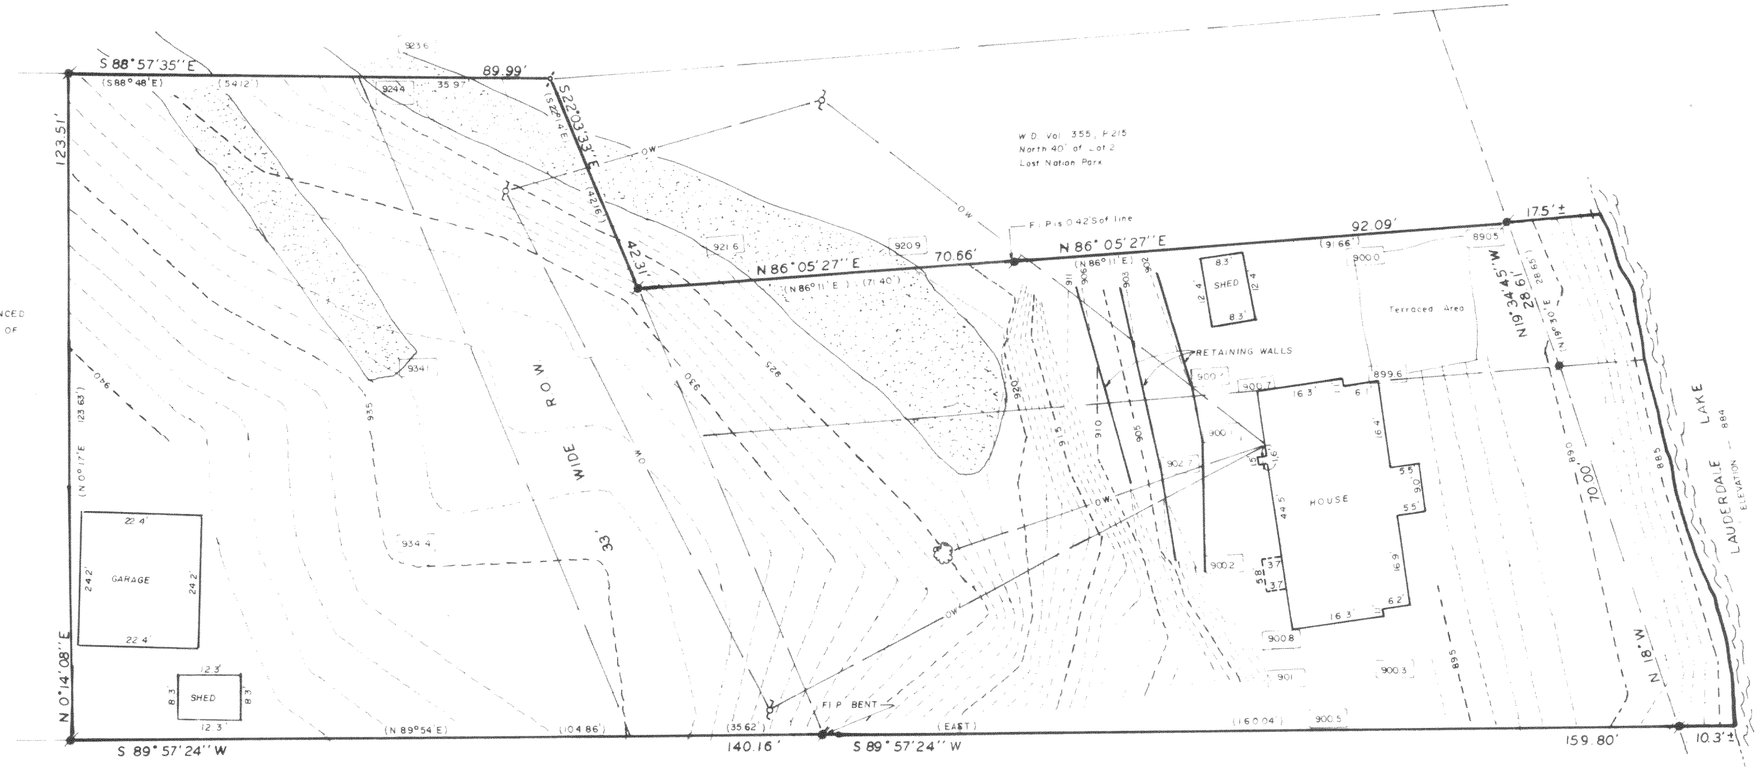
FREDERICK D. RAWLES
325 WASHINGTON ST.
WAUKEGAN, IL. 60085

OF

Tax Key No. HLPO 00001-1

Land located in the Northeast 1/4 of Section 35, Town 4 North, Range 16 East, Walworth County, Wisconsin, described as follows: Lot 1 of Lost Nation Park Subdivision and Lot 2 of Lost Nation Park Subdivision except the North 40 feet. Also, a parcel described as follows: Begin at the Northwest corner of Lot 2, thence South 22° 14' East 131.28 feet; thence South 89° 54' West 140.48 feet; thence 0° 17' East 123.63 feet; thence South 88° 48' East 90.09 feet to the point of beginning, said land subject to a 33 foot wide right-of-way along the Easterly line, which line is also the Westerly line of Lots 1 and 2 of Lost Nation Park Subdivision.

NOTE: Elevations referenced to the water level of Loddendale Lake as measured May 1, 1990 Recorded as 884.00 on the U.S.G.S. Quadrangle Map


S 88°57'35"E
(S88°48'E)
(541.2')
89.99'
S 22°03'33"E
(S22°14'E)
(132.6')
123.51'
(N 0°17'E 123.63')
N 0°14'08"E
S 89°57'24"W
(N 89°54'E)
(104.86')
140.16'
(35.62')
(EAST)
S 89°57'24"W
159.80'
10.3'±
42.31'
N 86°05'27"E
(N 86°11'E)
70.66'
F. P. is 0.42' S of line
N 86°05'27"E
92.09'
(91.66')
175'±
N 19°34'45"W
28.61'
(N 19°30'E 28.65')
N 18°W
70.00'
(N 18°E 69.90')
R.O.W.
33' WIDE
LAKE
LAUDERDALE ELEVATION - 884
W.D. Vol. 355, P. 215
North 40' of Lot 2
Lost Nation Park
GARAGE
22.4
24.2
SHED
12.3
8.3
HOUSE
RETAINING WALLS
Terraced Area
F.I.P. BENT
O.W.
9236
9244
9216
9209
9341
9344
9355
9326
9206
9202
9008
9003
9005
8995
8996
