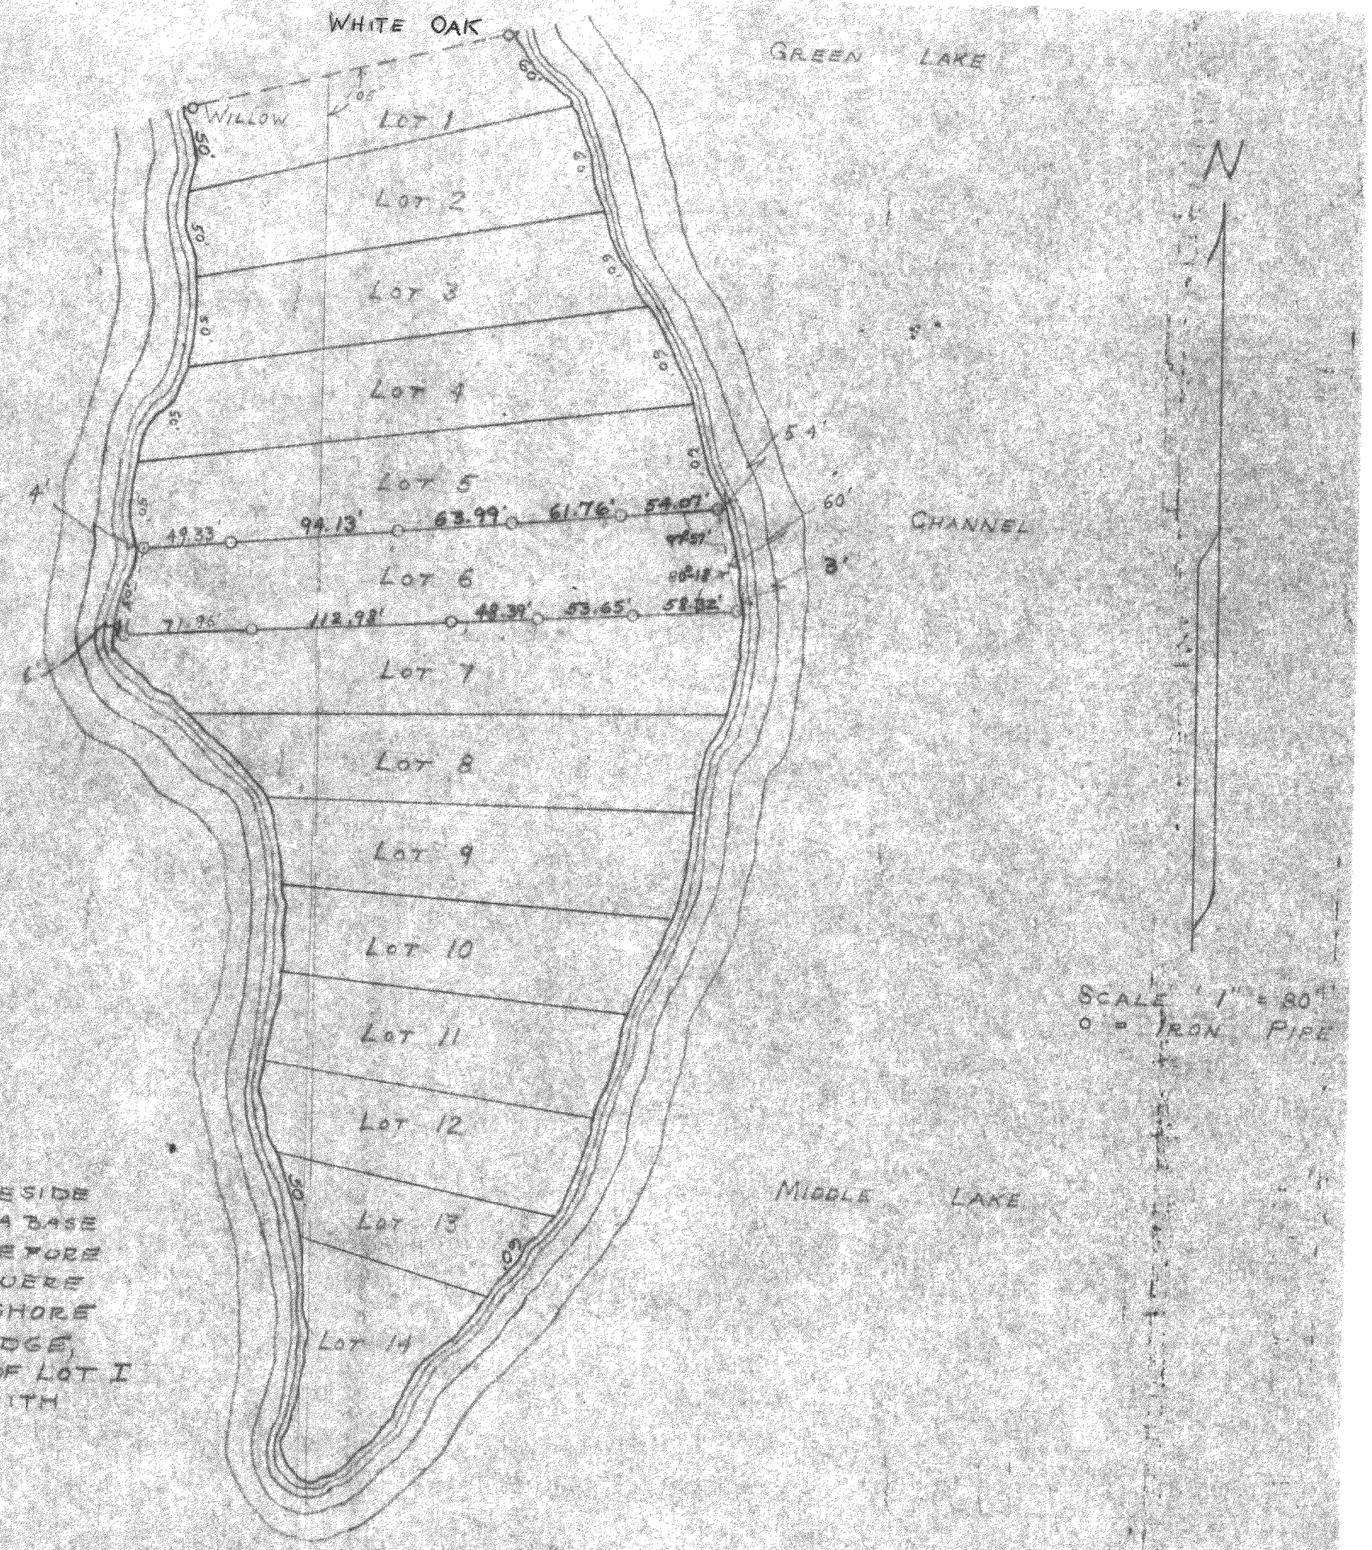


NOTE: THE RECORDED PLAT OF INGLESIDE POINT DOES NOT GIVE THE LOCATION OF A BASE LINE FOR LAYING OUT LOT LINES, THEREFORE LOT LINES FOR THE LOCATION OF LOT 6 WERE LOCATED BY MEASURING ALONG THE SHORE LINE 3-4 FEET IN FROM THE WATERS EDGE, SOUTHERLY FROM THE NORTH LINE OF LOT 1 WHICH WAS MARKED IN THE FIELD WITH IRON PIPES.

PLAT OF SURVEY OF LOT 6 OF INGLESIDE POINT, LOCATED IN THE TOWN OF LAGRANGE WALWORTH COUNTY, WISCONSIN
AUGUST 24, 1951

Floyd L. Jensen
WALWORTH COUNTY SURVEYOR

416-70.1

HIP-1B
~~HIP-1B1~~