
52-38

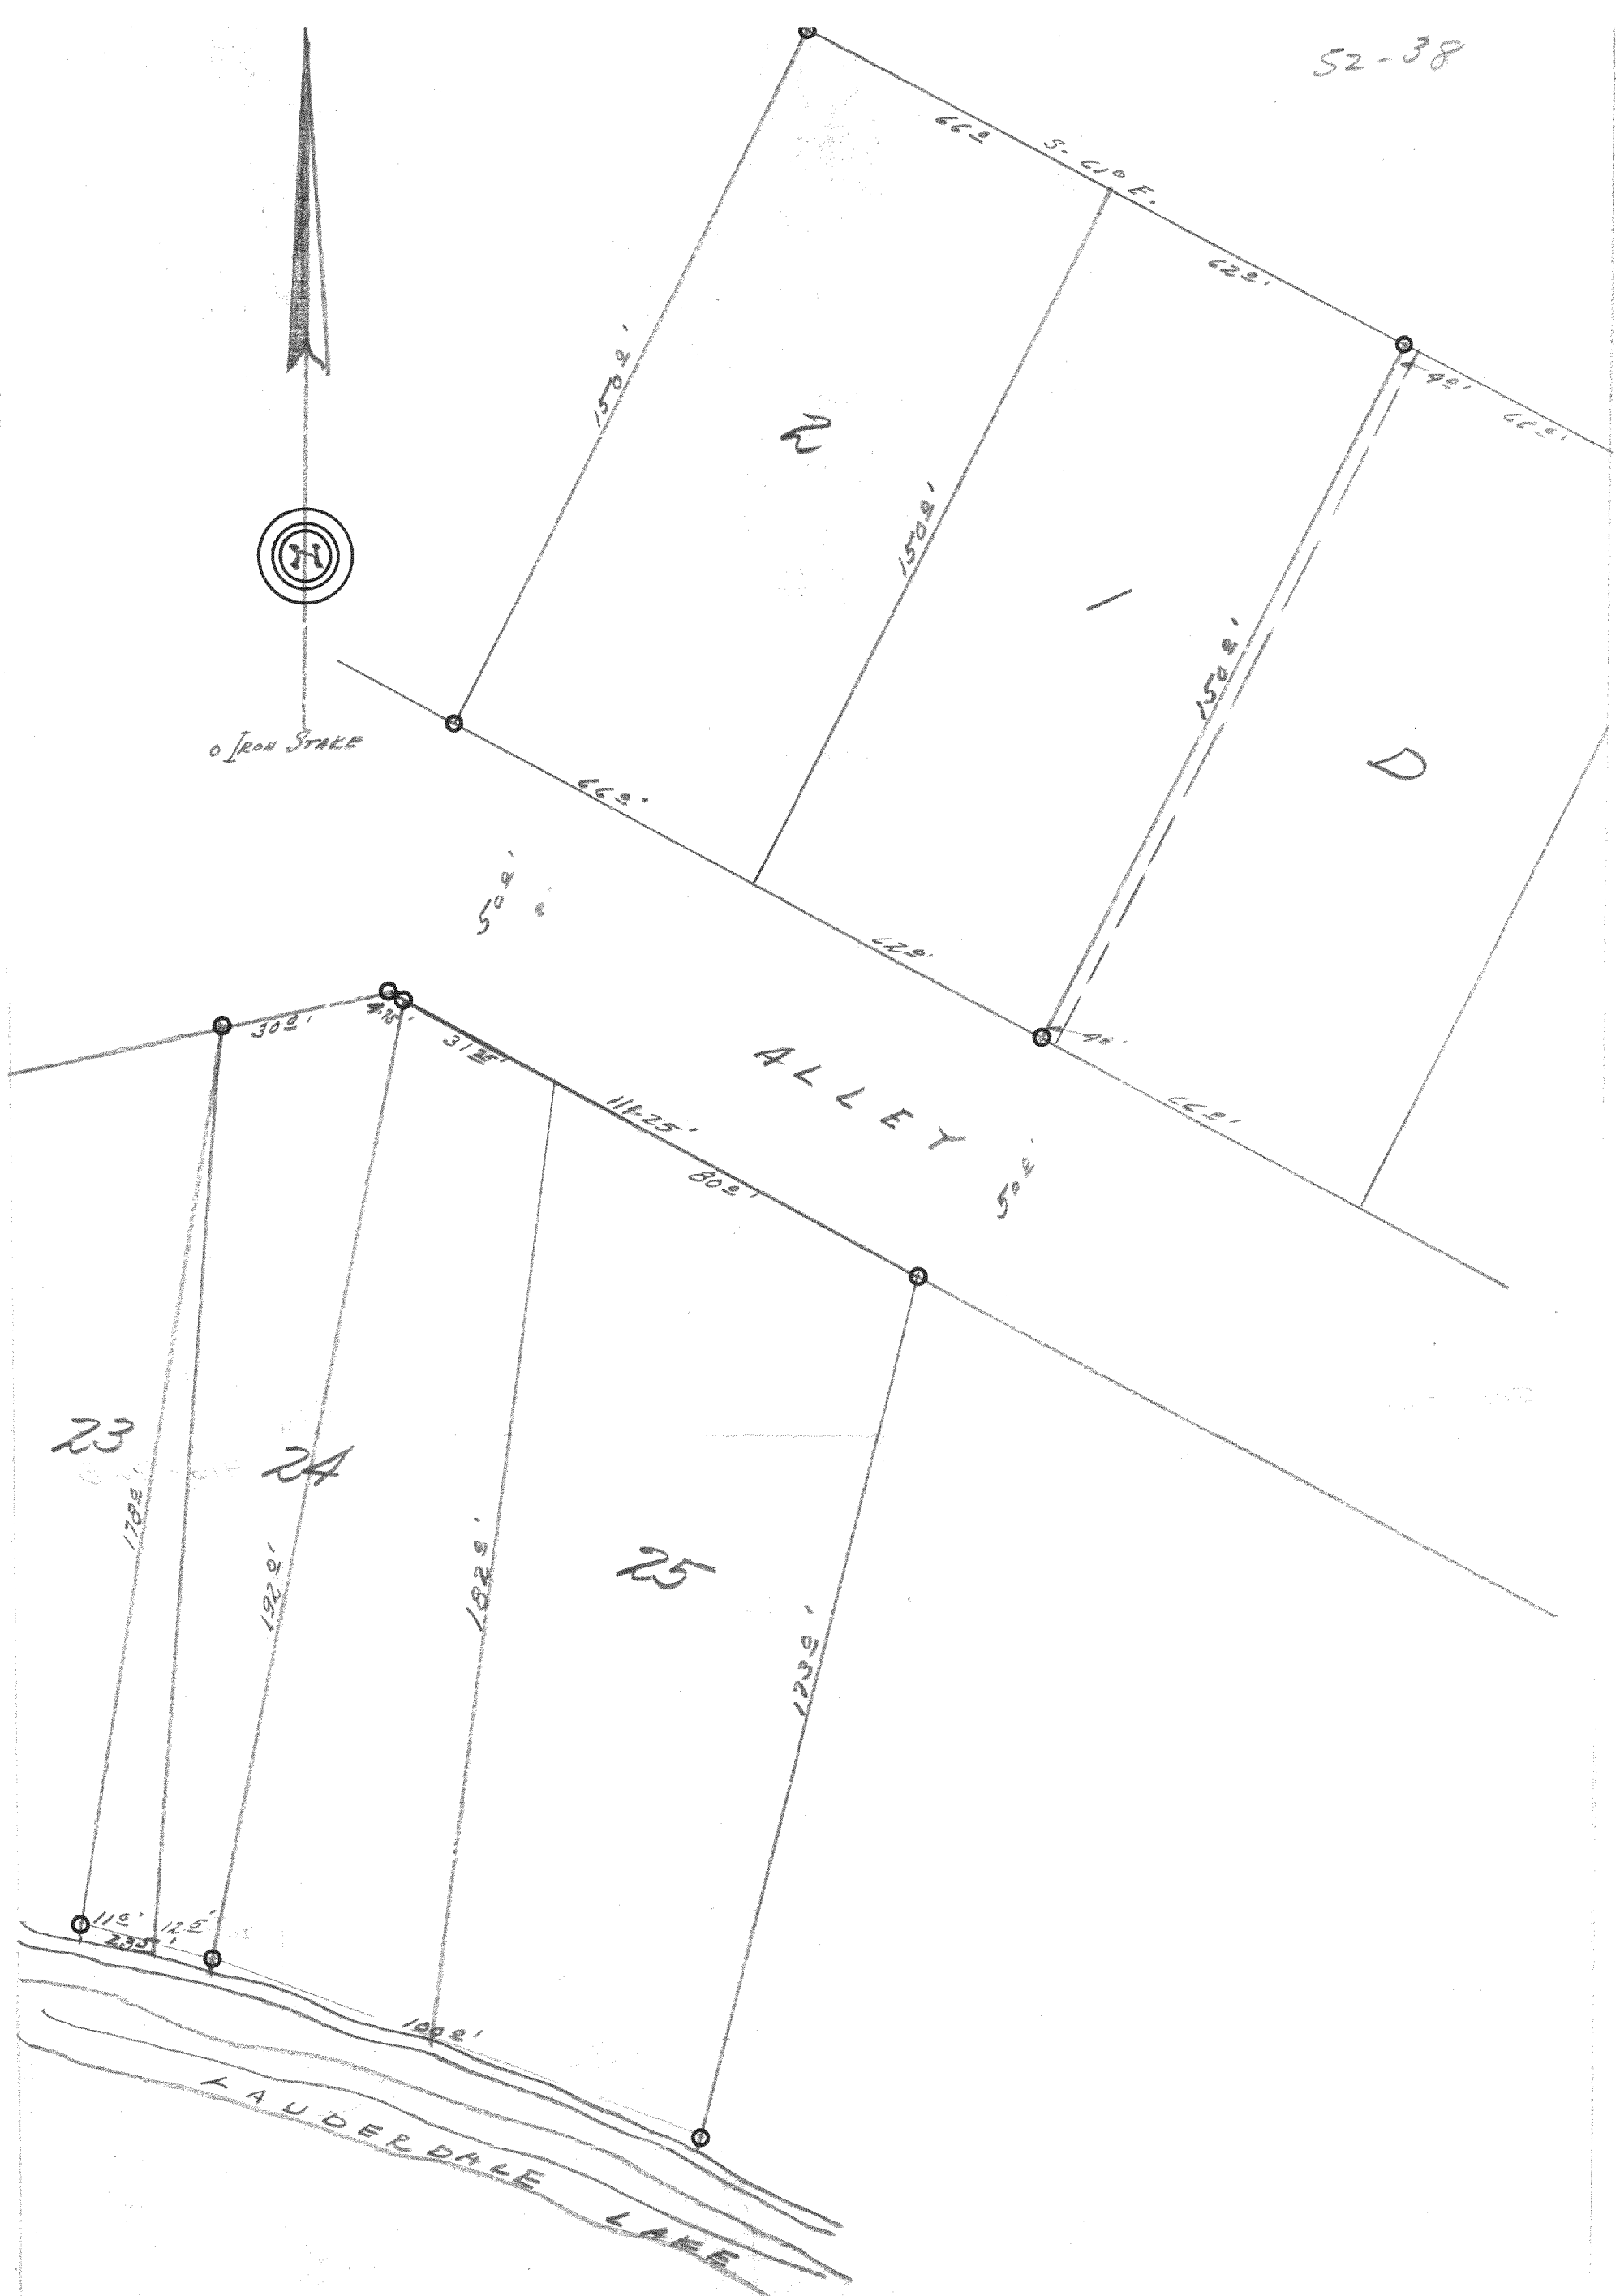

DESCRIPTION:Lot 2, and Lot 1, Droughtville Park, in Section 25, Town 4, north, Range 16, east of the 4th Principal Meridian, excepting the east 4 feet of said Lot 1,. Also the following described portion of Lots 23 and 24, in said Droughtville Park; Commencing at a point in the north line of said Lot 24, that is 31.25 feet northwest of the northeast corner of said Lot 24, thence northwest in said north line 4.75 feet to an iron stake, thence southwest in said north line of Lot 24, 30.0 feet to an iron stake at the northwest corner of said Lot24 thence south 178.0 feet to a point in the shore of Lauderdale Lake, that is 11.0 feet northwest of the southwest corner of said Lot 24, thence southeasterly along the shore of said Lauderdale Lake, 23.5 feet, to an iron stake, thence northeasterly 192.0 feet to the place of beginning.

CERTIFICATE: I, hereby certify that I have surveyed the above described property on this the 31st day of July 1952.

SIGNED AND SEALED ON THIS THE 1ST DAY OF AUGUST 1952.

Joseph M. Biagi. Professional Engineer.
Elkhorn Wisconsin.

HDP-11.24A

416-72B