PLAT OF SURVEY

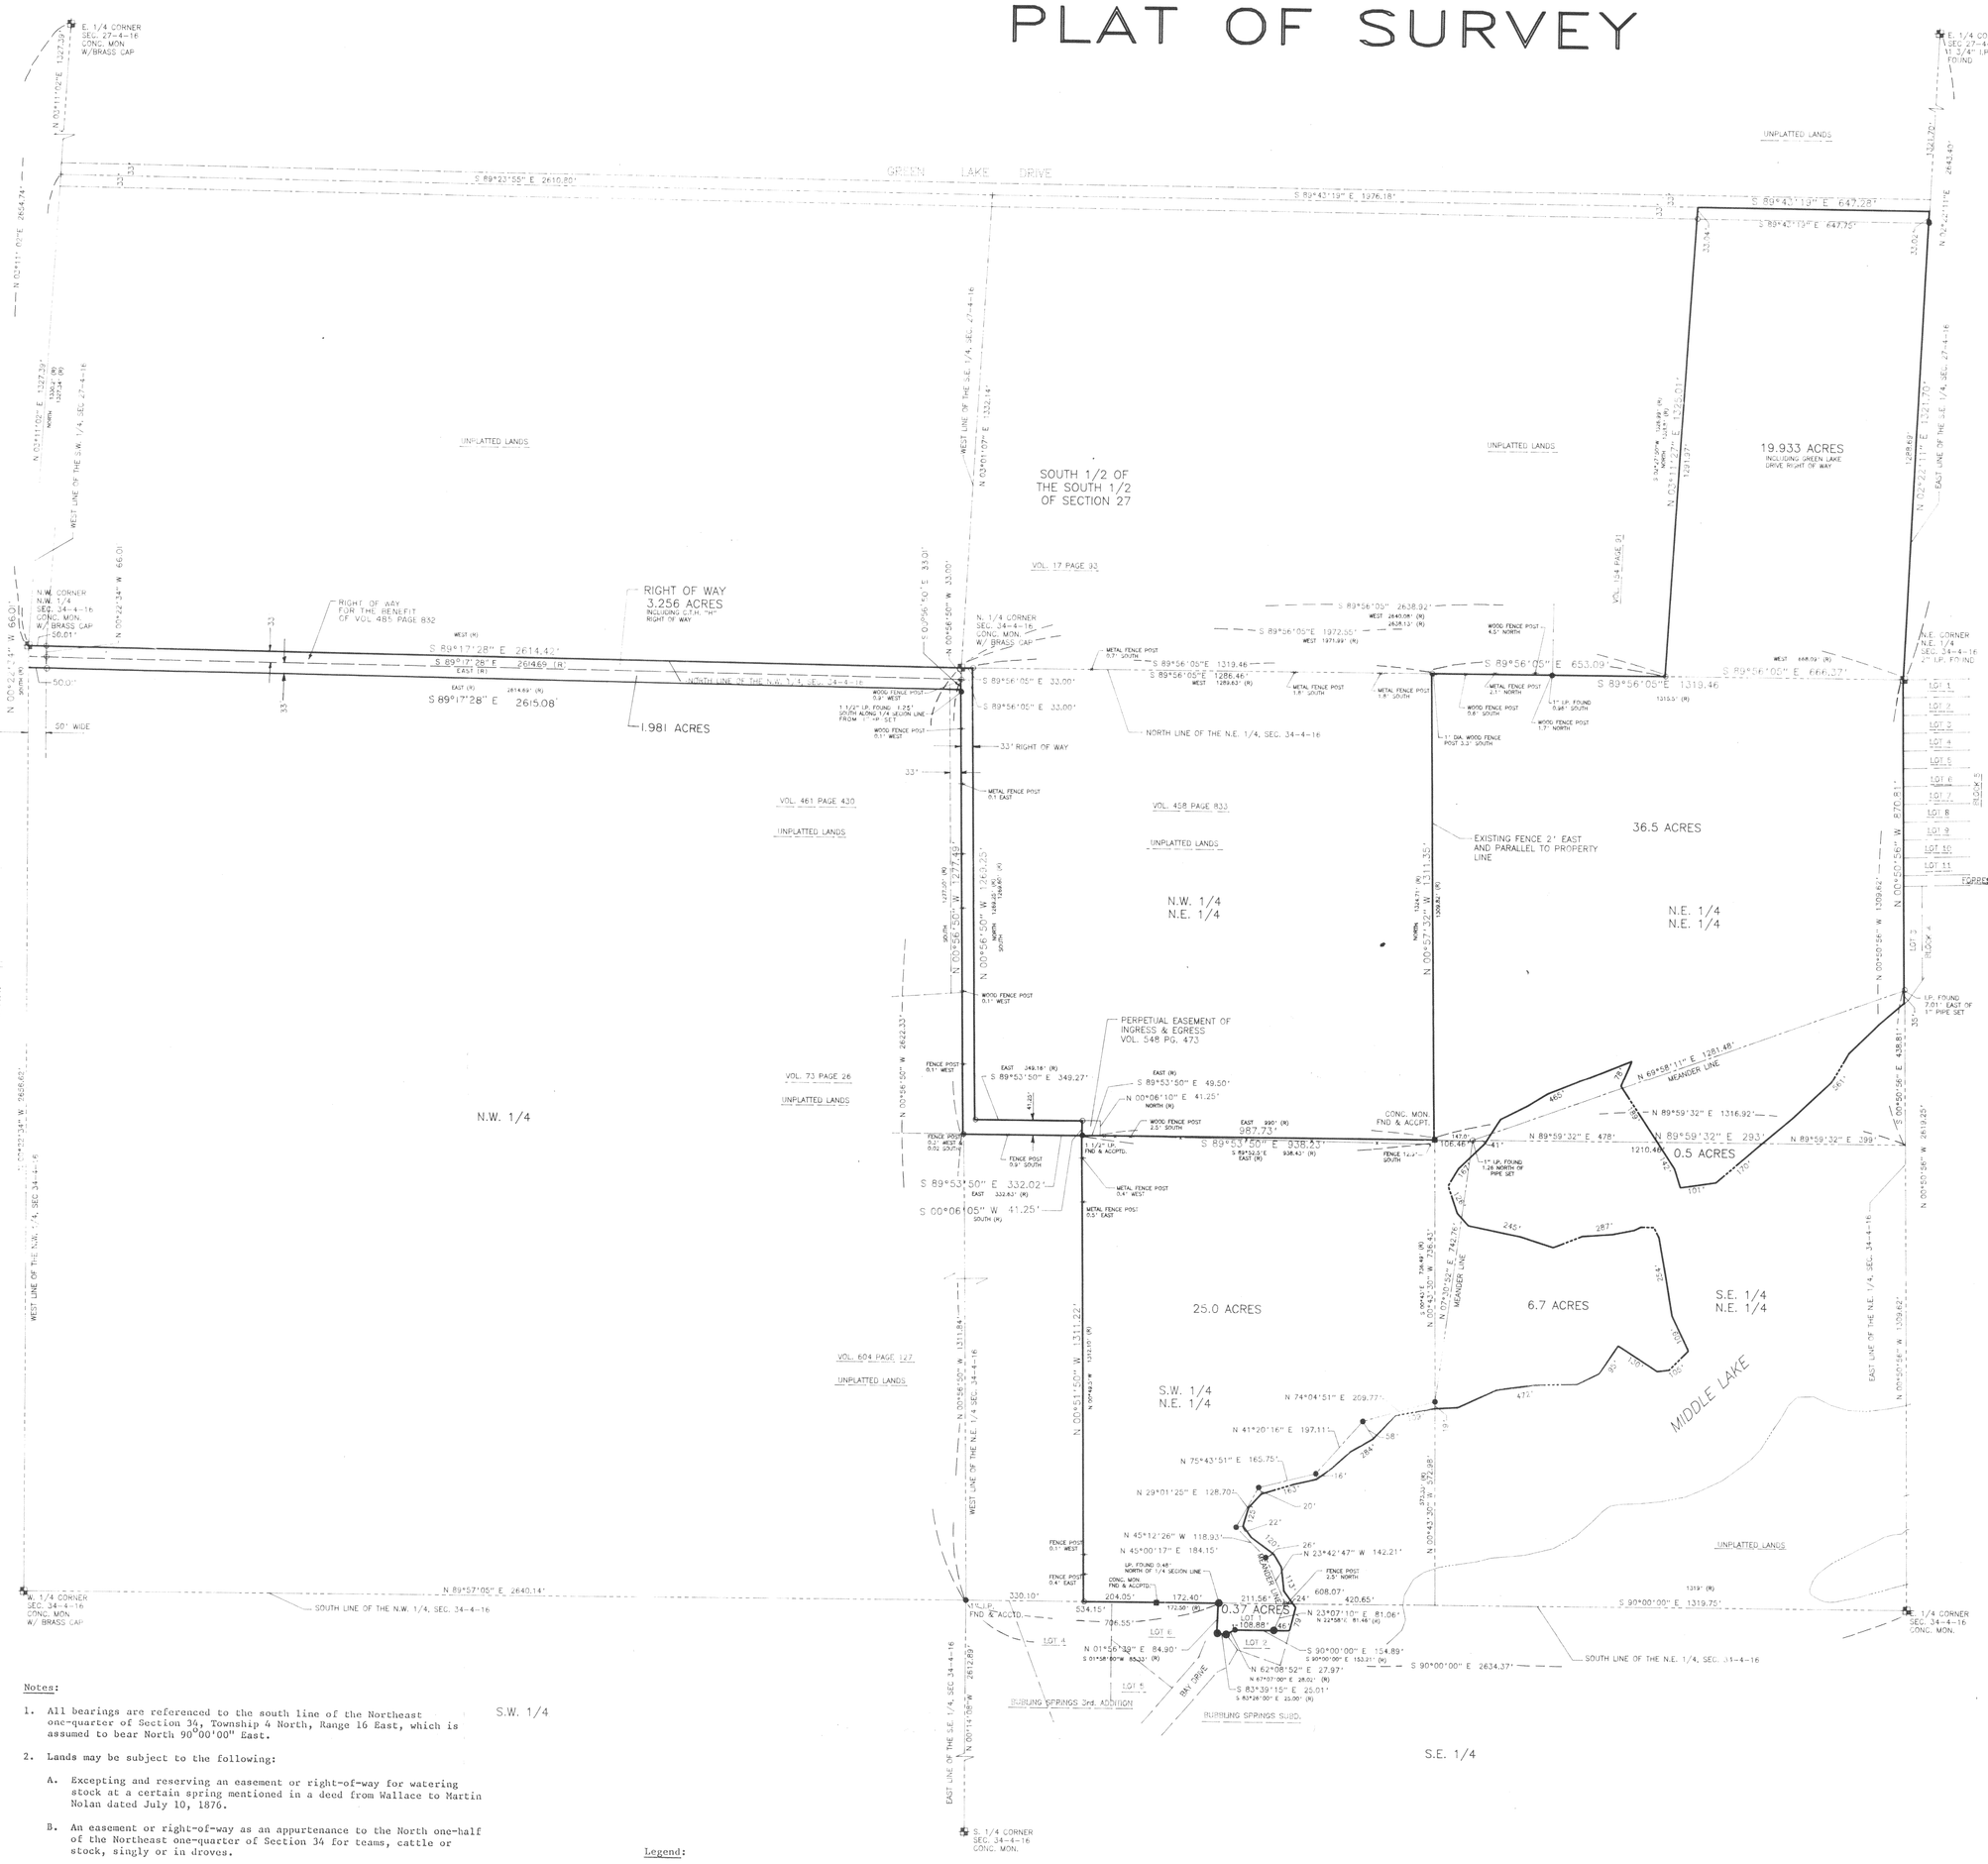
E. 1/4 CORNER SEC. 27-4-16 CONC. MON. W/BRASS CAP
N.W. CORNER N.W. 1/4 SEC. 34-4-16 CONC. MON. W/BRASS CAP
GREEN LAKE DRIVE
S 89°42'19" E 1316.18'
S 89°42'19" E 647.28'
S 89°42'19" E 647.35'
1" I.P. FOUND
0.40'
SUBSKETCH NOT TO SCALE
UNPLATTED LANDS
SOUTH 1/2 OF THE SOUTH 1/2 OF SECTION 27
19.933 ACRES INCLUDING GREEN LAKE DRIVE RIGHT OF WAY
WEST LINE OF THE S.W. 1/4 SEC. 27-4-16
EAST LINE OF THE S.E. 1/4 SEC. 27-4-16
RIGHT OF WAY FOR THE BENEFIT OF VOL. 461 PAGE 832
RIGHT OF WAY 3.256 ACRES INCLUDING C.T.H. "H" RIGHT OF WAY
S 89°17'28" E 2614.43' (M) EAST (R) S 89°17'28" E 2614.69' (R)
50.01'
50' WIDE
1.981 ACRES
N. 1/4 CORNER SEC. 34-4-16 CONC. MON. W/ BRASS CAP
S 89°56'05" E 2638.92' WEST 2645.08' (M) 2639.13' (R)
S 89°56'05" E 1972.00' WEST 1979.84' (M)
S 89°56'05" E 1319.46'
S 89°56'05" E 653.09'
S 89°56'05" E 666.37'
WOOD FENCE POST 4.5' NORTH
N.E. CORNER N.W. 1/4 SEC. 34-4-16 I.P. FOUND
S 89°56'05" E 1286.46' WEST 1293.63' (R)
S 89°56'05" E 33.00'
NORTH LINE OF THE N.E. 1/4, SEC. 34-4-16
METAL FENCE POST 0.9' SOUTH
WOOD FENCE POST 4.5' SOUTH
1" I.P. FOUND 0.04' SOUTH
WOOD FENCE POST 1.3' NORTH
1.1 DIA. WOOD FENCE POST 3.3' SOUTH
33' RIGHT OF WAY
METAL FENCE POST 0.1 EAST
VOL. 17 PAGE 32
VOL. 134 PAGE 21
VOL. 461 PAGE 435
VOL. 428 PAGE 833
UNPLATTED LANDS
N.W. 1/4 N.E. 1/4
36.5 ACRES
EXISTING FENCE 2' EAST AND PARALLEL TO PROPERTY LINE
N.E. 1/4 N.E. 1/4
LOT 1
LOT 2
LOT 3
LOT 4
LOT 5
LOT 6
LOT 7
LOT 8
LOT 9
LOT 10
LOT 11
FOREST ROAD
BLOCK 3
BLOCK 4
BUBBLING SPRINGS 2nd ADDITION
BUBBLING SPRINGS SUBD.
PERPETUAL EASEMENT OF INGRESS & EGRESS VOL. 348 PG. 473
EAST 349.18' (M) S 89°53'50" E 349.27'
S 89°53'50" E 49.50'
N 00°06'10" E 41.25'
NORTH (M)
EAST 987' (M) S 89°53'50" E 987.73'
S 89°53'50" E 938.43' S 89°53'50" E 938.47' (R)
S 89°53'50" E 332.02' EAST (M)
S 00°06'10" W 41.25' SOUTH (M)
FENCE POST 0.5' WEST & 0.6' SOUTH
FENCE POST 0.5' SOUTH
FENCE POST 0.6' WEST
FENCE END 0.4' SOUTH
METAL FENCE POST 0.5' EAST
VOL. 73 PAGE 26
VOL. 604 PAGE 127
N.W. 1/4
S.W. 1/4 N.E. 1/4
25.0 ACRES
6.7 ACRES
S.E. 1/4 N.E. 1/4
0.5 ACRES
0.37 ACRES
MIDDLE LAKE
MEANDER LINE
N 89°59'32" E 478'
N 89°59'32" E 1316.92'
N 89°59'32" E 293'
N 89°59'32" E 1210.48'
N 74°04'51" E 209.77'
N 41°30'16" E 197.11'
N 75°43'51" E 165.75'
N 29°01'25" E 128.70'
N 45°12'26" W 118.93'
N 45°00'17" E 184.15'
N 23°42'47" W 142.21'
N 23°07'10" E 81.06' N 14°08'51" W 81.48' (M)
N 62°08'52" E 27.97' N 67°51'09" E 28.00' (M)
S 83°39'15" E 21.01' S 83°39'09" E 21.00' (R)
S 90°00'00" E 154.89' S 89°59'09" E 153.21' (R)
S 90°00'00" E 2634.37'
SOUTH LINE OF THE N.E. 1/4, SEC. 34-4-16
S.E. 1/4
S.W. 1/4
N 89°57'05" E 2640.14'
SOUTH LINE OF THE N.W. 1/4, SEC. 34-4-16
S. 1/4 CORNER SEC. 34-4-16 CONC. MON. W/ BRASS CAP
S. 1/4 CORNER SEC. 34-4-16 CONC. MON.
EAST LINE OF THE S.E. 1/4, SEC. 34-4-16
WEST LINE OF THE N.W. 1/4, SEC. 34-4-16
WEST LINE OF THE S.W. 1/4, SEC. 27-4-16
N 00°14'08" W 2612.89'
N 00°14'08" W 2612.89' (M)
N 00°14'34" W 2626.47'
N 00°14'34" W 2626.33'
N 00°11'09" E 1327.39' WEST (M) 1326.96' (M)
N 00°11'09" E 1327.39'
N 00°11'09" E 1322.14'
N 00°11'09" E 1322.14' (M)
N 00°11'09" E 2654.74'
