
ABELL
SURVEYING & MAPPING

DELAVAN, WISCONSIN 53115
414-728-6737

NOTE: ROAD LINE ESTABLISHED BY USING DATA FROM JUNE 25, 1935 SURVEY BY LLOYD JENSEN (COUNTY SURVEYOR).

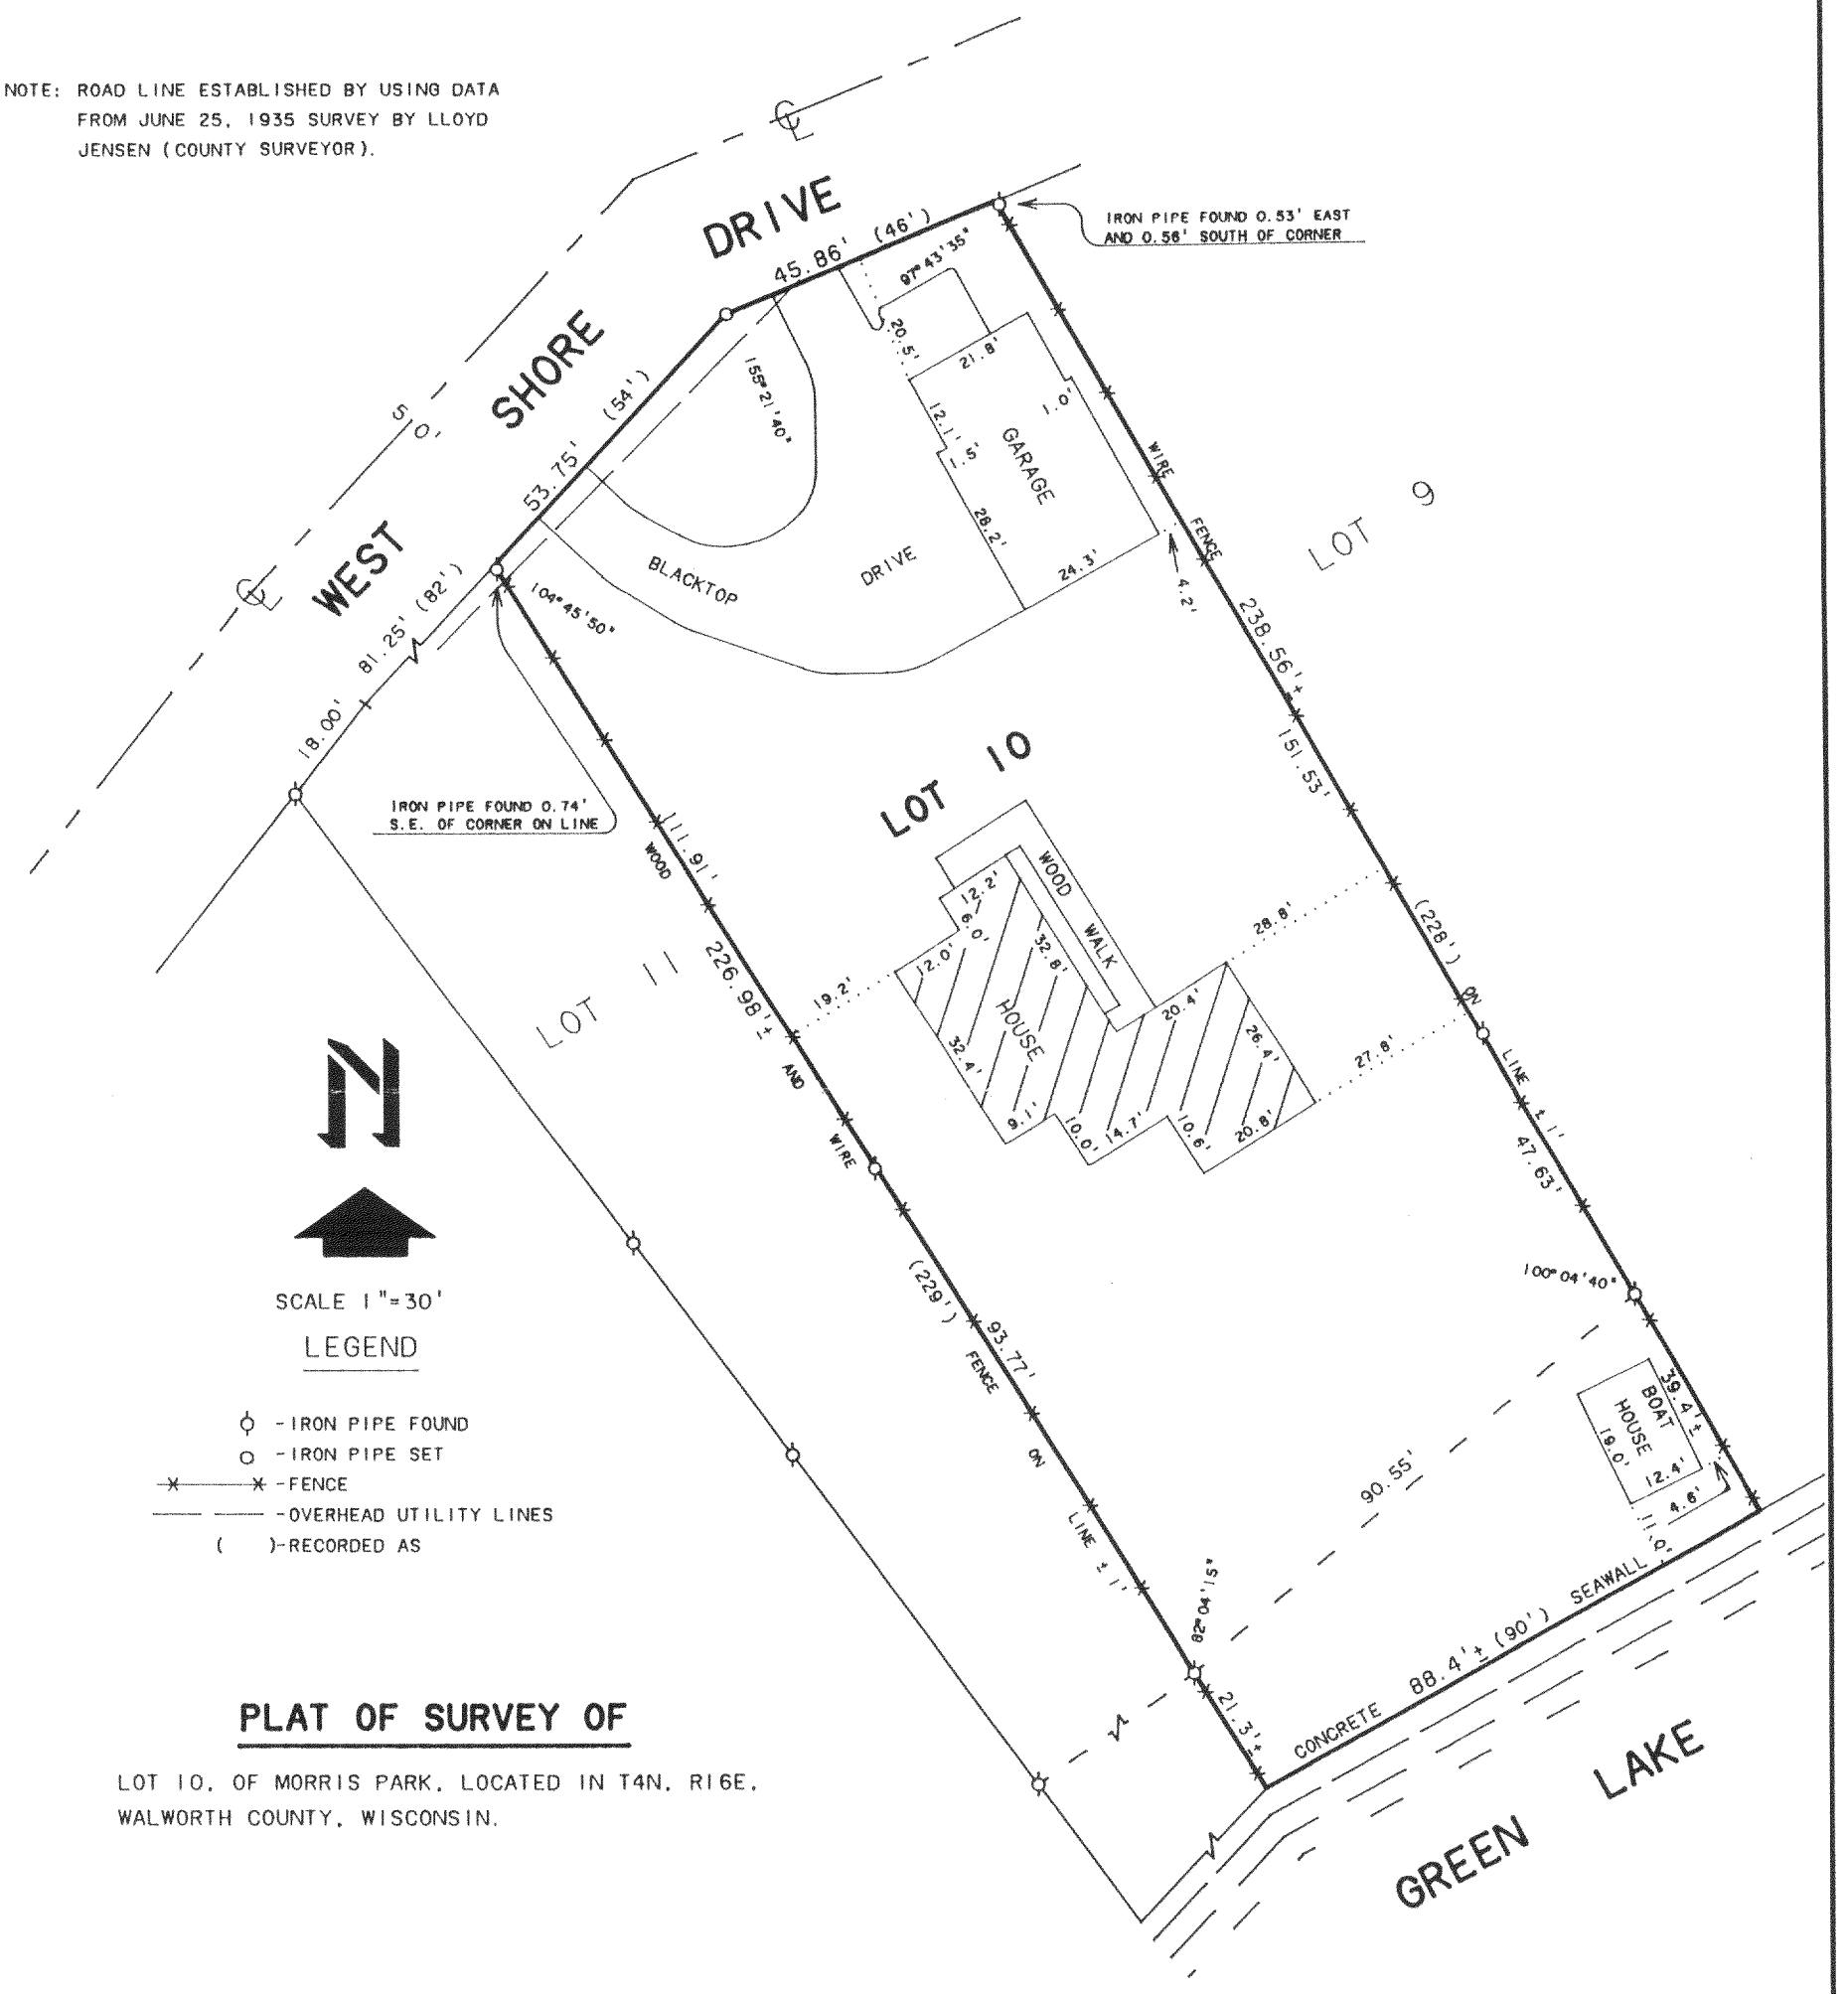

SCALE 1"=30'

LEGEND

- -IRON PIPE FOUND
- -IRON PIPE SET
- -FENCE
- -OVERHEAD UTILITY LINES
- ( )-RECORDED AS

PLAT OF SURVEY OF

LOT 10, OF MORRIS PARK, LOCATED IN T4N, R16E, WALWORTH COUNTY, WISCONSIN.

ORDERED BY: COLONY REALTY
16 E. WALWORTH ST.
ELKHORN, WI. 53121

RECEIVED
FEB 19 1992

I HEREBY CERTIFY THAT I HAVE SURVEYED THE ABOVE DESCRIBED PROPERTY AND THAT THE ABOVE MAP IS A TRUE REPRESENTATION THEREOF AND SHOWS THE SIZE AND LOCATION OF THE PROPERTY, ITS EXTERIOR BOUNDARIES, THE LOCATION OF ALL VISIBLE STRUCTURES AND DIMENSIONS OF ALL PRINCIPAL BUILDINGS THEREON, BOUNDARY FENCES, APPARENT EASEMENTS, ROADWAYS AND VISIBLE ENCROACHMENTS, IF ANY, TO THE BEST OF MY KNOWLEDGE AND BELIEF.

THIS SURVEY IS MADE FOR THE USE OF THE PRESENT OWNERS OF THE PROPERTY, AND ALSO THOSE WHO PURCHASE, MORTGAGE, OR GUARANTEE THE TITLE THERETO WITHIN ONE (1) YEAR FROM DATE HEREOF.

David F. Abell

DAVID F. ABELL
WISCONSIN REGISTERED LAND SURVEYOR, S-1596

October 23, 1991

DATE JOB NUMBER - 91215

NOTE: THIS IS NOT A CERTIFIED COPY UNLESS SEALED.

416-787

HMP-7