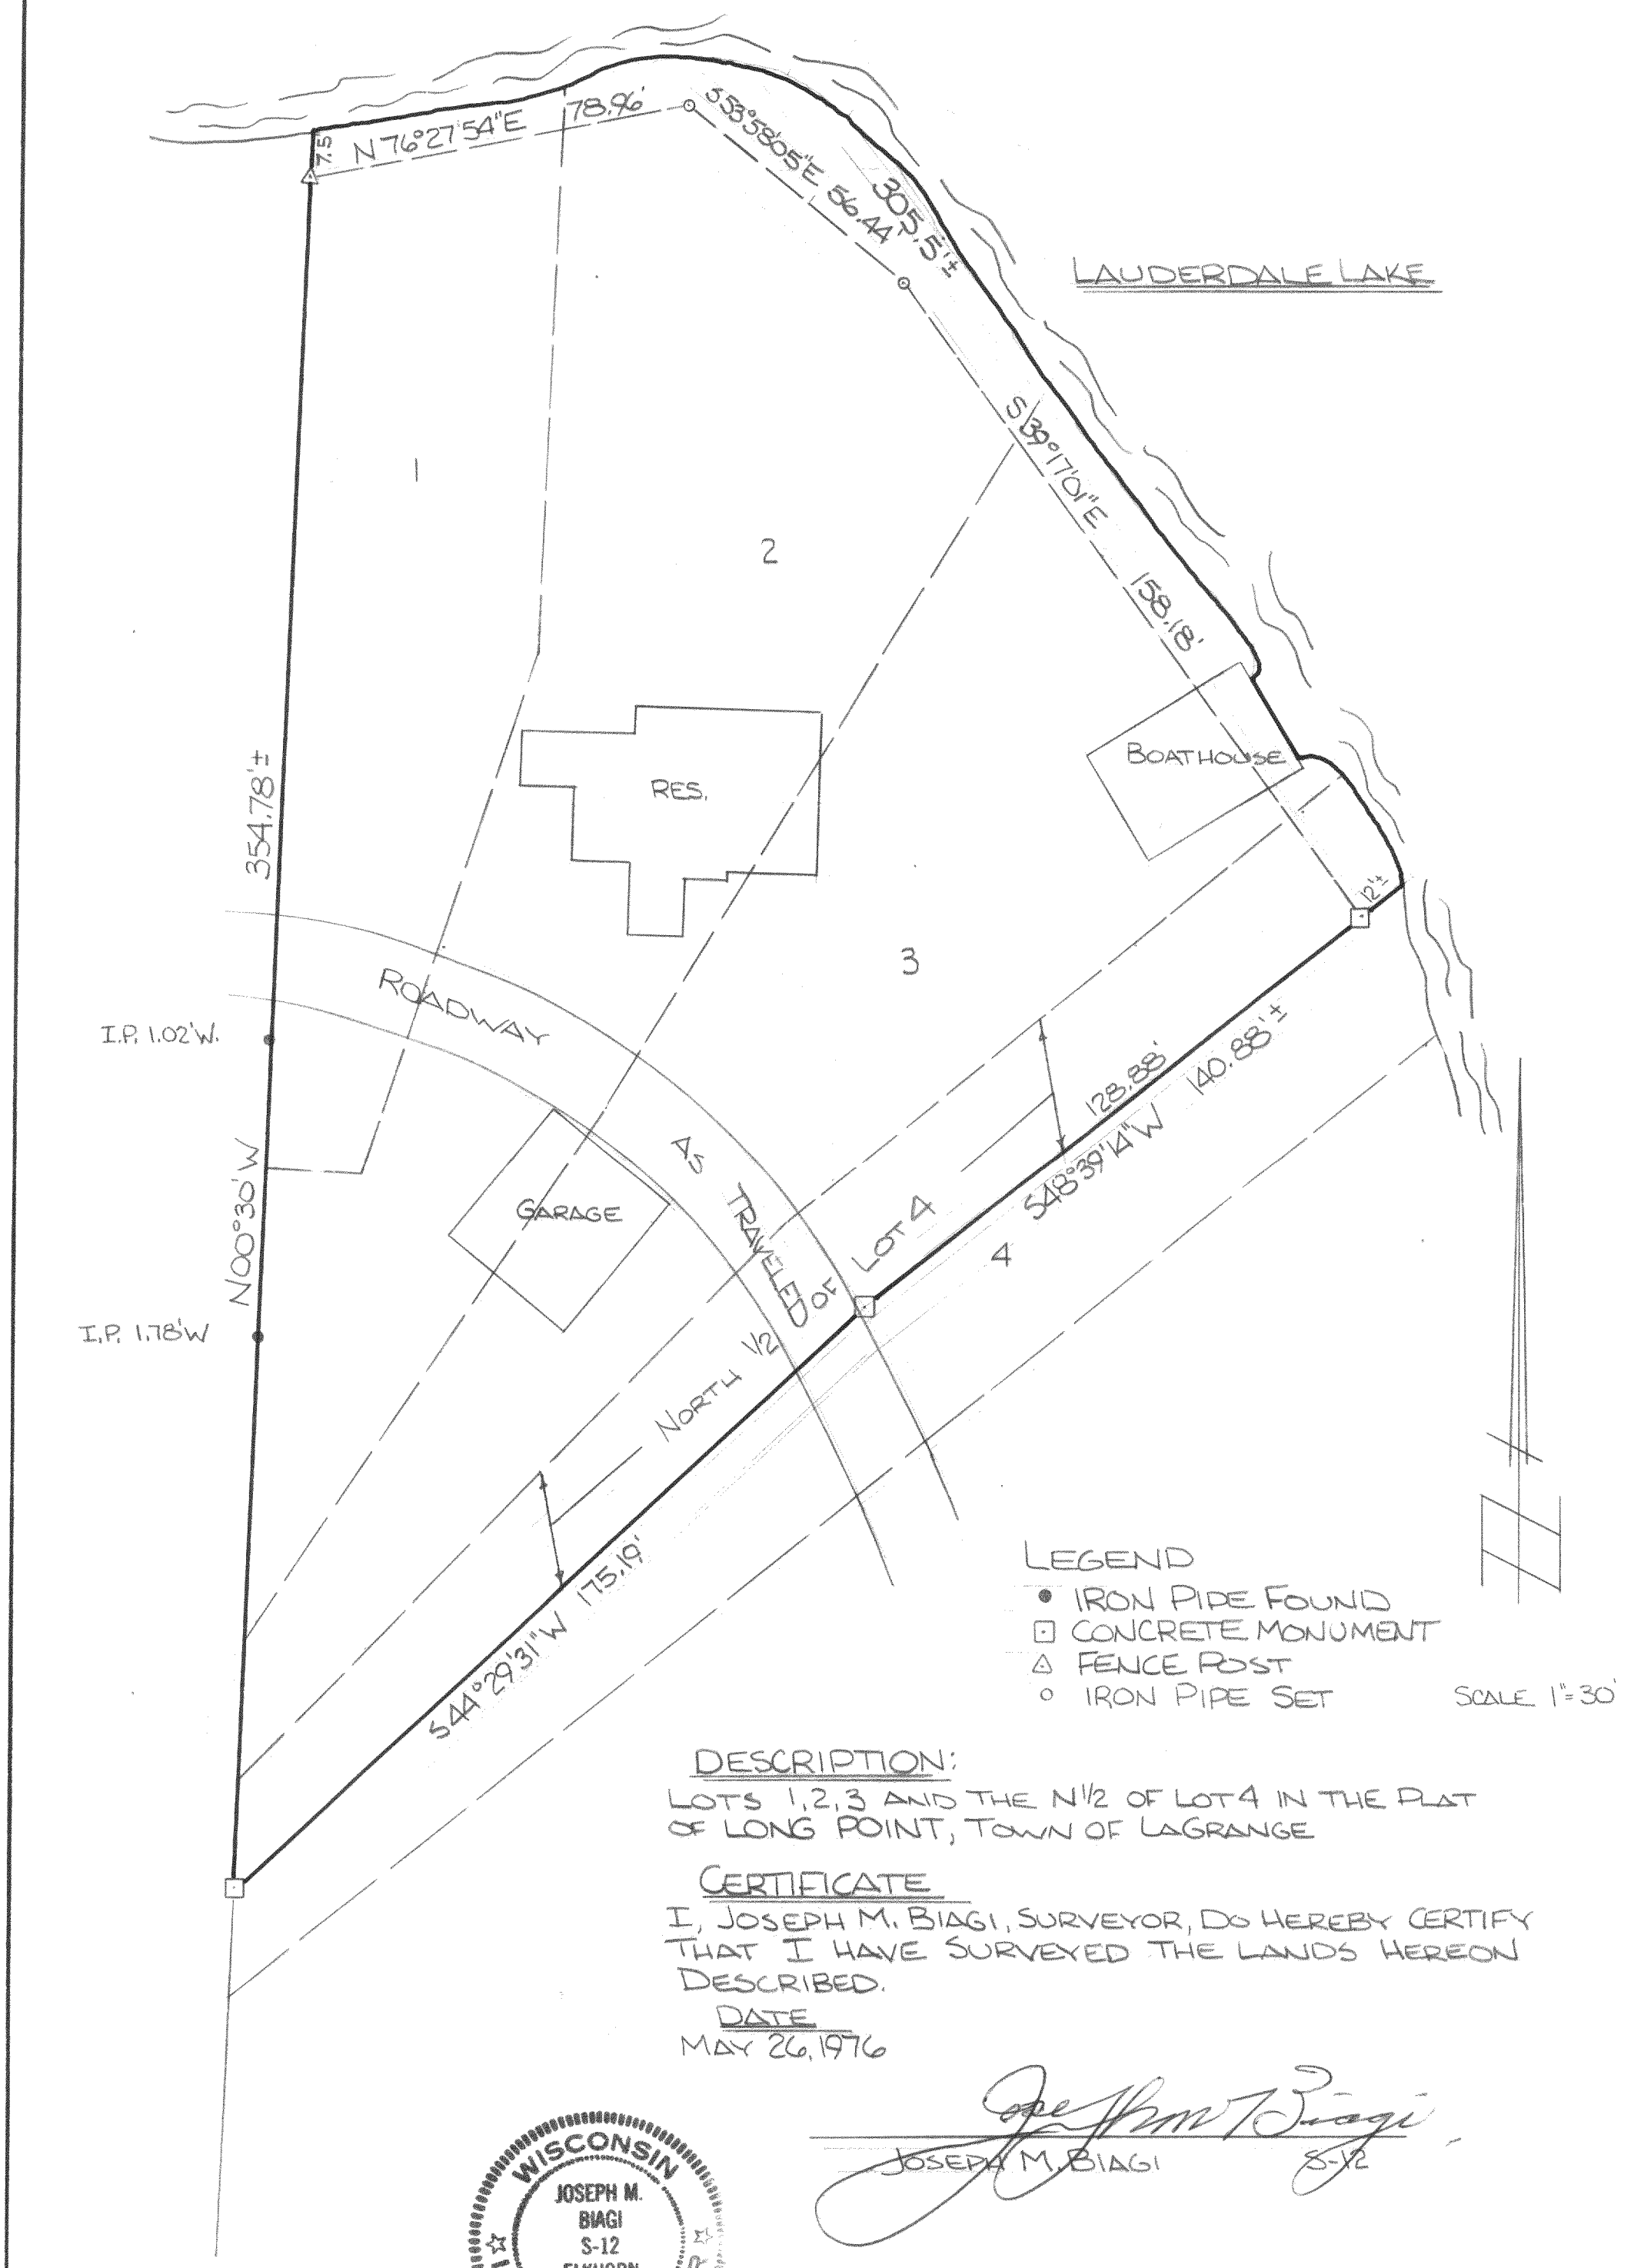


LEGEND

- ● IRON PIPE FOUND
- ⊡ CONCRETE MONUMENT
- △ FENCE POST
- ○ IRON PIPE SET

SCALE 1"=30'

DESCRIPTION:

LOTS 1,2,3 AND THE N1/2 OF LOT 4 IN THE PLAT OF LONG POINT, TOWN OF LAGRANGE

CERTIFICATE

I, JOSEPH M. BIAGI, SURVEYOR, DO HEREBY CERTIFY THAT I HAVE SURVEYED THE LANDS HEREON DESCRIBED.

DATE

MAY 26, 1976

Joseph M. Biagi

JOSEPH M. BIAGI S-12

WISCONSIN JOSEPH M. BIAGI S-12 ELKHORN WIS. LAND SURVEYOR

HLPN-1

4/6-91B