ABERNATHY and ASSOCIATES
Kenneth B. Abernathy Jr.
Wisconsin Registered Land Surveyor S-1594

Rt. 3, Box 273
Elkhorn, Wisconsin 53121
Phone: (414) 723-4260 (office)
(414) 723-4813 (residence)

PLAT OF SURVEY

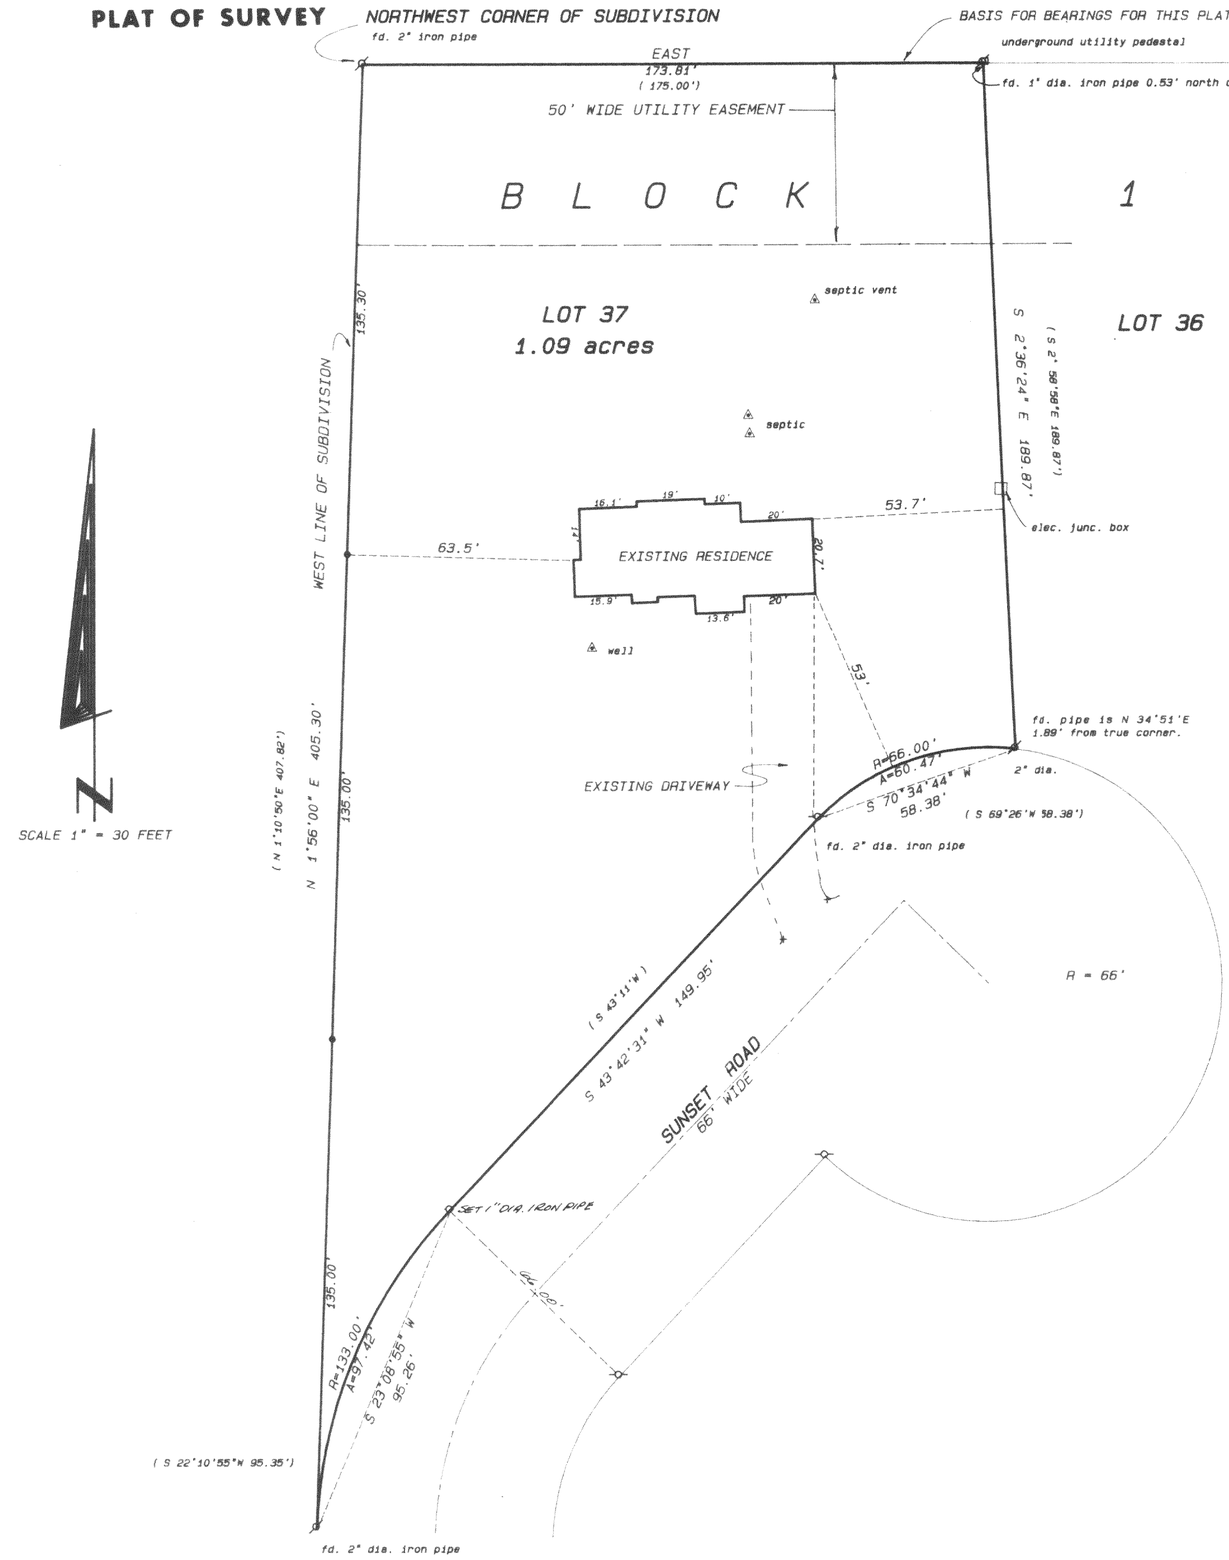

SCALE 1" = 30 FEET

LOT 37 OF BLOCK 1 OF KETTLE MORRAINE ESTATES SUBDIVISION LOCATED IN THE NORTHWEST 1/4 OF SECTION 4, TOWN 4 NORTH, RANGE 17 EAST, WALWORTH COUNTY, WISCONSIN.

OWNER: JERRY HEESZEL
N. 9661 SUNSET
EAST TROY, WIS. 53120

DETAIL OF RESIDENCE
SCALE 1" = 10 FEET

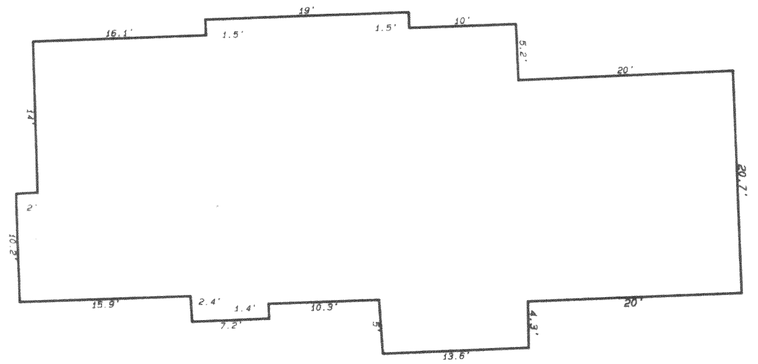

Legend

- FOUND IRON PIPE
- FOUND IRON ROD
- FOUND BRASS CAPPED MONUMENT
- FOUND CONCRETE MONUMENT
- \+ CHISEL CUT IN CONCRETE
- SET IRON ROD, 24" LONG, WEIGHING 1.5 LBS./LINEAL FT., 3/4" DIA.
- SET IRON ROD, 30" LONG, WEIGHING 4.5 LBS./LINEAL FT., 1-11/16" DIA.
- (xx) RECORDED AS DIMENSION
- —x—x— EXISTING FENCE

RECEIVED
JUN 2 1 1993

SCALE: 1" = 30 FEET

"I hereby certify that I have surveyed the above described property and that the above map is a true representation thereof and shows the size and location of the property, its exterior boundaries, the location of all visible structures and dimensions of all principal buildings thereon, boundary fences, apparent easements, roadways and visible encroachments, if any."

"This survey is made for the use of the present owners of the property, and also those who purchase, mortgage, or guarantee the title thereto within one year from date hereof."

KENNETH B. ABERNATHY, JR.
WISCONSIN REGISTERED LAND SURVEYOR,
S-1594

Date: 3/5/93 Job No. 93.305

4K-37

417-357