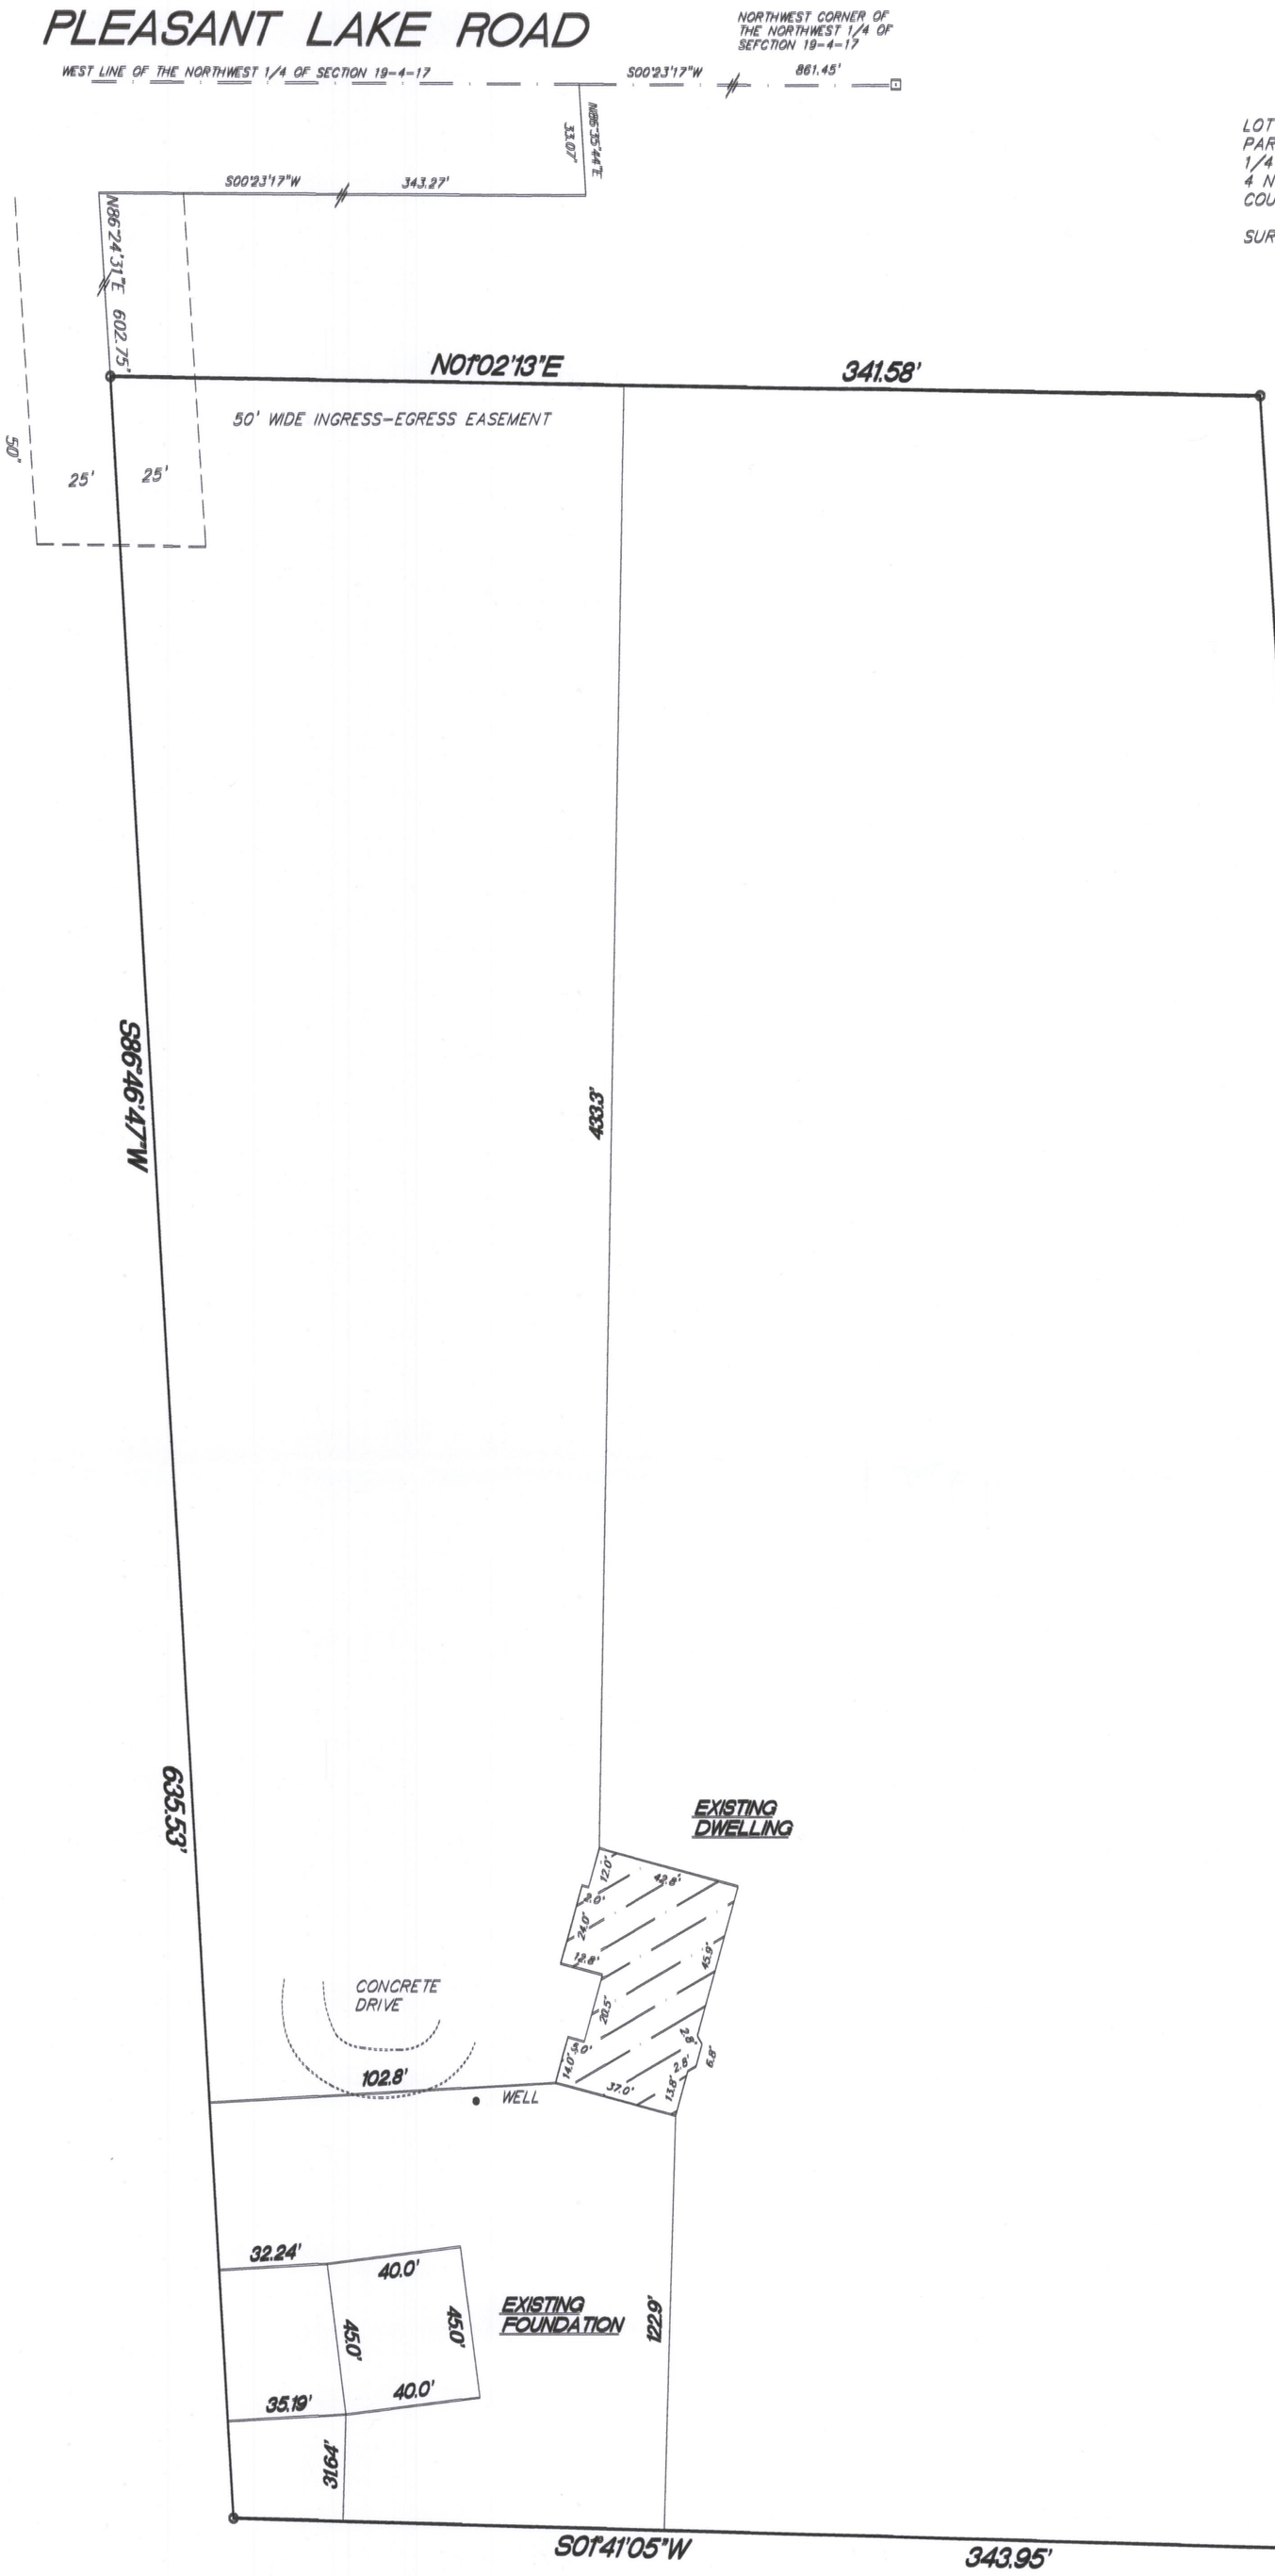


PLAT OF SURVEY

LOT 3, CERTIFIED SURVEY MAP NO. 3584, BEING A PART OF THE NORTHWEST 1/4 AND THE SOUTHWEST 1/4 OF THE NORTHWEST 1/4 OF SECTION 19, TOWN 4 NORTH, RANGE 17 EAST, TOWN OF TROY, WALWORTH COUNTY, WISCONSIN.

SURVEYED FOR: PATRICK RAJKOVACZ

SCALE 1"=40'

○ FOUND 1" IRON PIPE

⊡ FOUND CONC. MON.

RECEIVED
JAN 14 2019
By Jan

"I hereby certify that I have surveyed the above property and that the above map is a true representation thereof and shows the size and location of the property exterior boundaries, the location of all visible structures and dimensions of all principal buildings thereon, boundary fences, apparent easements, roadways and encroachments if any."
"This survey is made for the use of the present owners of the property, and also those who purchase, mortgage or guarantee the title thereto within one year from date hereof."

REV. 5/28/19 REV. 11/28/18
REV. 11/1/07
5/17/05
DATE

TEP
FIELD WORK BY

TEP
DRAWN BY

05074
JOB NUMBER

KETTLE MORAINE SURVEYING INC.
P.O. Box 357
Eagle WI. 53119
(262)594-3484

THIS IS NOT AN ORIGINAL SURVEY UNLESS THE SEAL IS RED

WISCONSIN
TERRANCE E. PISAREK
S-1930
EAGLE, WISCONSIN
LAND SURVEYOR

LA3584-3 417-1080