


N

o = IRON PIPE

SWIFT
LAKE

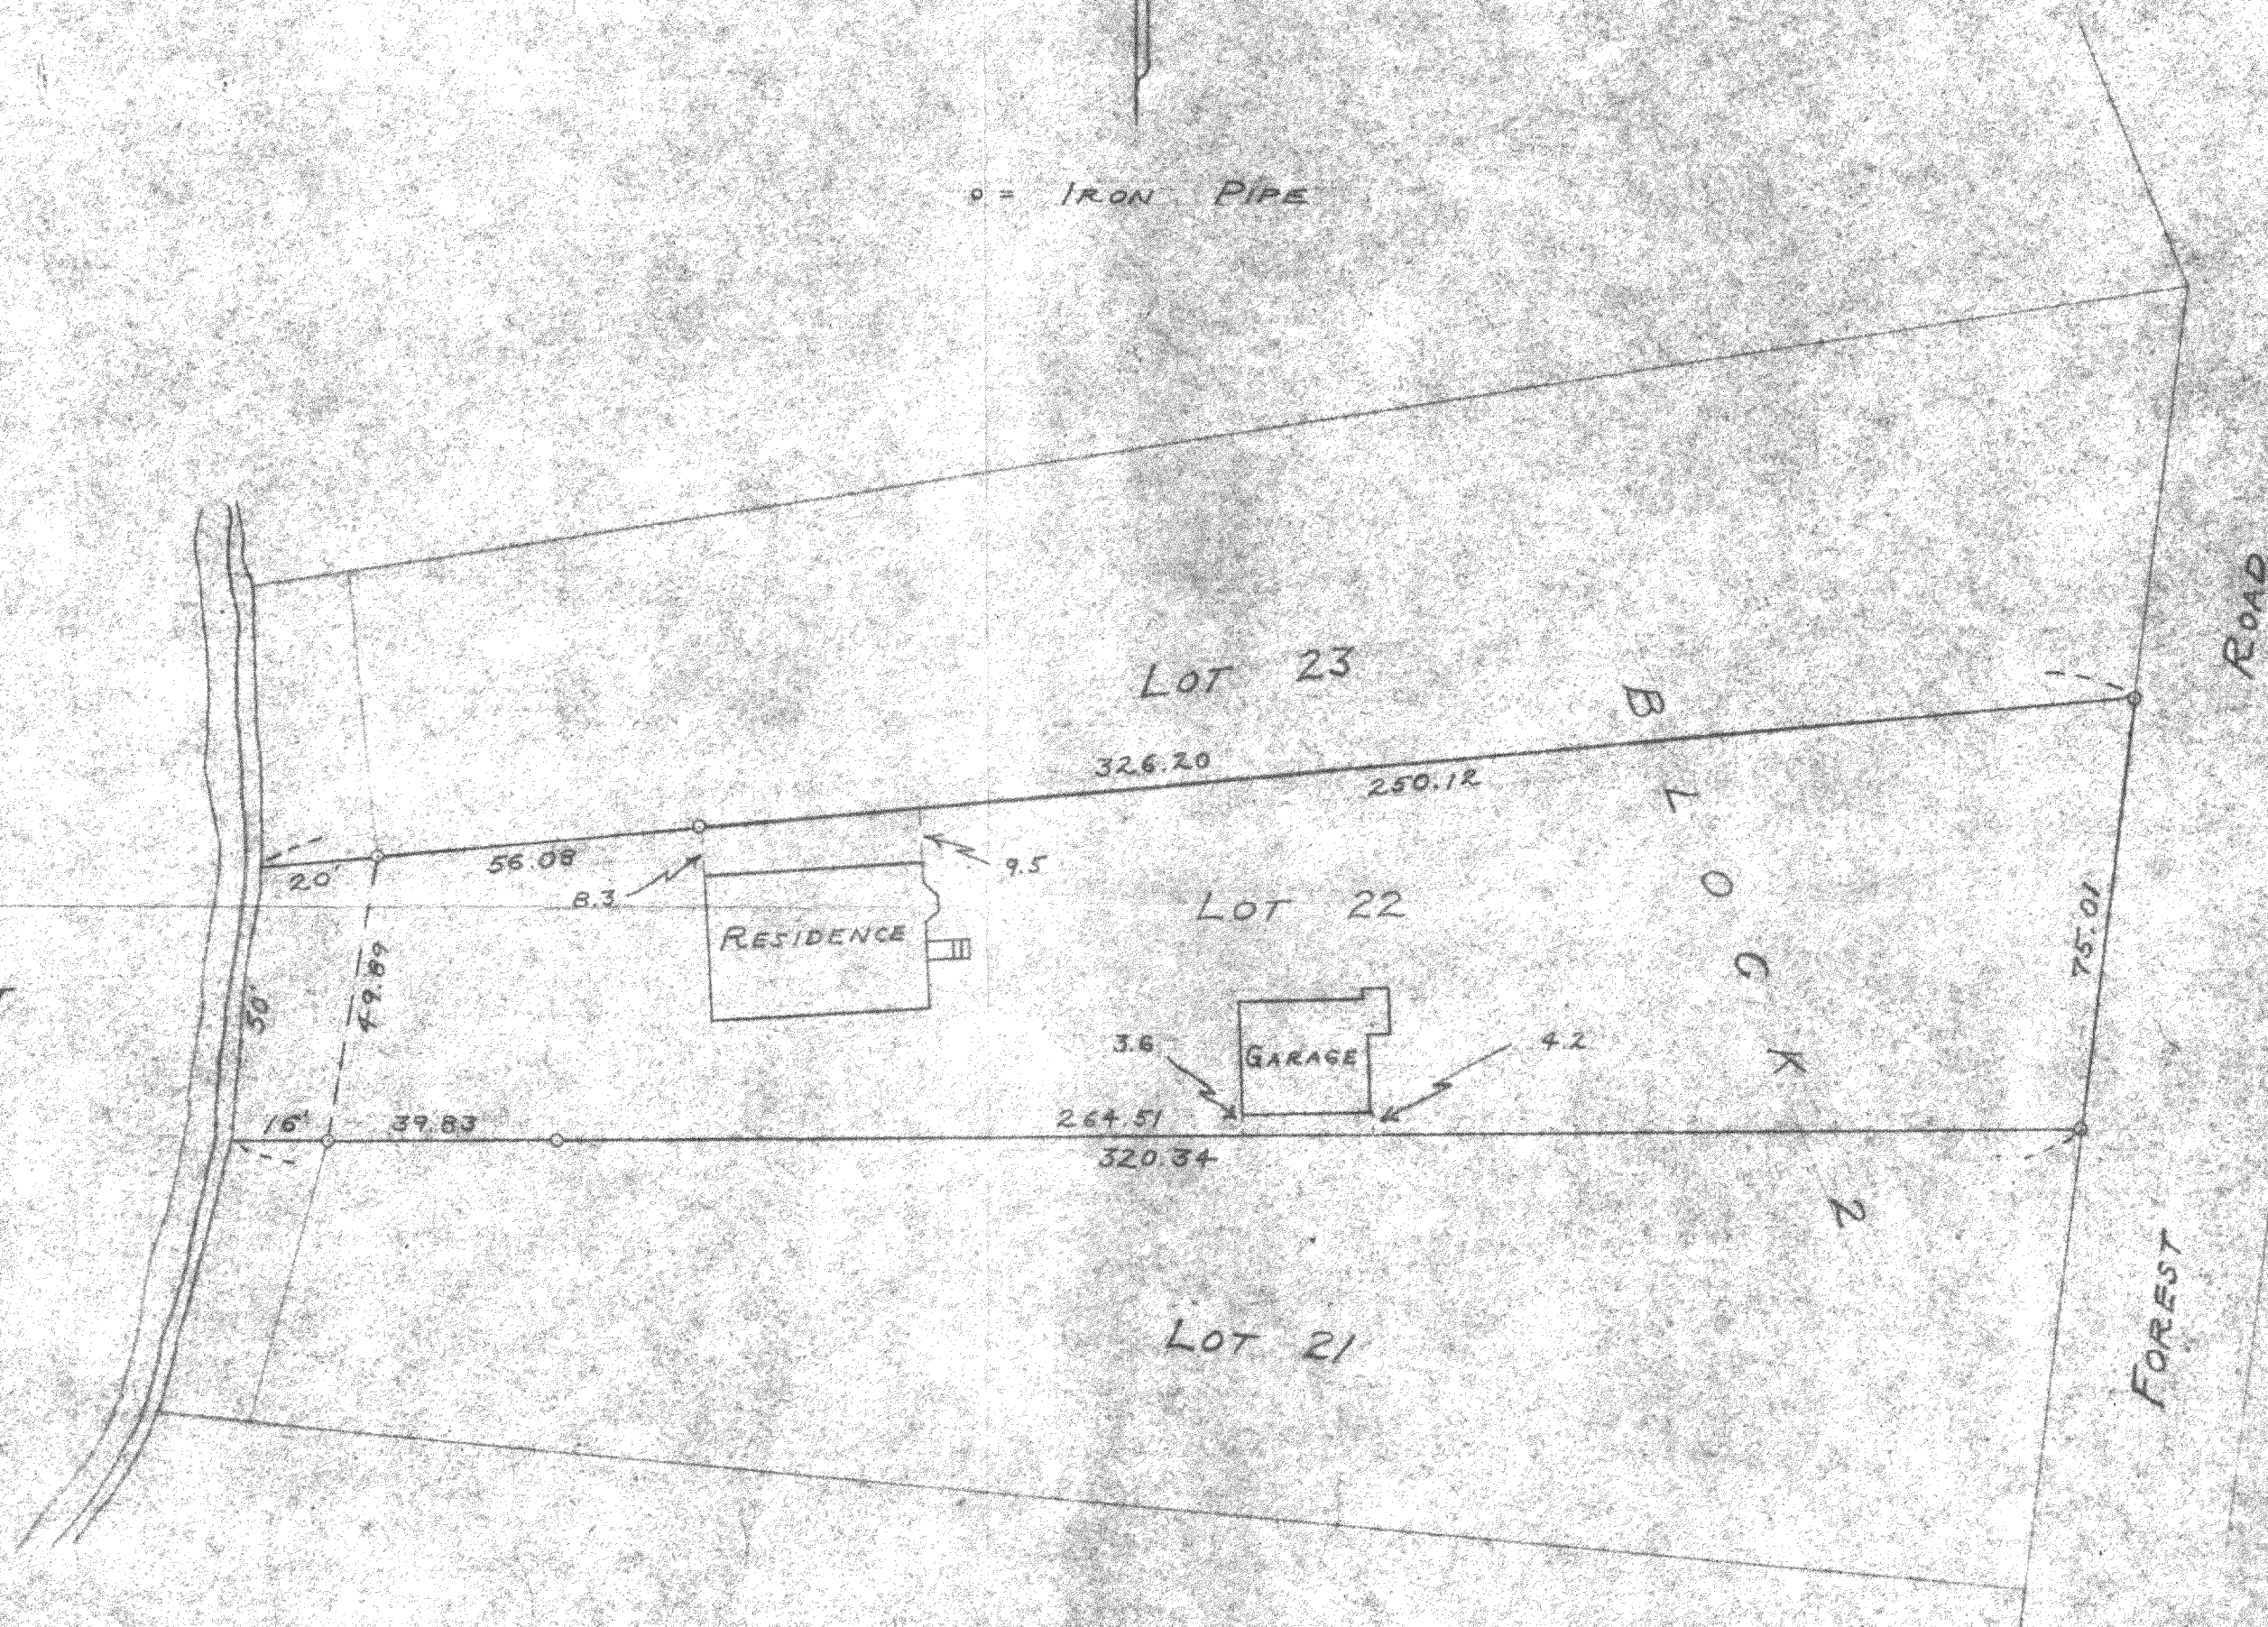

PLAT OF SURVEY
OF

LOT 22 BLOCK 2 OF
SWIFT LAKE SUBDIVISION
LOCATED IN SECTION 8,
T 4 N R 1 E - TROY
WALWORTH COUNTY, WISCONSIN

Clayton L. Jensen
SURVEYOR

SCALE 1" = 30'

DATE Feb 27 1959

LSL-21