
PLAT OF SURVEY

LOT 21, BOOTH LAKE HEIGHT SUBDIVISION, LOCATED IN PART OF SECTIONS 13 AND 24,
TOWNSHIP 4 NORTH, RANGE 17 EAST, TOWN OF TROY, WALWORTH COUNTY, WISCONSIN.

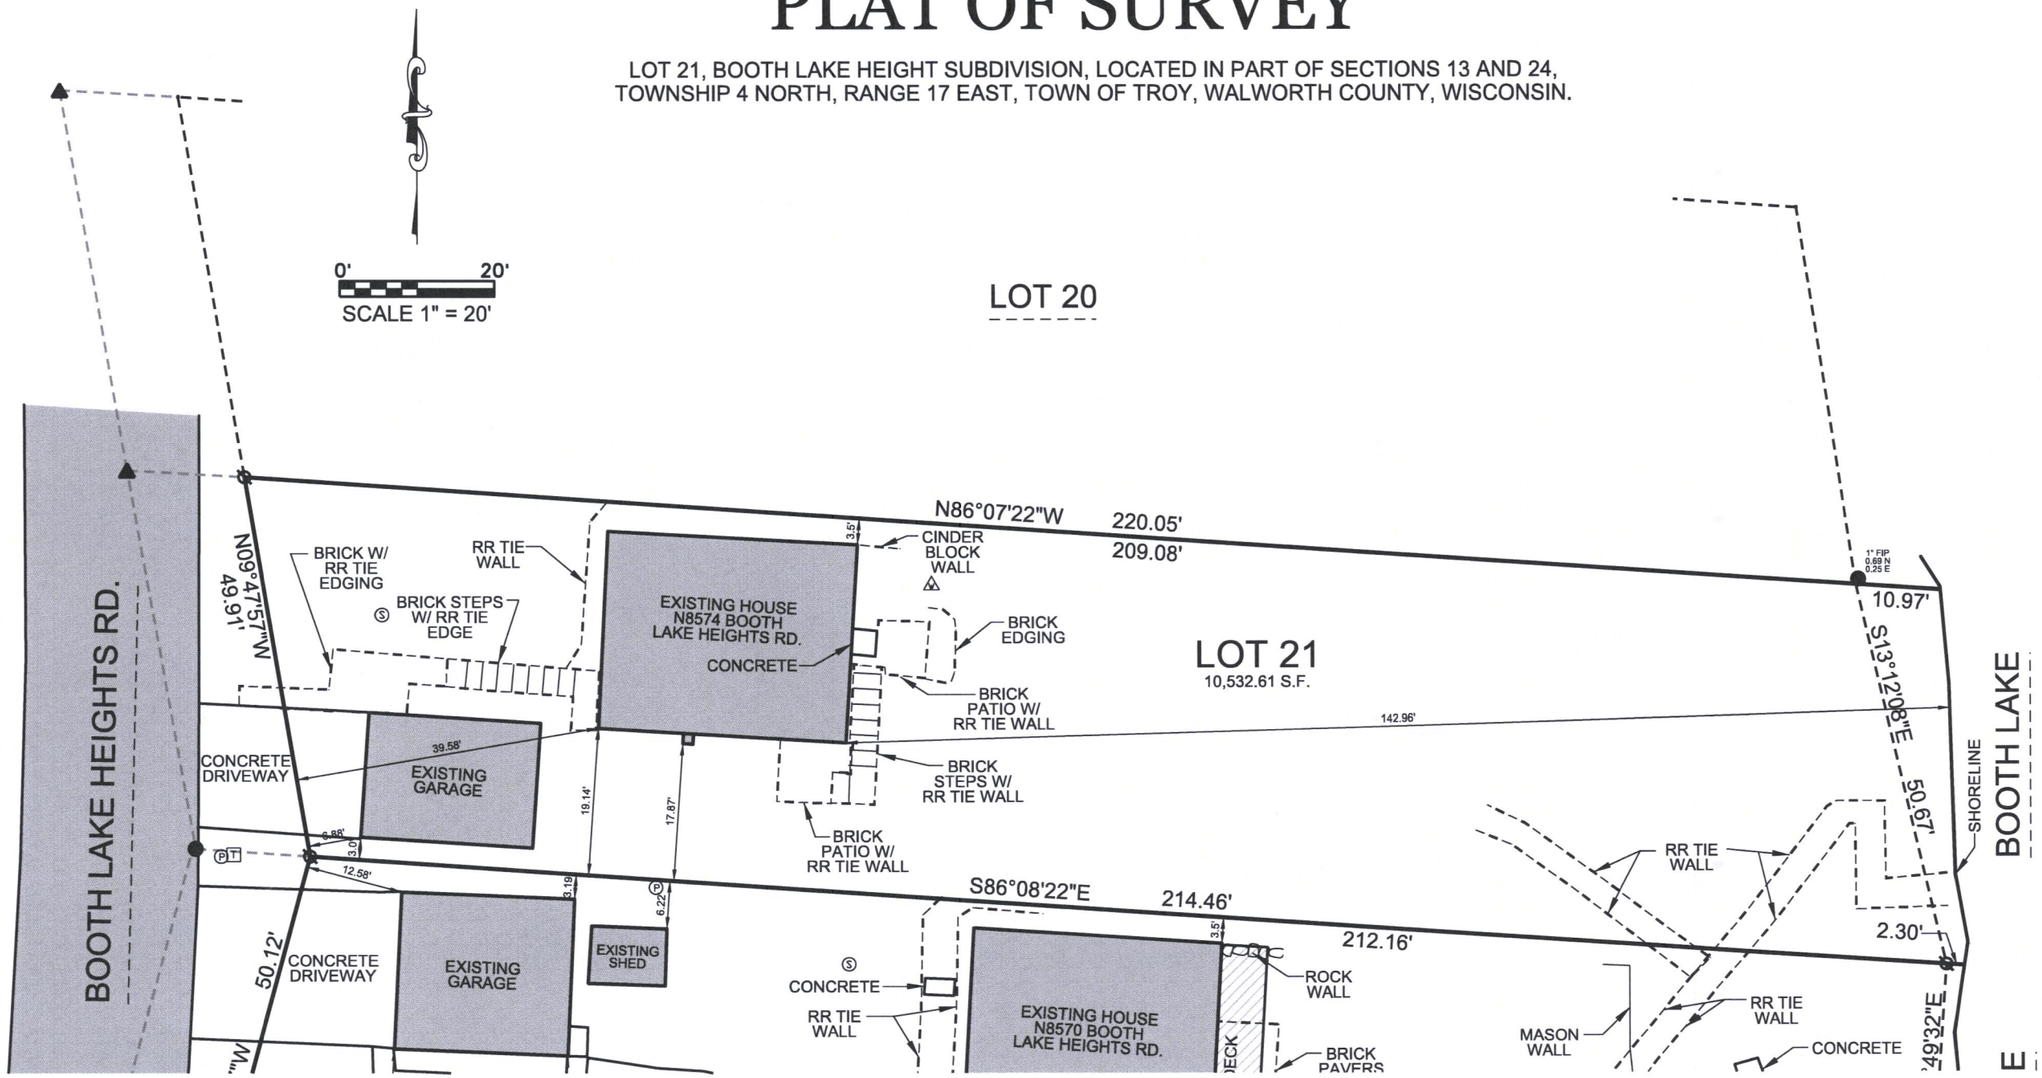

LEGEND:

(100.00')	RECORDED DISTANCE
100.00'	MEASURED DISTANCE
●	1" FOUND IRON PIPE, UNLESS NOTED
Ø	¾" x 18" IRON PIPE SET, 1.13 lbs./L.F.
W	WELL
ST	SEPTIC TANK
S	SEPTIC VENT
LP	LIGHT POLE
E	ELECTRIC TRANSFORMER
E	ELECTRIC PEDESTAL
T	TELEPHONE PEDESTAL
T	CABLE TV PEDESTAL

RECEIVED
OCT - 1 2020
By BMC

WISCONSIN
Michael A. Greeson
S-2770
East Troy
Wis
LAND SURVEYOR

THIS SURVEY IS MADE FOR THE USE OF THE PRESENT OWNERS OF THE PROPERTY, AND ALSO THOSE WHO PURCHASE, MORTGAGE OR GUARANTEE TITLE TO WITHIN ONE (1) YEAR FROM DATE HERETO.

I, MICHAEL A. GREESON P.L.S. #2770, HEREBY CERTIFY THAT THIS SURVEY WAS MADE IN ACCORDANCE WITH THE MINIMUM STANDARDS FOR PROPERTY SURVEYS (CHAPTER A-E 7) FOR THE STATE OF WISCONSIN AND HAS BEEN PREPARED UNDER MY DIRECTION AND CONTROL AND IS CORRECT TO THE BEST OF MY KNOWLEDGE AND BELIEF.

SURVEY MADE FOR:
NYFFELER RENTALS LLC
N8481 DIVISION RD
EAST TROY WI, 53120

DATE	ITEM
06/25/2020	ORIGINAL SURVEY

V²G
SURVEYING, LLC
123 WOLF RUN - SUITE 4
MUKWONAGO, WI 53149
(262) 378-5097

FILE NAME: V:*. V2G PROJECTS??-088 Paul Nyffeler 2 Surveys N8570 & N8574 Booth Lake Heights Rd

PLOT DATE: 06/25/2020

V2G JOB#: 2020-088

LBL-19

417-1120