
LAND-MARK SURVEYING
Mark L. Miritz
Wisconsin Professional Land Surveyor S-2582

N9330 Knuteson Drive
Whitewater, WI 53190
Phone:(262)949-1239
MARKMIRITZ@
LAND-MARKSURVEYING.COM

PLAT OF SURVEY

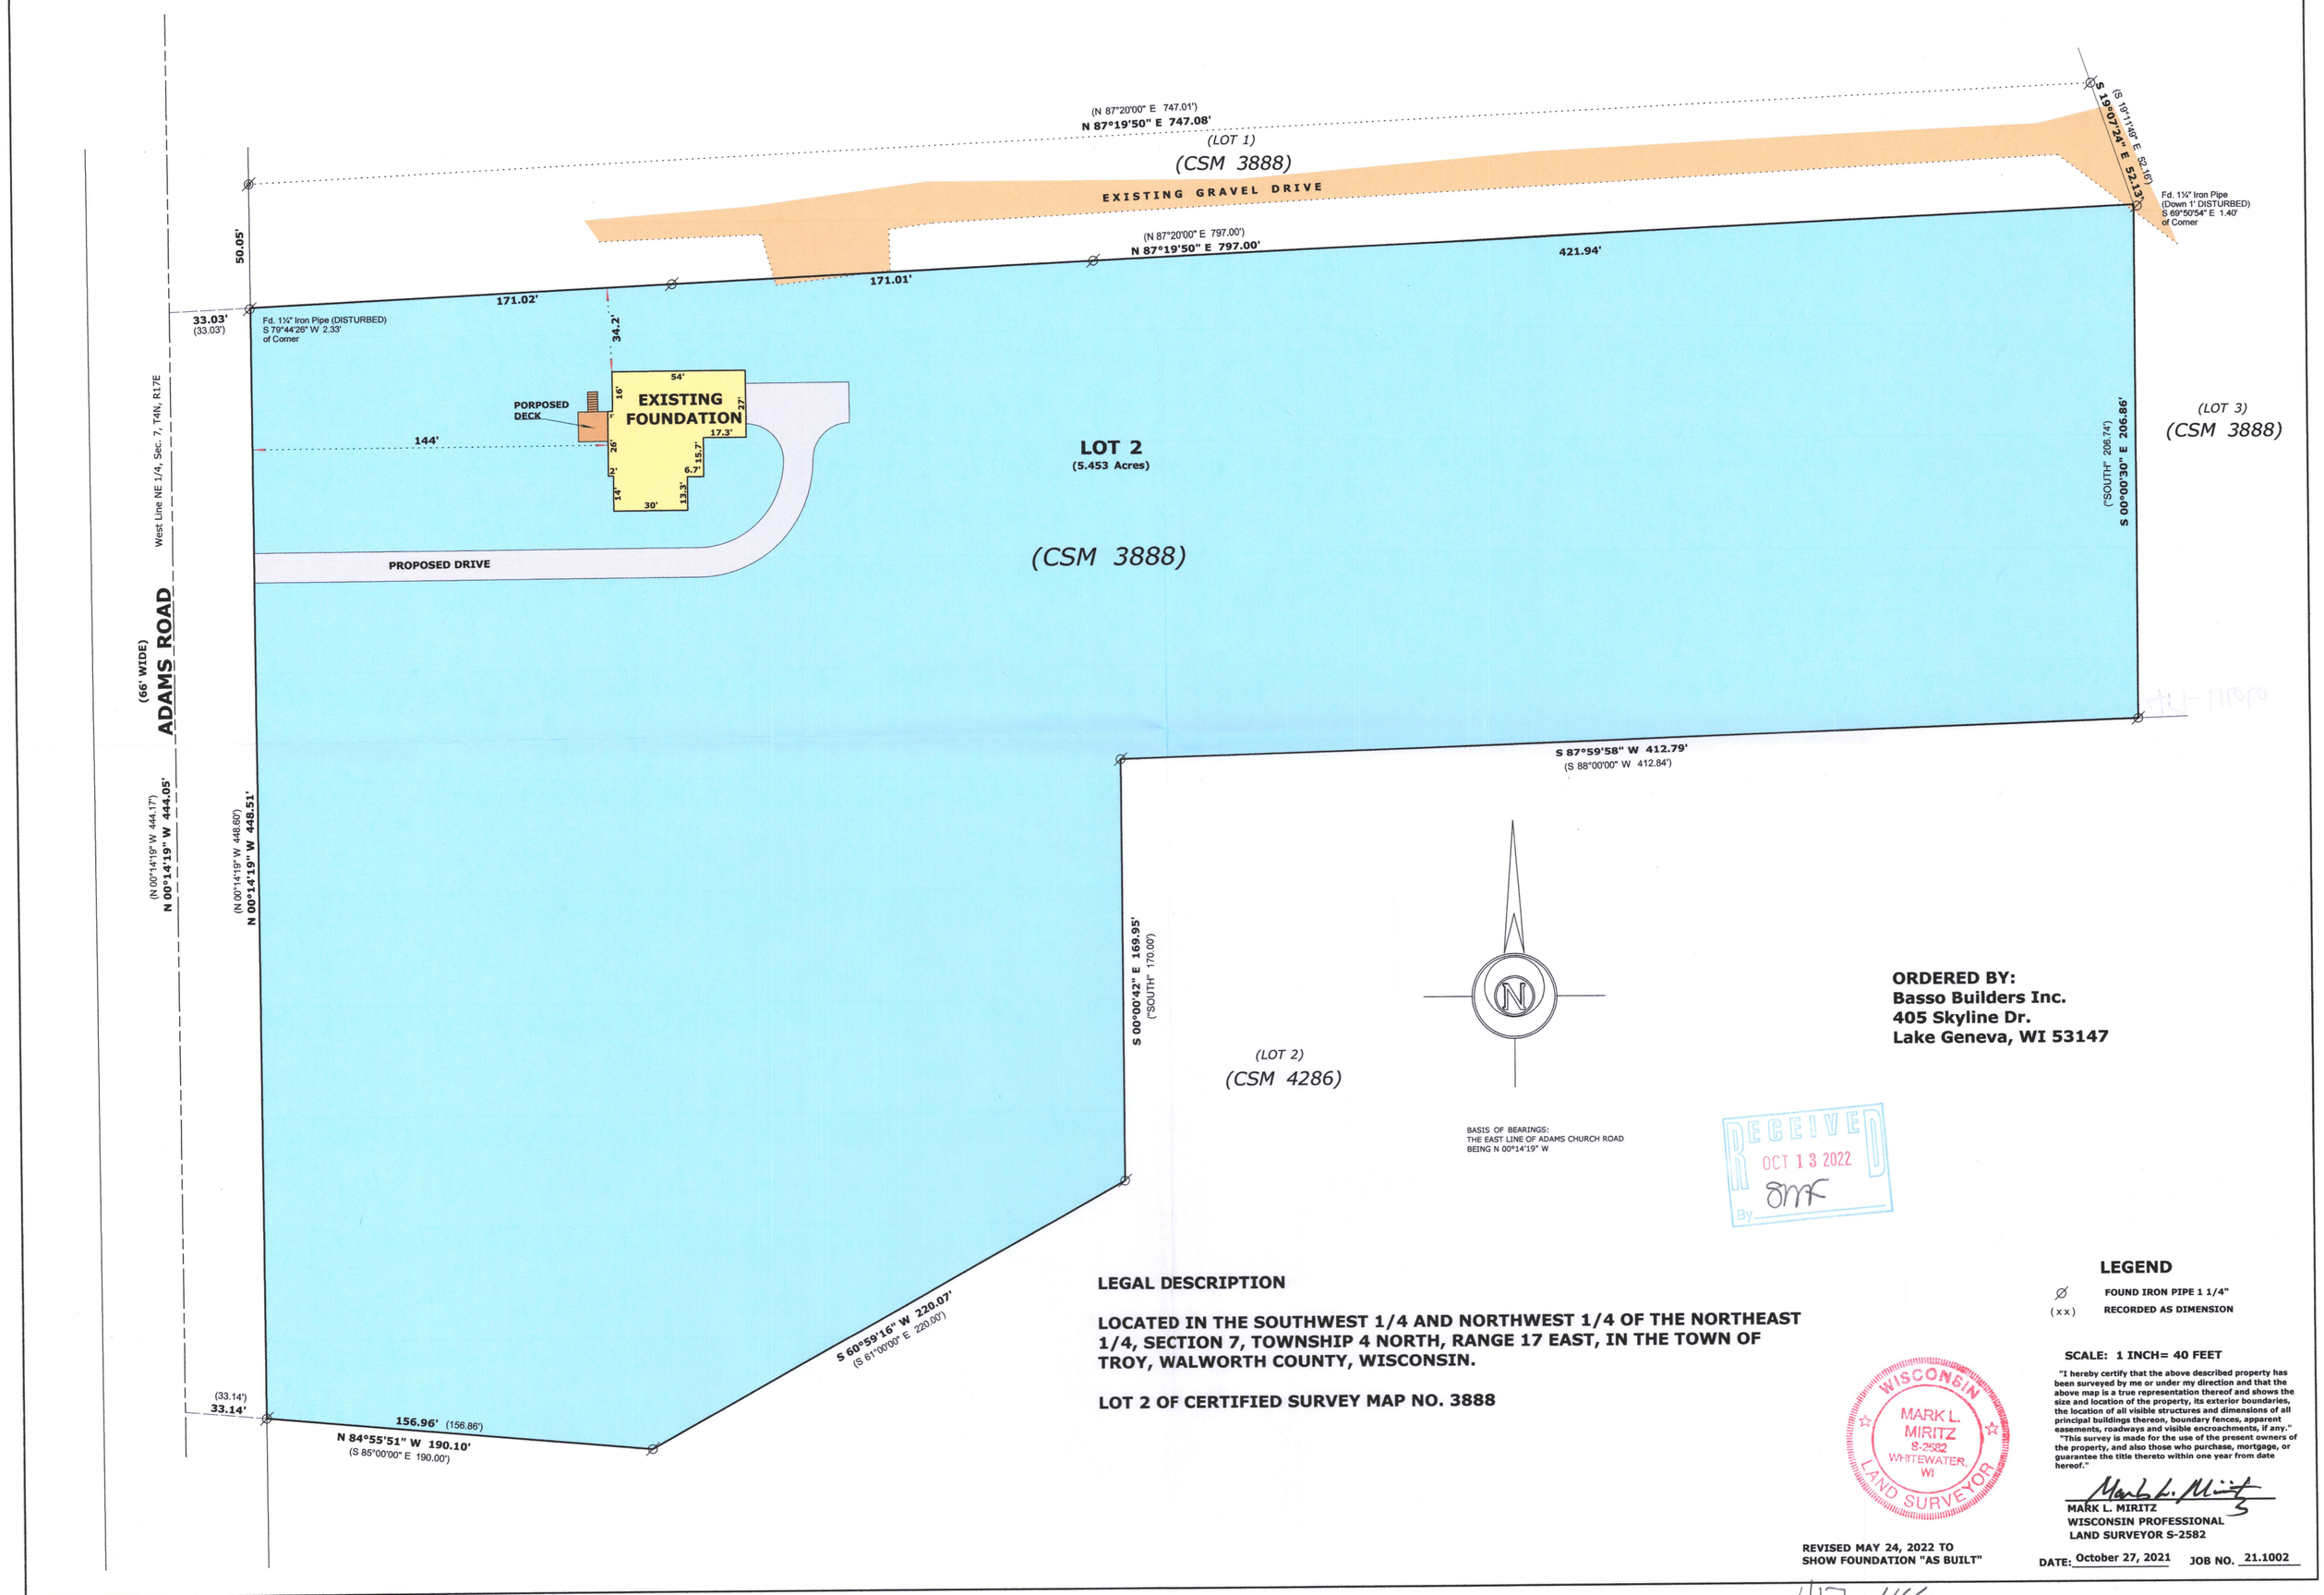

BASIS OF BEARINGS:
THE EAST LINE OF ADAMS CHURCH ROAD
BEING N 00°14'19" W

ORDERED BY:
Basso Builders Inc.
405 Skyline Dr.
Lake Geneva, WI 53147

RECEIVED
OCT 13 2022
By SMF

LEGAL DESCRIPTION

LOCATED IN THE SOUTHWEST 1/4 AND NORTHWEST 1/4 OF THE NORTHEAST 1/4, SECTION 7, TOWNSHIP 4 NORTH, RANGE 17 EAST, IN THE TOWN OF TROY, WALWORTH COUNTY, WISCONSIN.

LOT 2 OF CERTIFIED SURVEY MAP NO. 3888

LEGEND

- ∅ FOUND IRON PIPE 1 1/4"
- (xx) RECORDED AS DIMENSION

SCALE: 1 INCH= 40 FEET

"I hereby certify that the above described property has been surveyed by me or under my direction and that the above map is a true representation thereof and shows the size and location of the property, its exterior boundaries, the location of all visible structures and dimensions of all principal buildings thereon, boundary fences, apparent easements, roadways and visible encroachments, if any." "This survey is made for the use of the present owners of the property, and also those who purchase, mortgage, or guarantee the title thereto within one year from date hereof."

WISCONSIN MARK L. MIRITZ S-2582 WHITEWATER, WI LAND SURVEYOR

MARK L. MIRITZ
WISCONSIN PROFESSIONAL
LAND SURVEYOR S-2582

REVISED MAY 24, 2022 TO SHOW FOUNDATION "AS BUILT"

DATE: October 27, 2021 **JOB NO.** 21.1002

LA3888-2

417_1166