
59-88

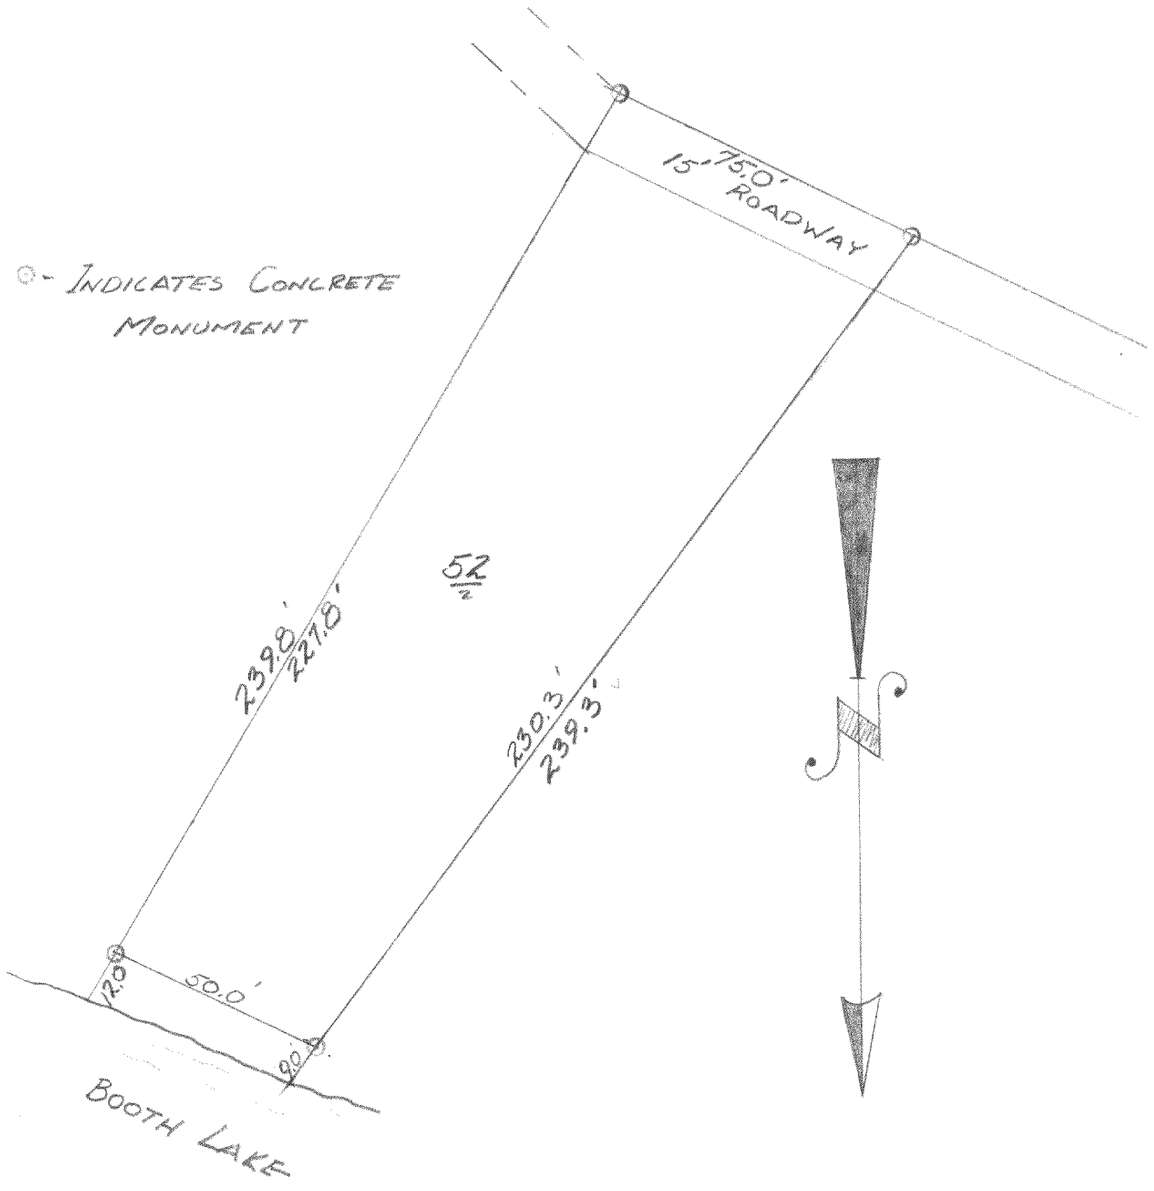

Description: Lot No. 52 of Booth Lakes Heights Subdivision
Located in the Town of Troy, T.4N., R.17E.
Walworth County, Wisconsin

Surveyed this 15th day of September 1959

James F. Biagi
(Surveyor No. 272)

WISCONSIN
JAMES F. BIAGI
MILWAUKEE, WIS.
LAND SURVEYOR

417-1B

LBL-45