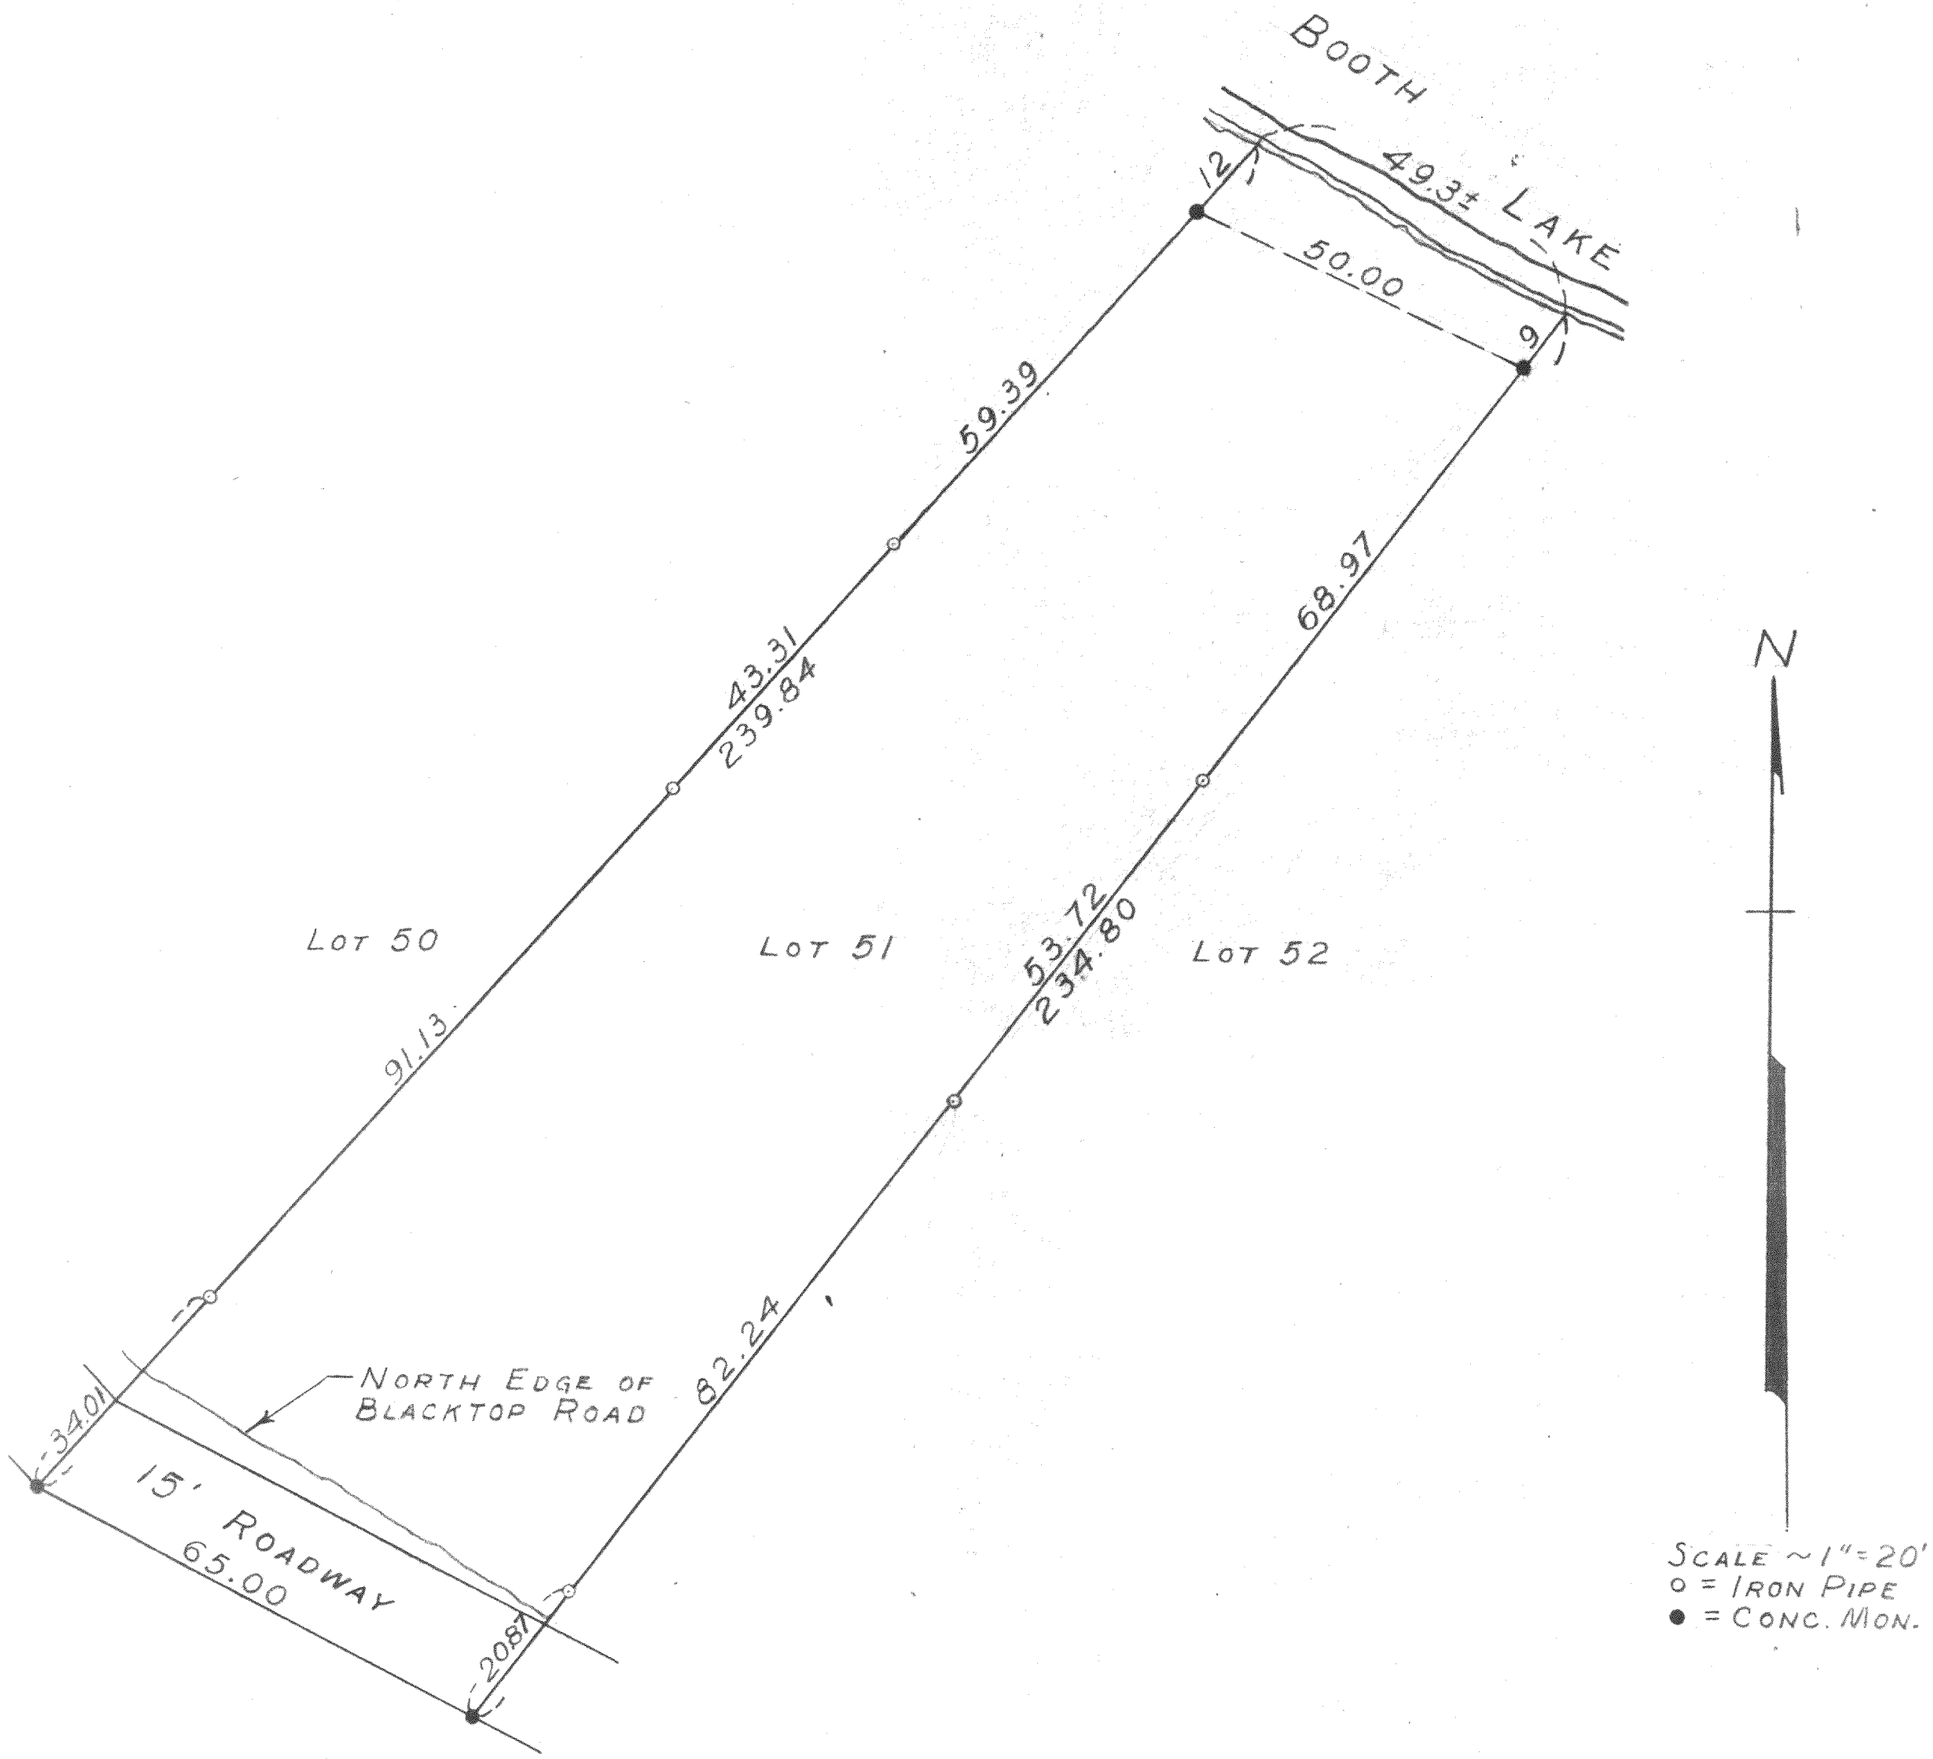

PLAT OF SURVEY OF LOT 51, BOOTH LAKE HEIGHTS, LOCATED IN THE TOWN OF TROY, WALWORTH COUNTY, WISCONSIN
SEPT. 9, 1955

George T. Dunham

GEORGE T. DUNHAM, SURVEYOR
DELAVAN, WISCONSIN

417-2

LBL-44