
RECEIVED
SEP 4 1985

DUNHAM SURVEYING, S.C.

SURVEYING & SUBDIVIDING
DELAVAN, WISCONSIN 53115

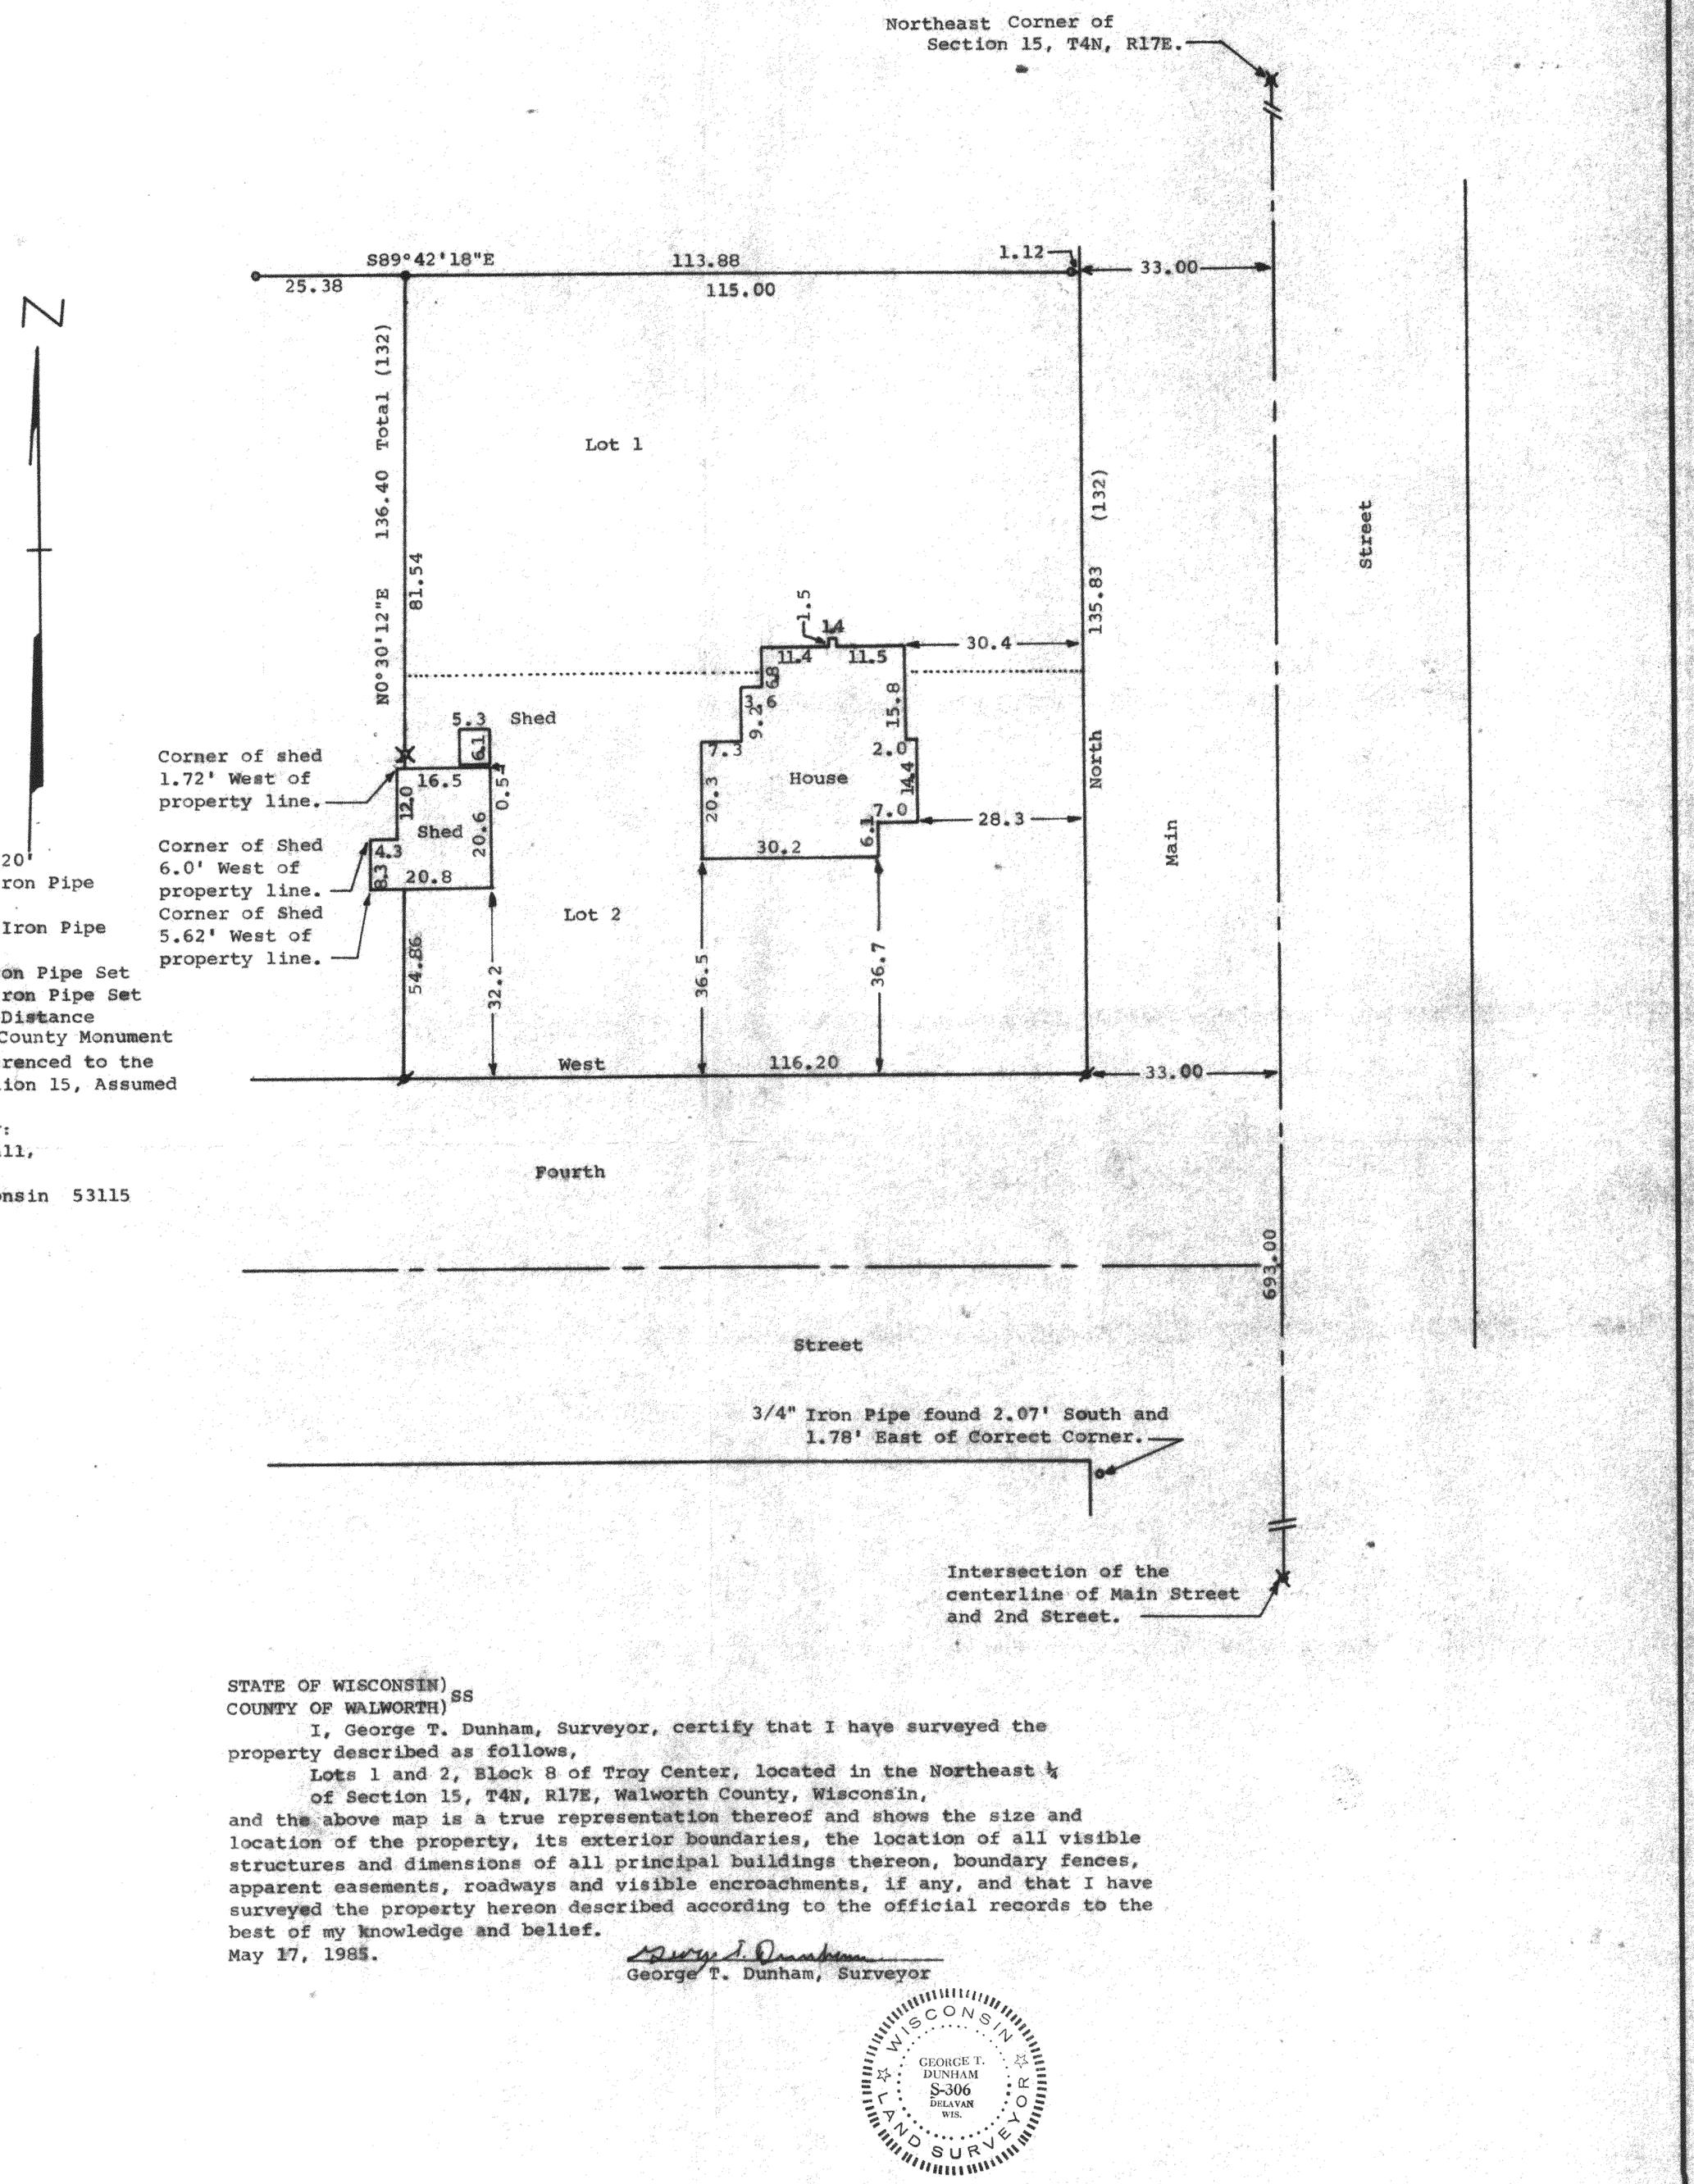

Scale - 1" = 20'
o = ½" Dia. Iron Pipe Found
⌑ = 3/4"x24" Iron Pipe Set
● = 1"x36" Iron Pipe Set
⌀ = 1½"x20" Iron Pipe Set
(000) = Recorded Distance
✖ = Concrete County Monument

Bearings are referenced to the East line of Section 15, Assumed bearing of North.

Survey Ordered By:
Dennis Stonewall,
Realtor
Delavan, Wisconsin 53115

STATE OF WISCONSIN)
COUNTY OF WALWORTH) SS

I, George T. Dunham, Surveyor, certify that I have surveyed the property described as follows,

Lots 1 and 2, Block 8 of Troy Center, located in the Northeast ¼ of Section 15, T4N, R17E, Walworth County, Wisconsin,

and the above map is a true representation thereof and shows the size and location of the property, its exterior boundaries, the location of all visible structures and dimensions of all principal buildings thereon, boundary fences, apparent easements, roadways and visible encroachments, if any, and that I have surveyed the property hereon described according to the official records to the best of my knowledge and belief.

May 17, 1985.

George T. Dunham, Surveyor

WISCONSIN
GEORGE T. DUNHAM
S-306
DELAVAN WIS.
LAND SURVEYOR

LTO-20

417-216

K & E 10-9155