
#86-64

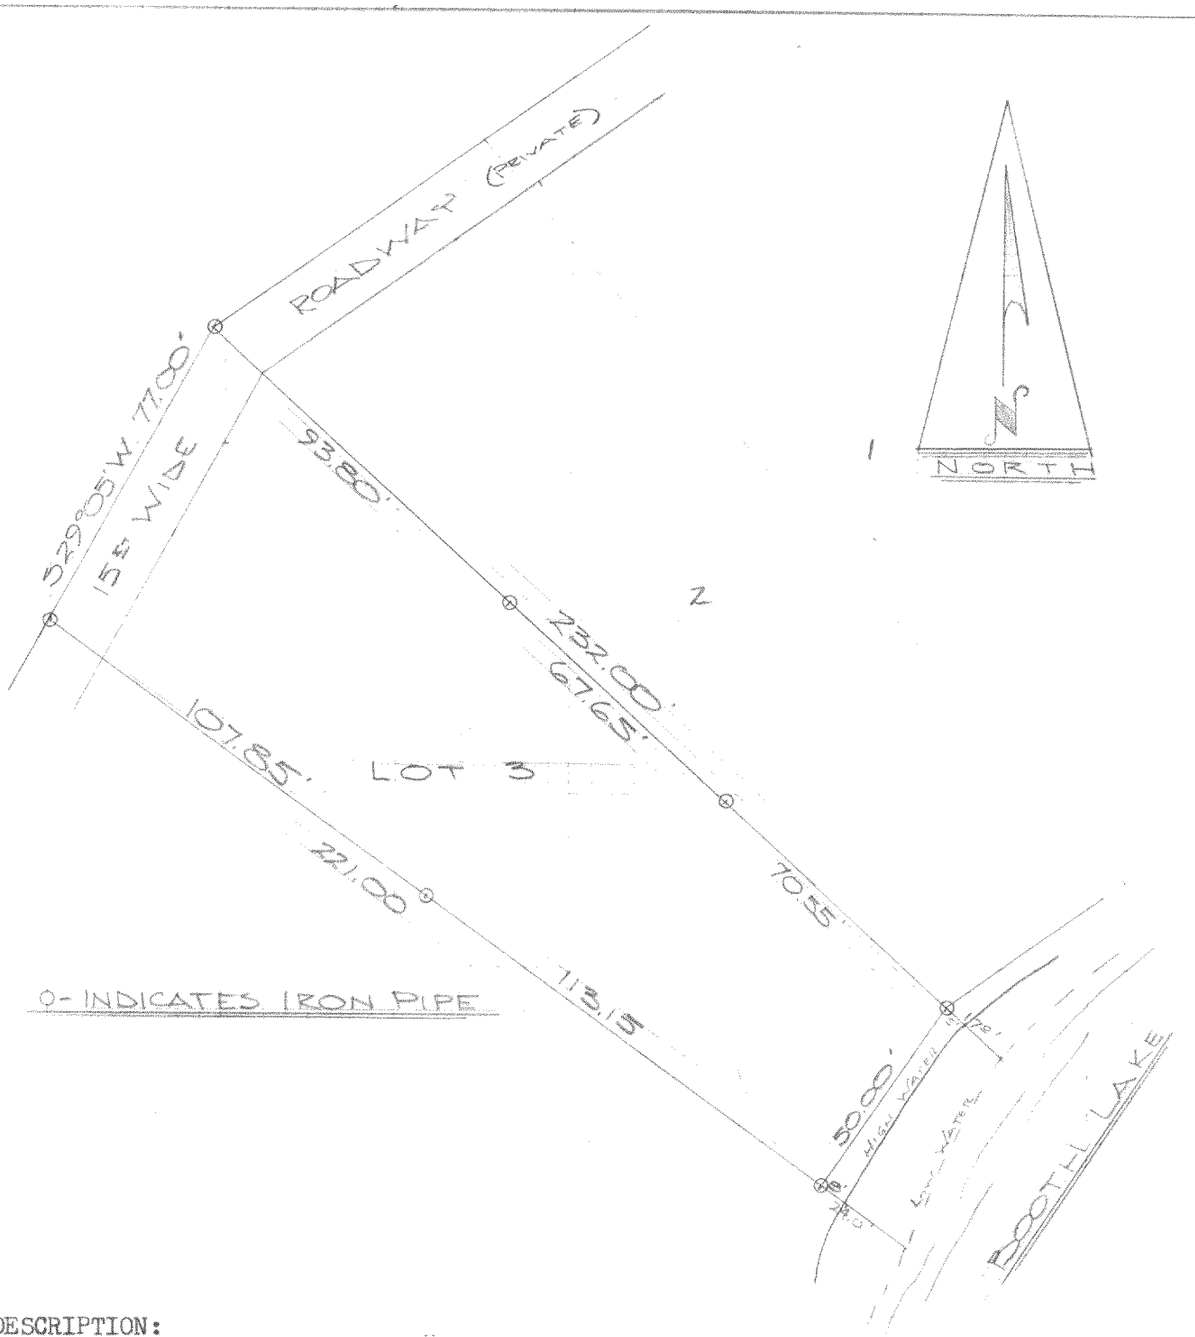

DESCRIPTION:

Lot 3, Booth Lake Heights a subdivision of a portion of Section 24, Town 4 north, Range 17 east, Walworth County, Wisconsin.

CERTIFICATE:

I, James F. Biagi Surveyor hereby certify that I have surveyed the above described property.

James F. Biagi RLS 272
Elkhorn, Wisconsin.

Date September 30th 1964.

LBL-2

417-23