
PLAT OF SURVEY
—OF—

LOT 19, BOOTH LAKE HEIGHTS SUBDIVISION, LOCATED IN PART OF SECTIONS 13 AND 24, TOWN 4 NORTH, RANGE 17 EAST, TOWNSHIP OF TROY, WALWORTH COUNTY, WISCONSIN.

SURVEY FOR: STEVE BARTLE
SURVEY LOCATION: N8582 BOOTH LAKE HEIGHTS ROAD

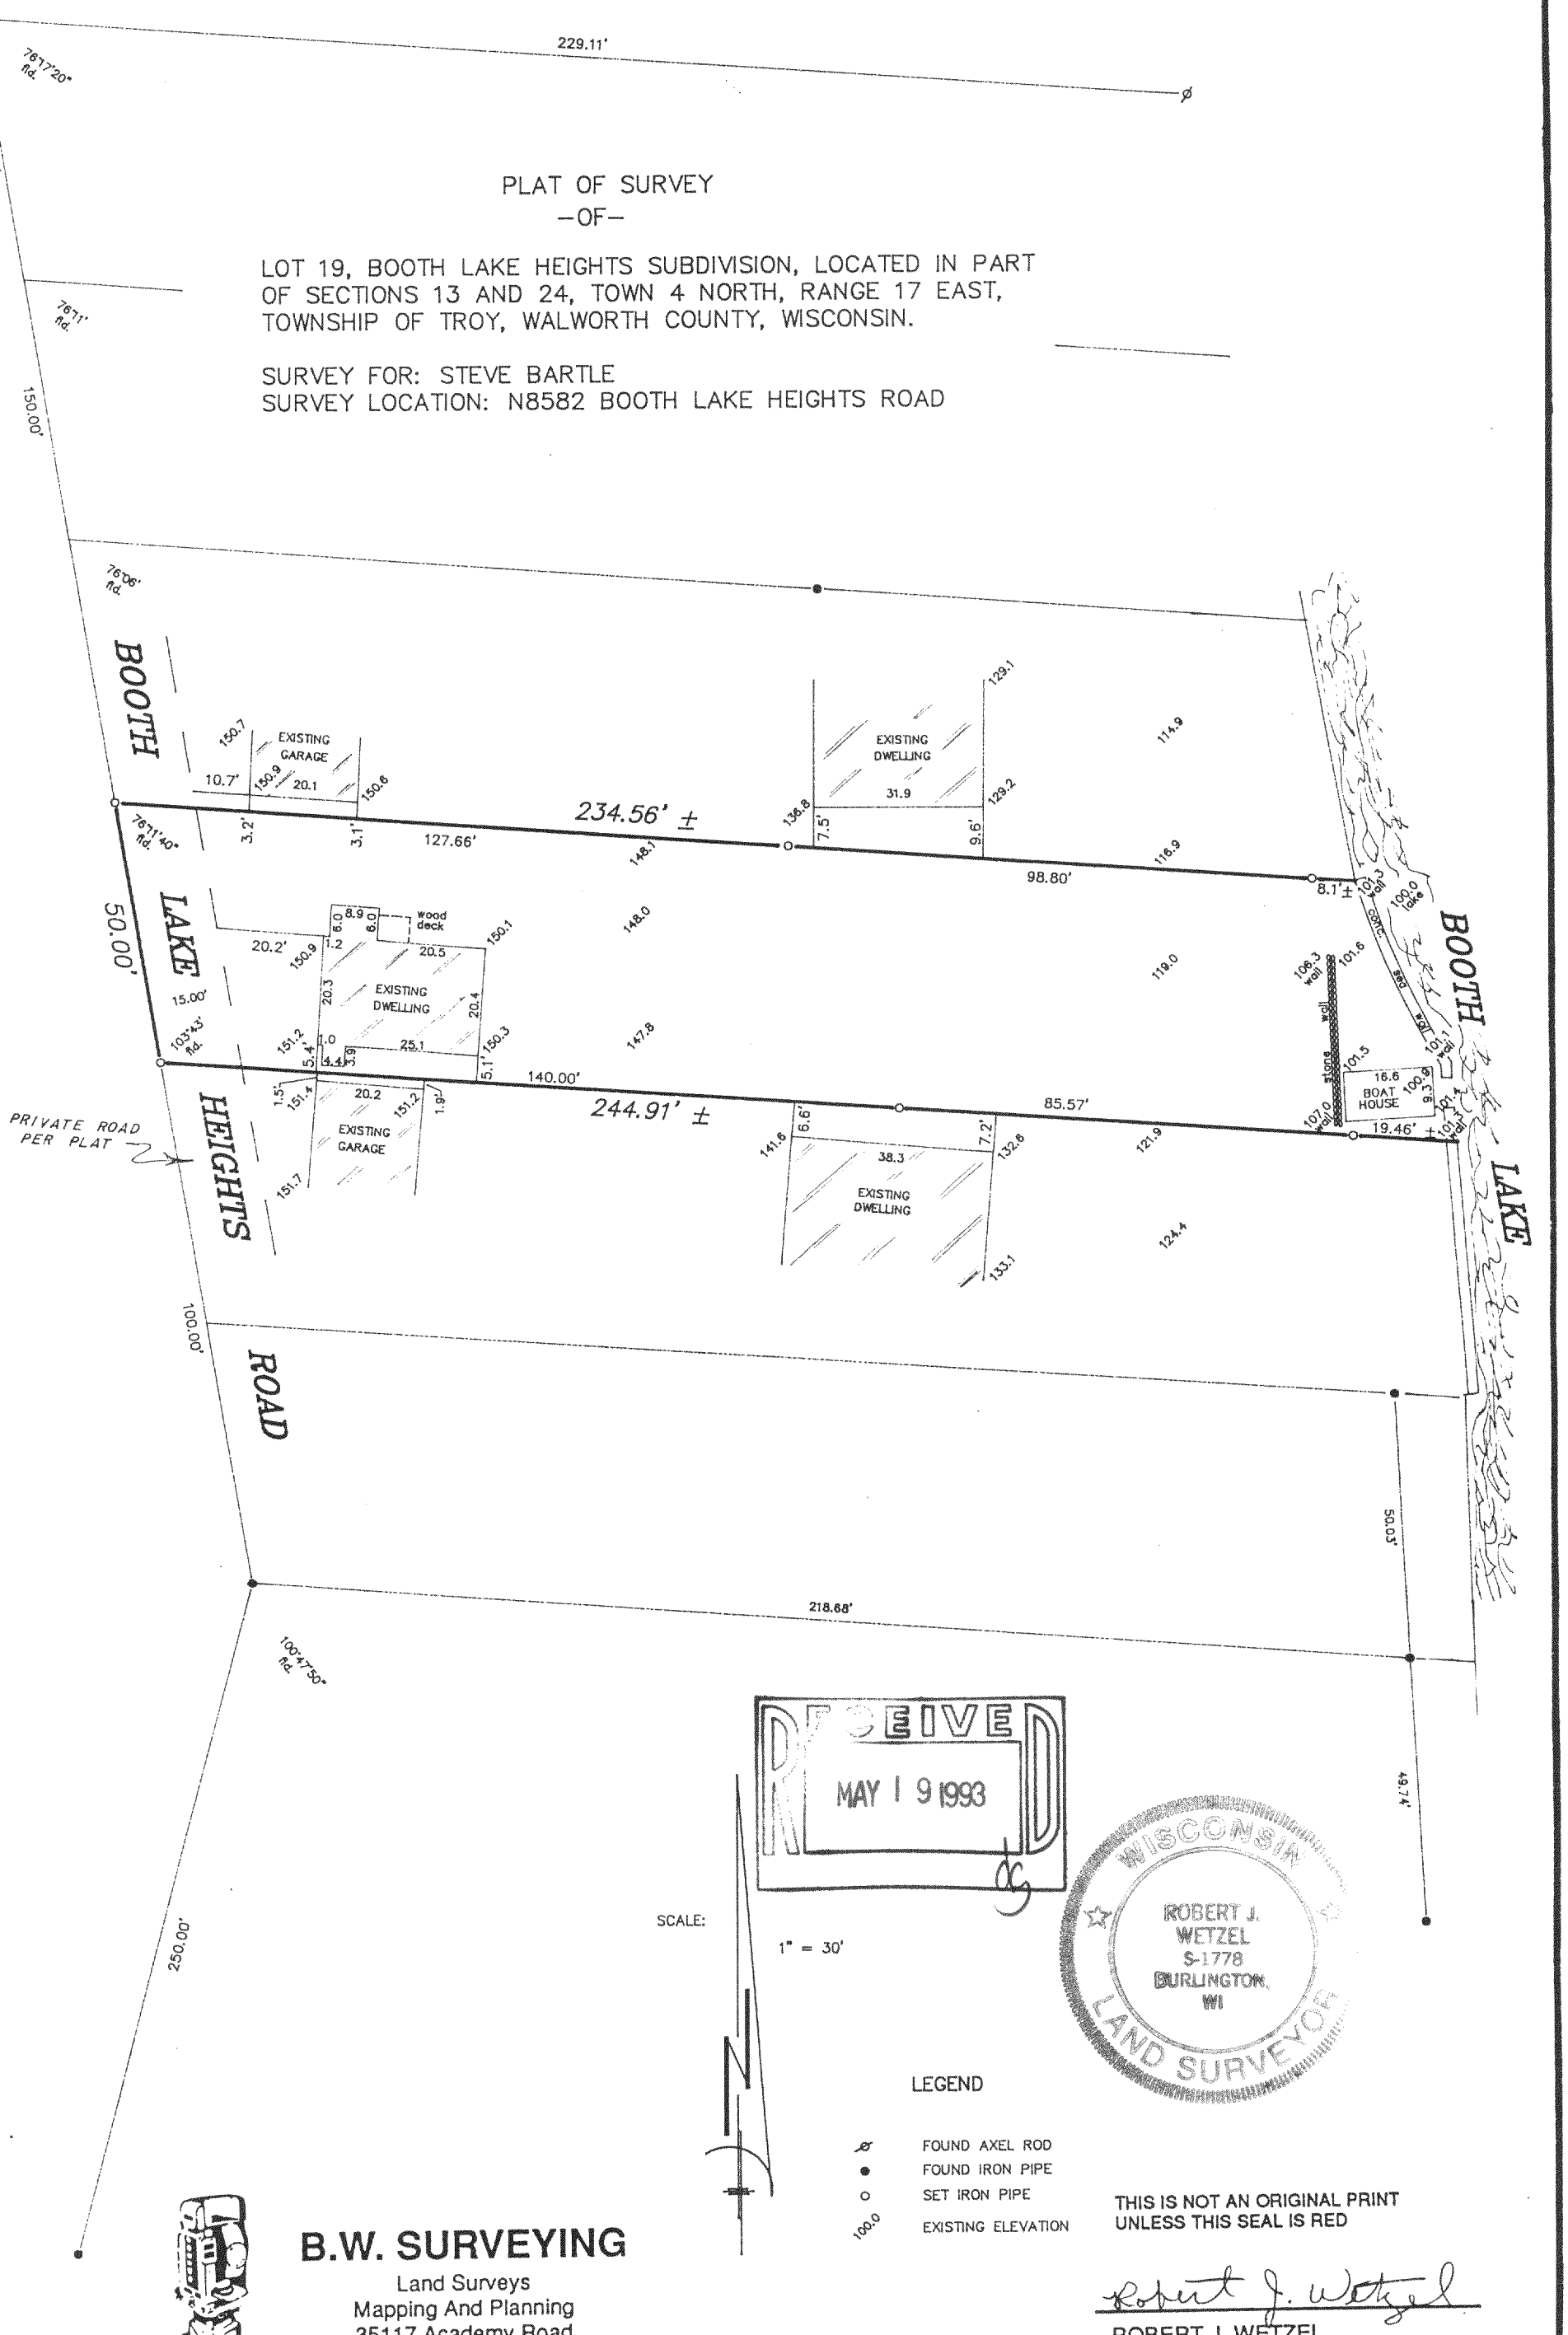

RECEIVED
MAY 19 1993

WISCONSIN
ROBERT J. WETZEL
S-1778
BURLINGTON, WI
LAND SURVEYOR

LEGEND

- FOUND AXEL ROD
- FOUND IRON PIPE
- SET IRON PIPE
- 100.0 EXISTING ELEVATION

THIS IS NOT AN ORIGINAL PRINT UNLESS THIS SEAL IS RED

Robert J. Wetzel
ROBERT J. WETZEL
REGISTERED LAND SURVERYOR - 1778

2/4/93
DATE

1125
JOB NUMBER

B.W. SURVEYING
Land Surveys
Mapping And Planning
35117 Academy Road
Burlington, Wisconsin 53105
(414) 534-4109

LBL-17

417-3604