
47-42

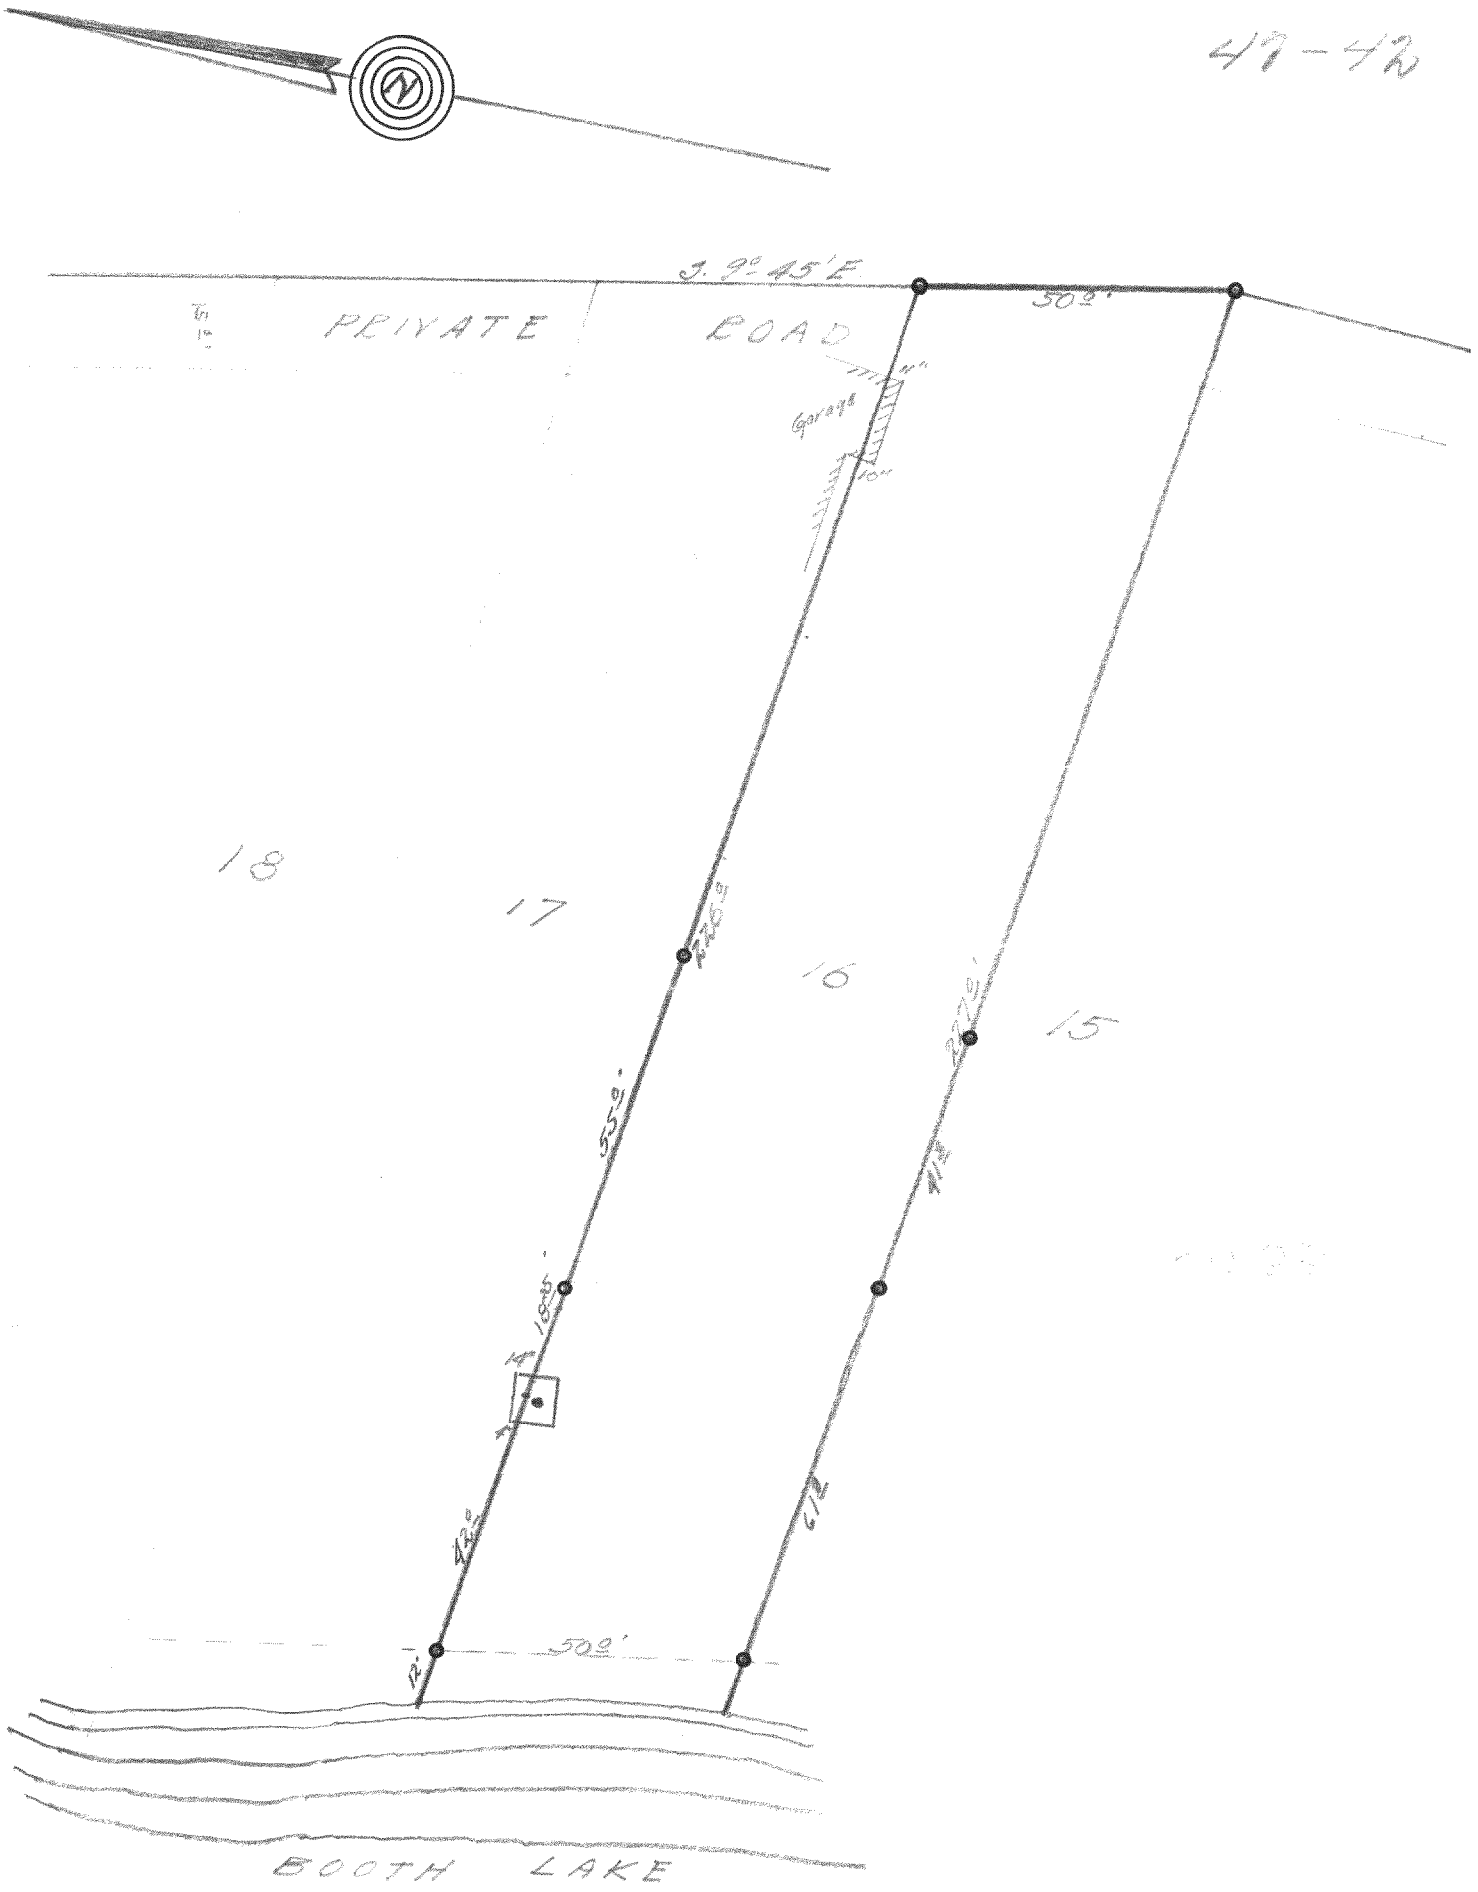

DESCRIPTION:

Lot 16, Booth Lake Heights Subdivision of a portion of the East ½ of the S.W. ¼ and the West ½ of the S.E. ¼ of Section 13, and the West ½ of the N.E. ¼ of Section 24, Township 4 north, Range 17 east of the 4th P.M.

CERTIFICATE:

I, hereby certify that I have on this the 7th day of October 1947, surveyed the above described property according to the official records on file in the office of the Recorder of Deeds in and for Walworth County, Wisconsin, and find that the measurements and bearings of the boundary lines of said property as taken at the site on this day substantially agree with those in the above description and that encroachments exist as shown.
The garage on the westerly portion of Lot 17 in said subdivision encroaches upon Lot 16, eleven inches on its westerly side and ten inches on its easterly side, the well pit on Lot 16 encroaches on Lot 17, four inches on its easterly side and fourteen inches on its westerly side.
SIGNED AND SEALED THIS 9TH DAY OF OCTOBER 1947

LBL 10

Joseph M. Biagi.
Professional Engineer
Elkhorn Wisconsin.

417-38