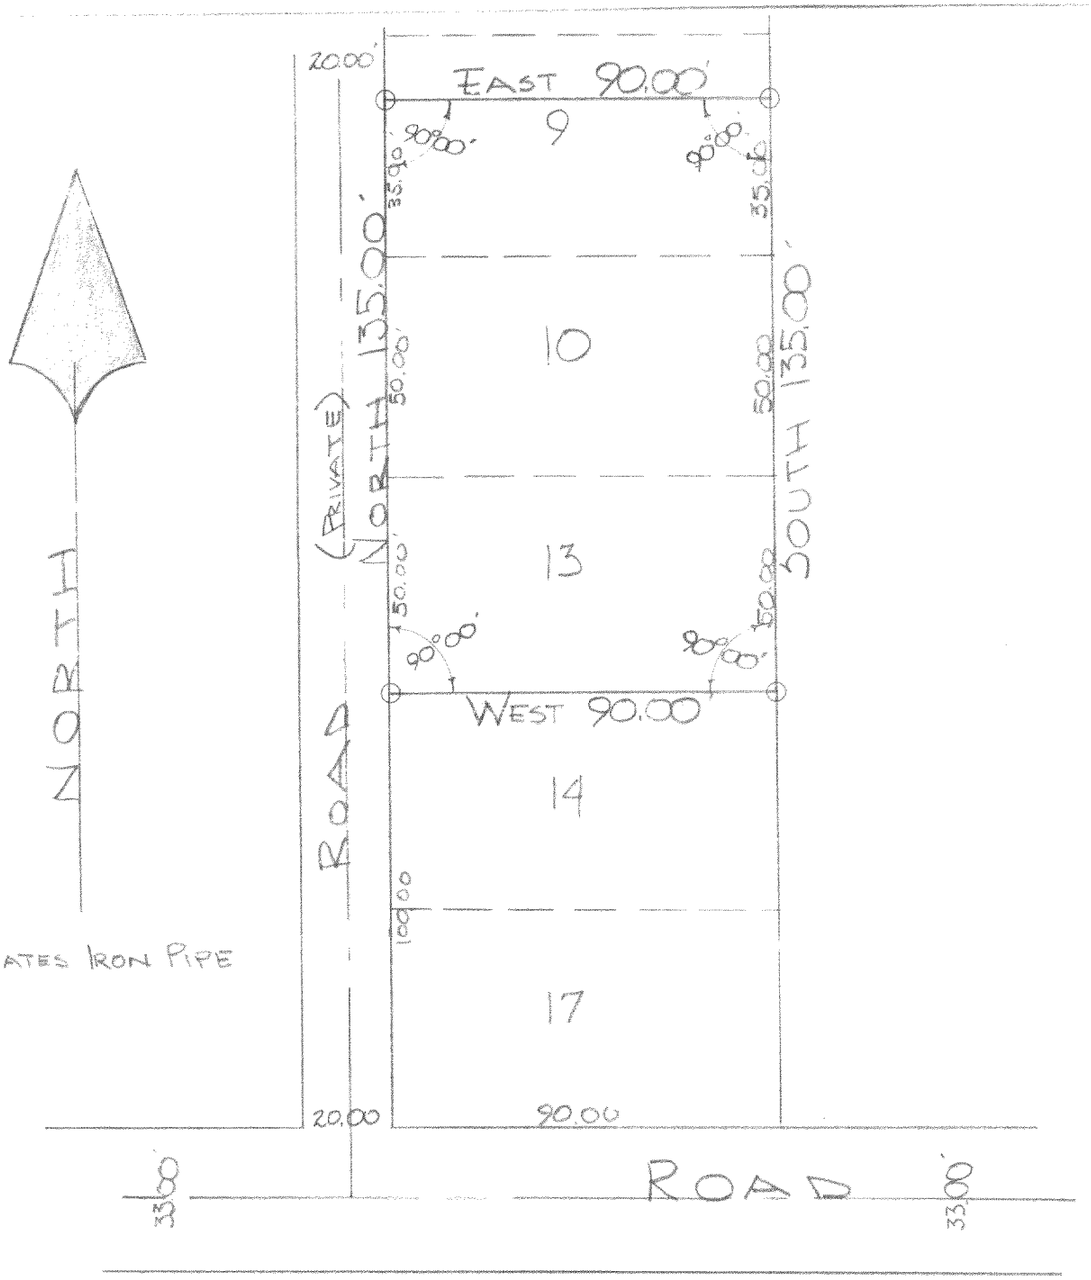


DESCRIPTION: Lots 13, 10, and the South 35.00 feet of Lot 9 in Fenlon's Addition, located in Section 24, T. 4 N., R. 17 E., (Town of Troy) Walworth County, Wisconsin.

CERTIFICATE: I, James F. Biagi, Surveyor, do hereby certify that I have surveyed the property hereon described on this 6th day of March, 1962.

WISCONSIN JAMES F. BIAGI MILWAUKEE, WIS. LAND SURVEYOR

James F. Biagi, RLS 272

LHF-1C1

" -1E

LHF-2

417-4B