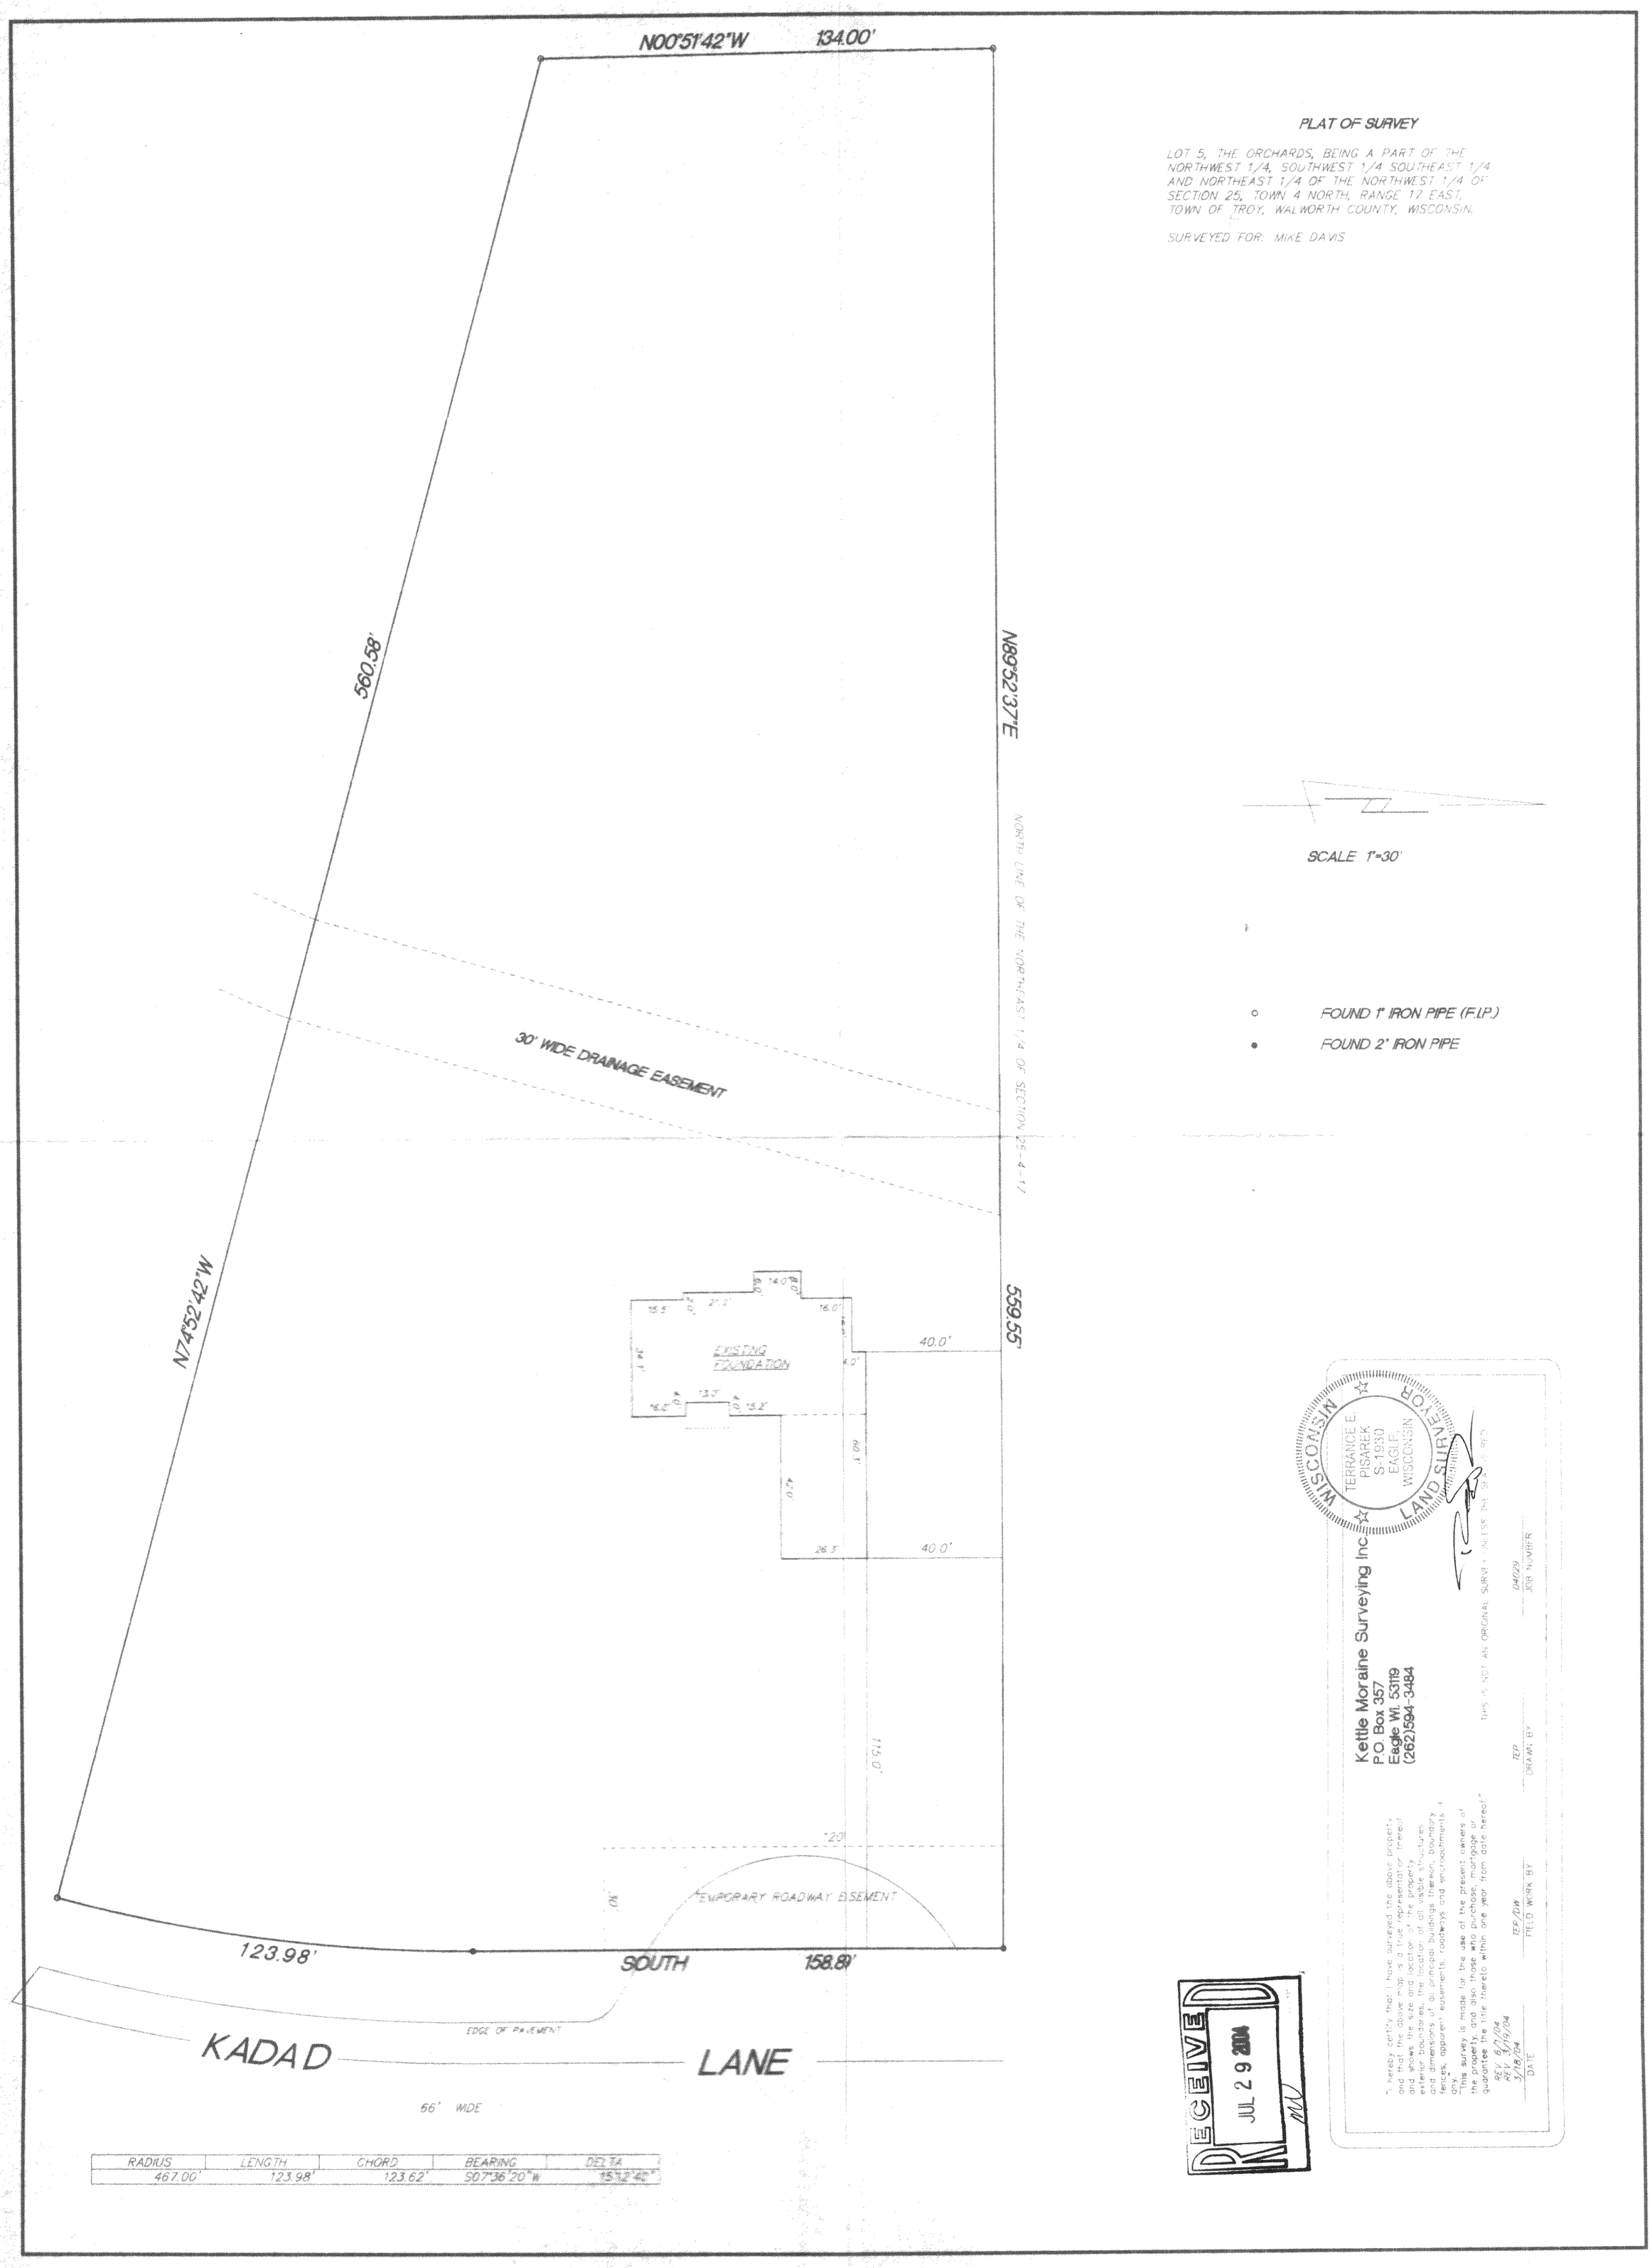

RADIUS	LENGTH	CHORD	BEARING	DELTA
467.00'	123.98'	123.62'	S07°36'20"W	15°12'40"

PLAT OF SURVEY

LOT 5, THE ORCHARDS, BEING A PART OF THE NORTHWEST 1/4, SOUTHWEST 1/4 SOUTHEAST 1/4 AND NORTHEAST 1/4 OF THE NORTHWEST 1/4 OF SECTION 25, TOWN 4 NORTH, RANGE 17 EAST, TOWN OF TROY, WALWORTH COUNTY, WISCONSIN.

SURVEYED FOR: MIKE DAVIS

"I hereby certify that I have surveyed the above property and that the above map is a true representation thereof and shows the size and location of the property, exterior boundaries, the location of all visible structures and dimensions of all principal buildings thereon, boundary fences, apparent easements, roadways and encroachments, if any."

"This survey is made for the use of the present owners of the property, and also those who purchase, mortgage or guarantee the title thereto within one year from date hereof."

REV. 6/7/04
REV. 3/19/04
3/18/04
DATE

LOR 00005

417-742