FARRIS, HANSEN & ASSOCIATES, INC.

ENGINEERING – ARCHITECTURE – SURVEYING
7 RIDGWAY COURT – P.O. BOX 437 – ELKHORN, WISCONSIN 53121
PHONE: (262) 723–2098 FAX: (262) 723–5886

FOUNDATION LOCATION MAPPING

LOT 14 SADDLE CLUB OF WALWORTH COUNTY

LOCATED IN THE SOUTHWEST 1/4 SECTION 30
TOWN 4 NORTH, RANGE 17 EAST
WALWORTH COUNTY, WISCONSIN

– WORK ORDERED BY –
RAY TWIST
N4522 COUNTY ROAD "F"
ELKHORN, WI. 53121

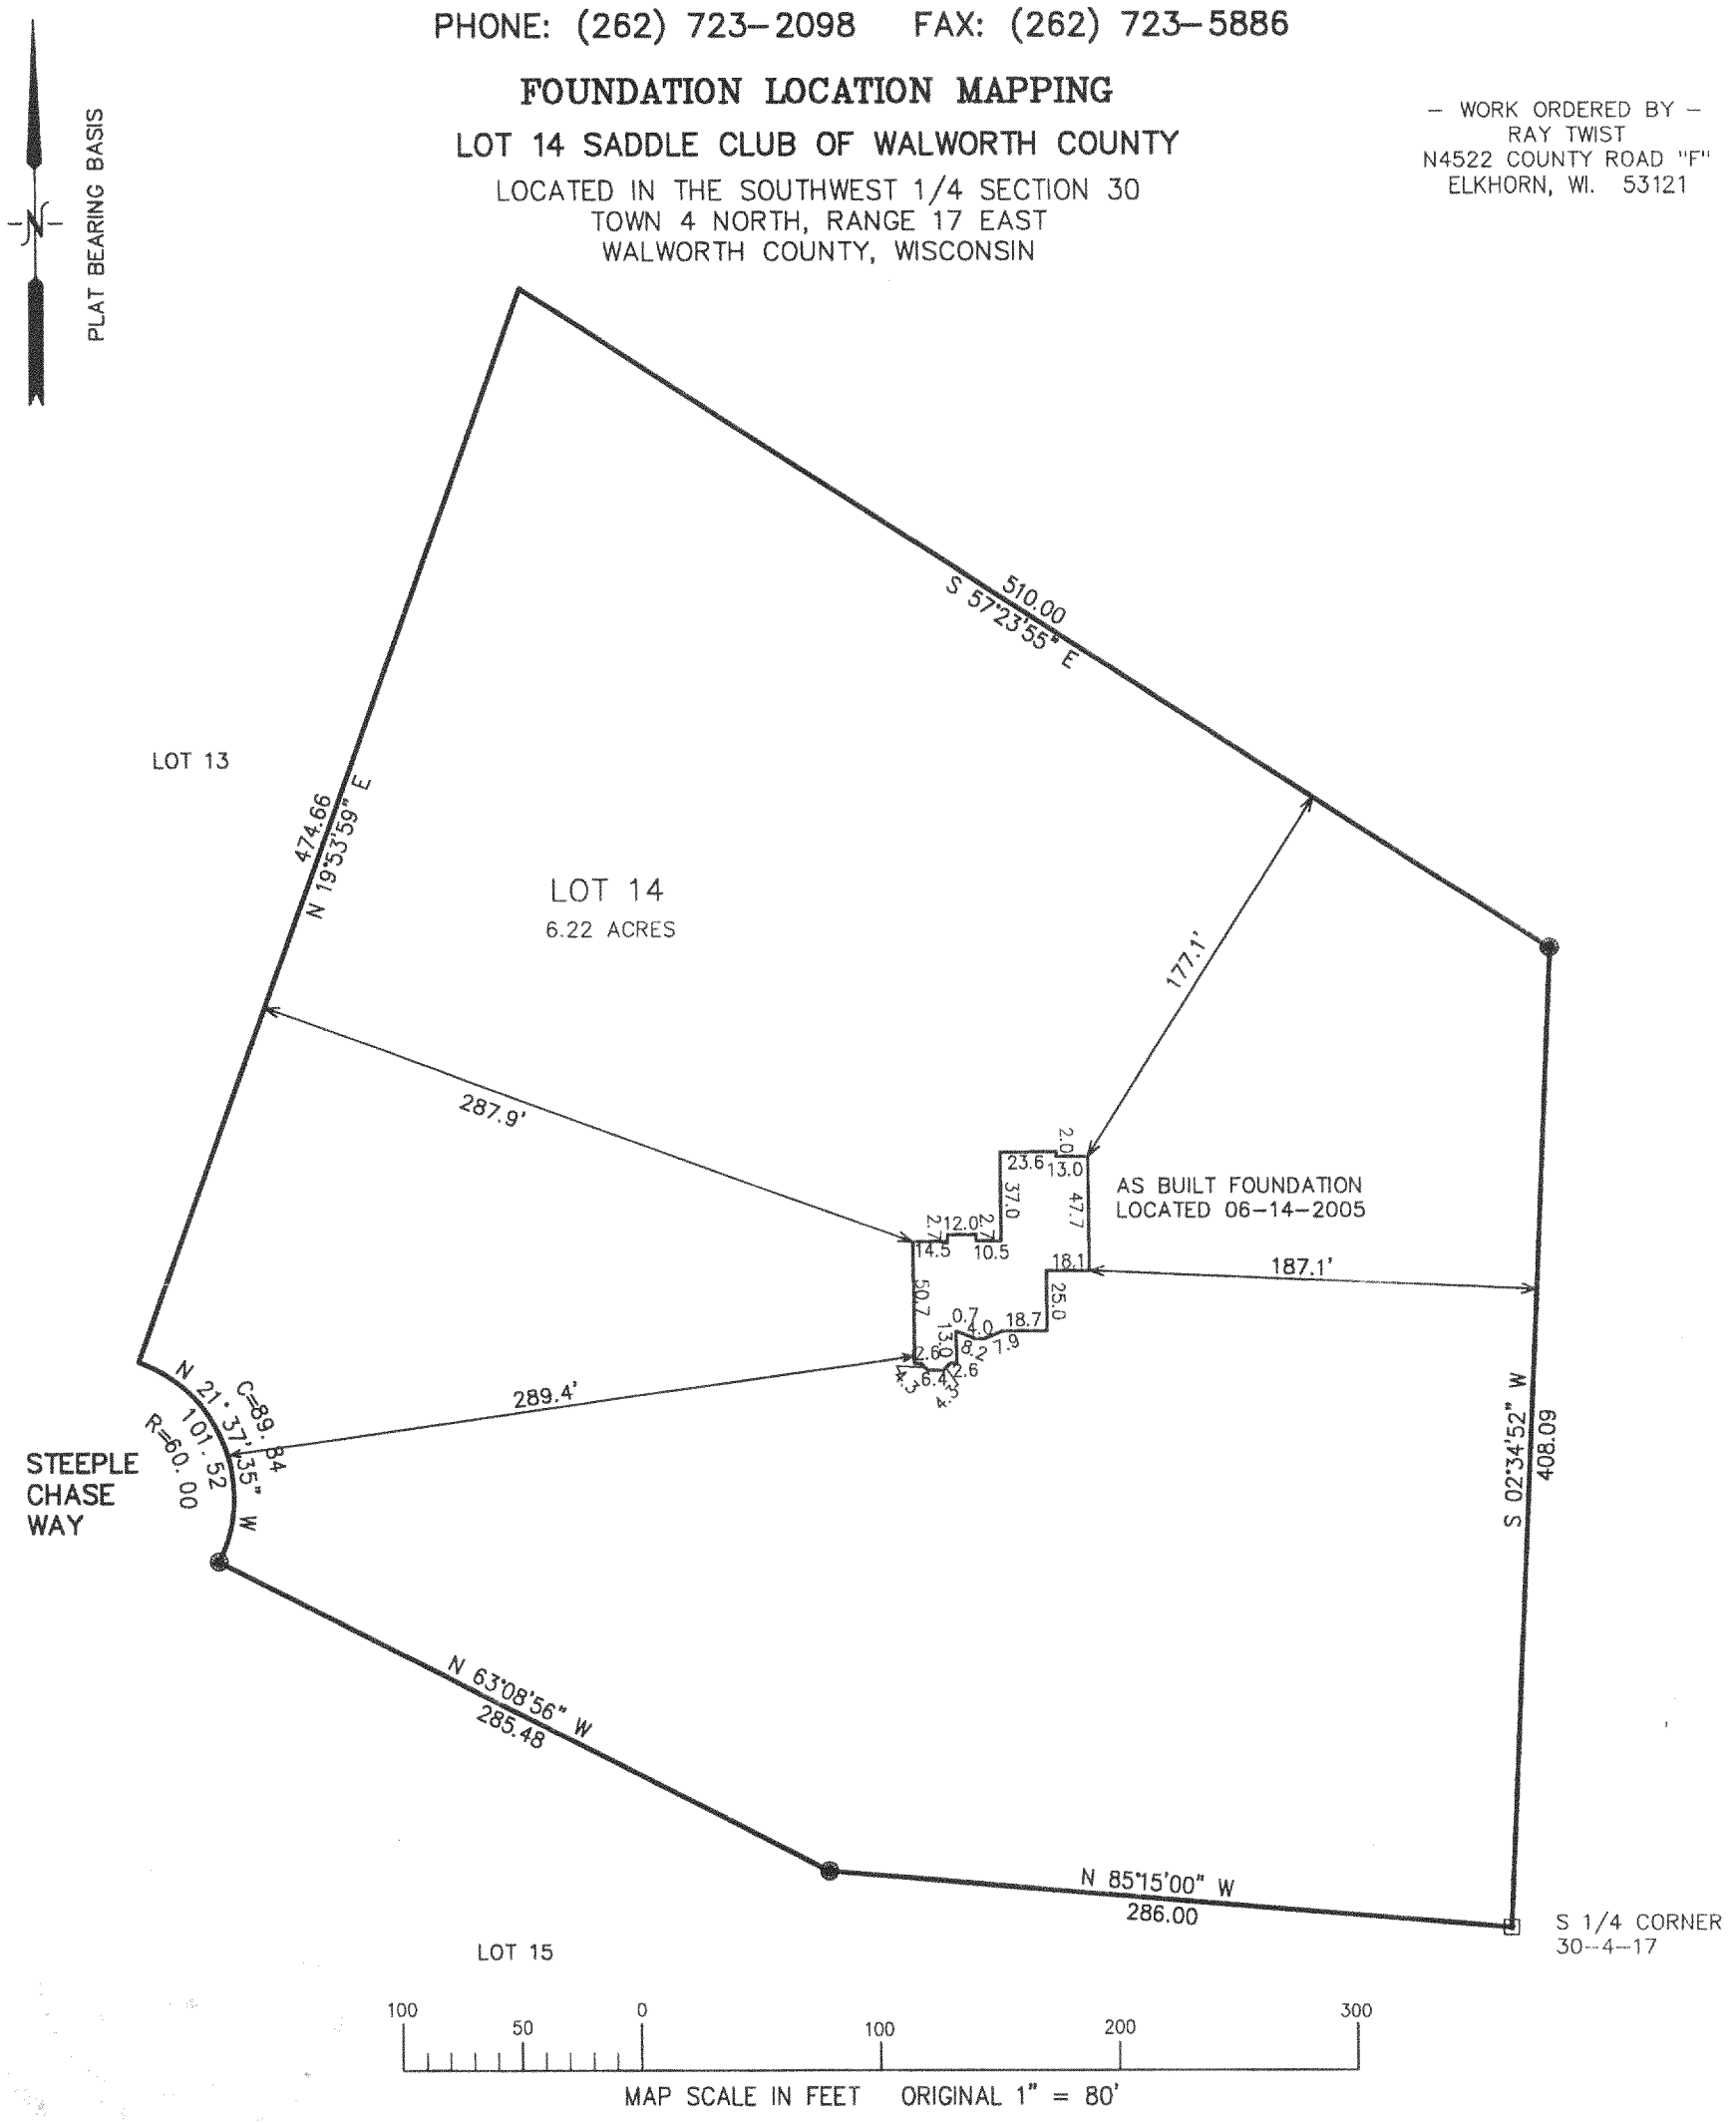

LEGEND

● = FOUND IRON REBAR STAKE
(XXX) = RECORDED AS
⊡ = FOUND CONCRETE COUNTY MONUMENT

NOTE: COPIES OF THIS MAP TO WHICH THE FOLLOWING CERTIFICATE WILL APPLY SHOW SURVEYOR'S ORIGINAL SEAL AND SIGNATURE IN RED INK. COPIES BY ANY OTHER MEANS MAY HAVE ALTERATIONS WHICH DO NOT REPRESENT THE SURVEYOR'S WORK PRODUCT.

I HEREBY CERTIFY THAT THIS MAP IS A TRUE AND ACCURATE REPRESENTATION OF THE LOCATION OF THE AS BUILT FOUNDATION IN RELATION TO THE BOUNDARIES OF LOT 14 OF SADDLE CLUB OF WALWORTH COUNTY. THE BOUNDARIES OF LOT 14 ARE SHOWN IN RELATION TO THE FOUR MONUMENTS FOUND AND SHOWN REPRESENTING THE SOUTH AND EAST LOT LINES TO THE BEST OF MY PROFESSIONAL KNOWLEDGE AND BELIEF. NOTE THIS IS NOT A PLAT OF SURVEY AS DEFINED IN CHAPTER A–E 7 OF WISCONSIN ADMINISTATIVE CODE

DATED: JUNE 15, 2005

PETER S. GORDON RLS 2101

RECEIVED
JUN 3 2005

PROJECT: 6796
DATE: 06–14–2005
SHEET 1 OF 1

LSC 00014

47–771