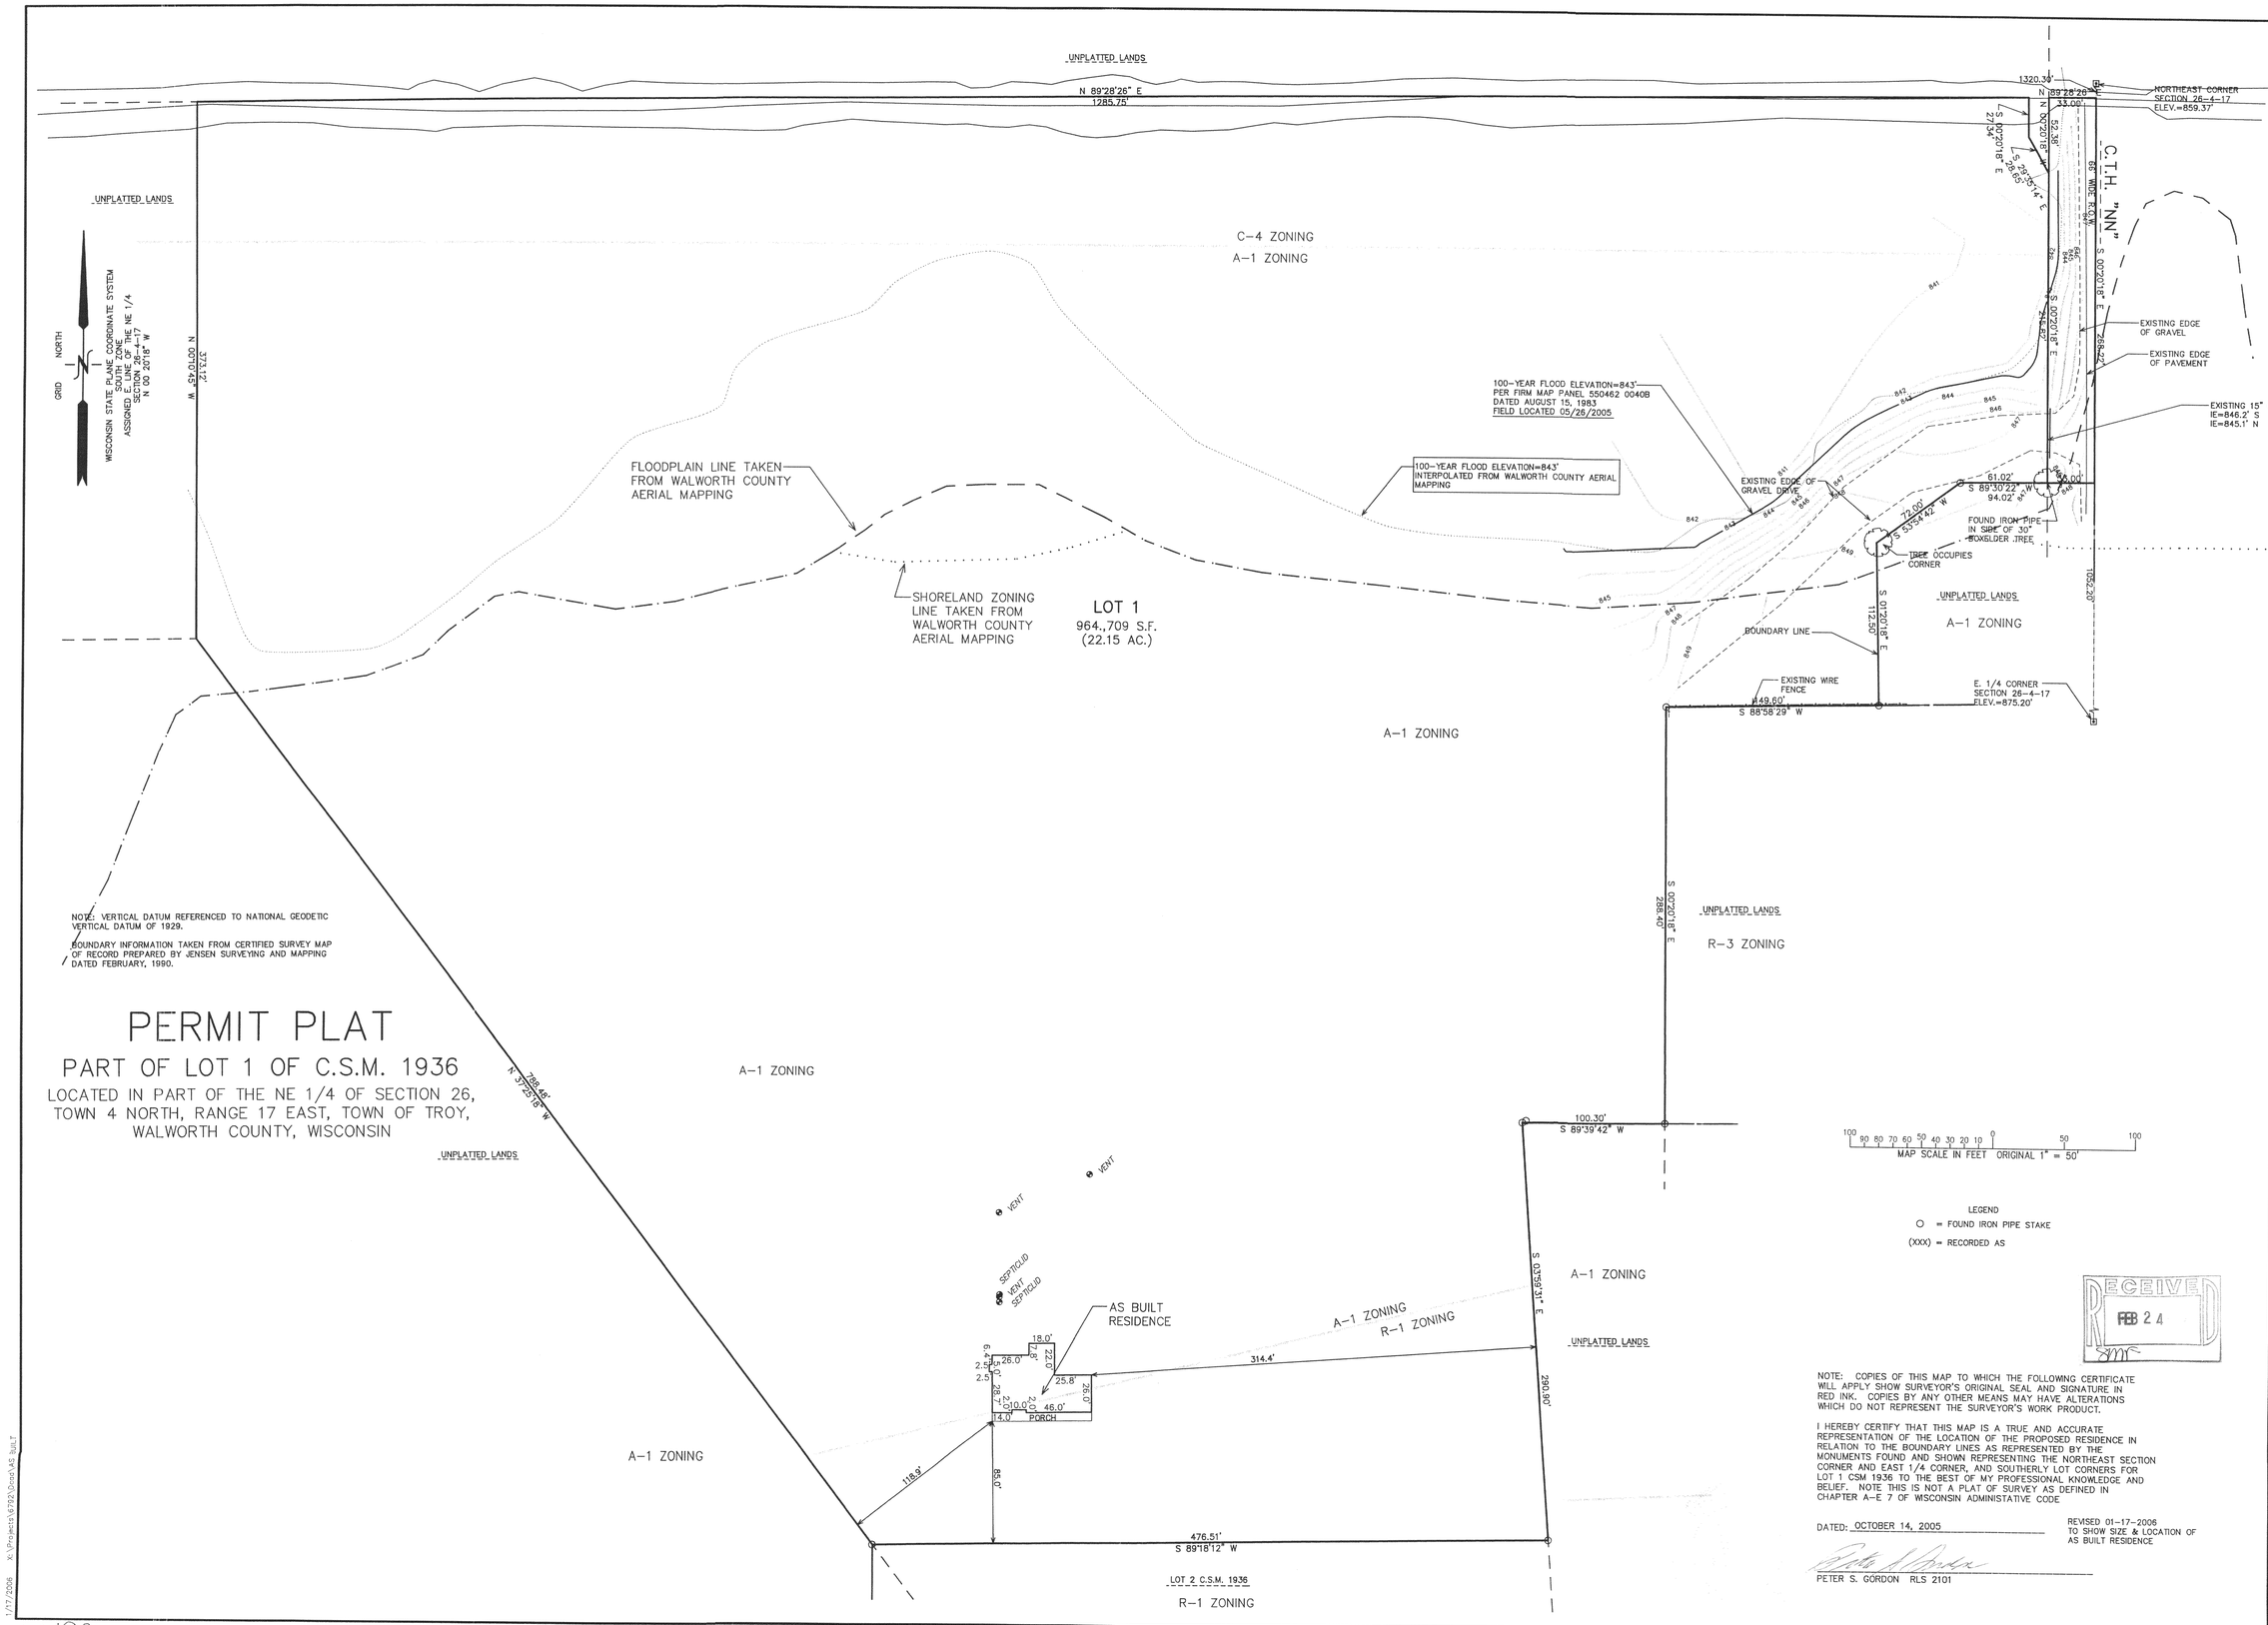

RECEIVED
FEB 24

NOTE: COPIES OF THIS MAP TO WHICH THE FOLLOWING CERTIFICATE WILL APPLY SHOW SURVEYOR'S ORIGINAL SEAL AND SIGNATURE IN RED INK. COPIES BY ANY OTHER MEANS MAY HAVE ALTERATIONS WHICH DO NOT REPRESENT THE SURVEYOR'S WORK PRODUCT.

I HEREBY CERTIFY THAT THIS MAP IS A TRUE AND ACCURATE REPRESENTATION OF THE LOCATION OF THE PROPOSED RESIDENCE IN RELATION TO THE BOUNDARY LINES AS REPRESENTED BY THE MONUMENTS FOUND AND SHOWN REPRESENTING THE NORTHEAST SECTION CORNER AND EAST 1/4 CORNER, AND SOUTHERLY LOT CORNERS FOR LOT 1 CSM 1936 TO THE BEST OF MY PROFESSIONAL KNOWLEDGE AND BELIEF. NOTE THIS IS NOT A PLAT OF SURVEY AS DEFINED IN CHAPTER A-E 7 OF WISCONSIN ADMINISTATIVE CODE

DATED: OCTOBER 14, 2005

REVISED 01-17-2006
TO SHOW SIZE & LOCATION OF
AS BUILT RESIDENCE

PETER S. GORDON RLS 2101

– WORK ORDERED BY –
BOB GULLAND
W2055 HONEY CREEK ROAD
EAST TROY, WI 53120

FARRIS, HANSEN & ASSOCIATES, INC.
ENGINEERING – ARCHITECTURE – SURVEYING
7 RIDGWAY COURT P.O. BOX 437
ELKHORN, WISCONSIN 53121
OFFICE: (262) 723-2098 FAX: (262) 723-5886

REVISIONS

10-27-2005
ADD SOIL BORINGS

12-14-2005
ADD COUNTY TOPO LINE

PROJECT NO.	6792
DATE	10/13/05
SHEET NO.	1 OF 1

1/17/2006 X:\Projects\6792\Dwg\AS Built

LA1936-1

417-796