PLAT OF SURVEY

RSV
ENGINEERING, INC.
Engineers•Land Surveyors•Environmental Scientists
W232 S7530 BIG BEND DR. BIG BEND, WI 53103 (262)662-4292

FOR: JEFF WOLF
DATE: 09/24/2007
DATE: 12/07/2007 RECERTIFICATION
DESCRIPTION: LOT 40 OF BOOTH LAKE HEIGHTS, BEING A SUBDIVISION LOCATED IN THE EAST 1/2 OF THE SW 1/4 AND THE WEST 1/2 OF THE SE 1/4 OF SECTION 24, TOWN 4 NORTH, RANGE 17 EAST, TOWN OF TROY, WALWORTH COUNTY, WISCONSIN.

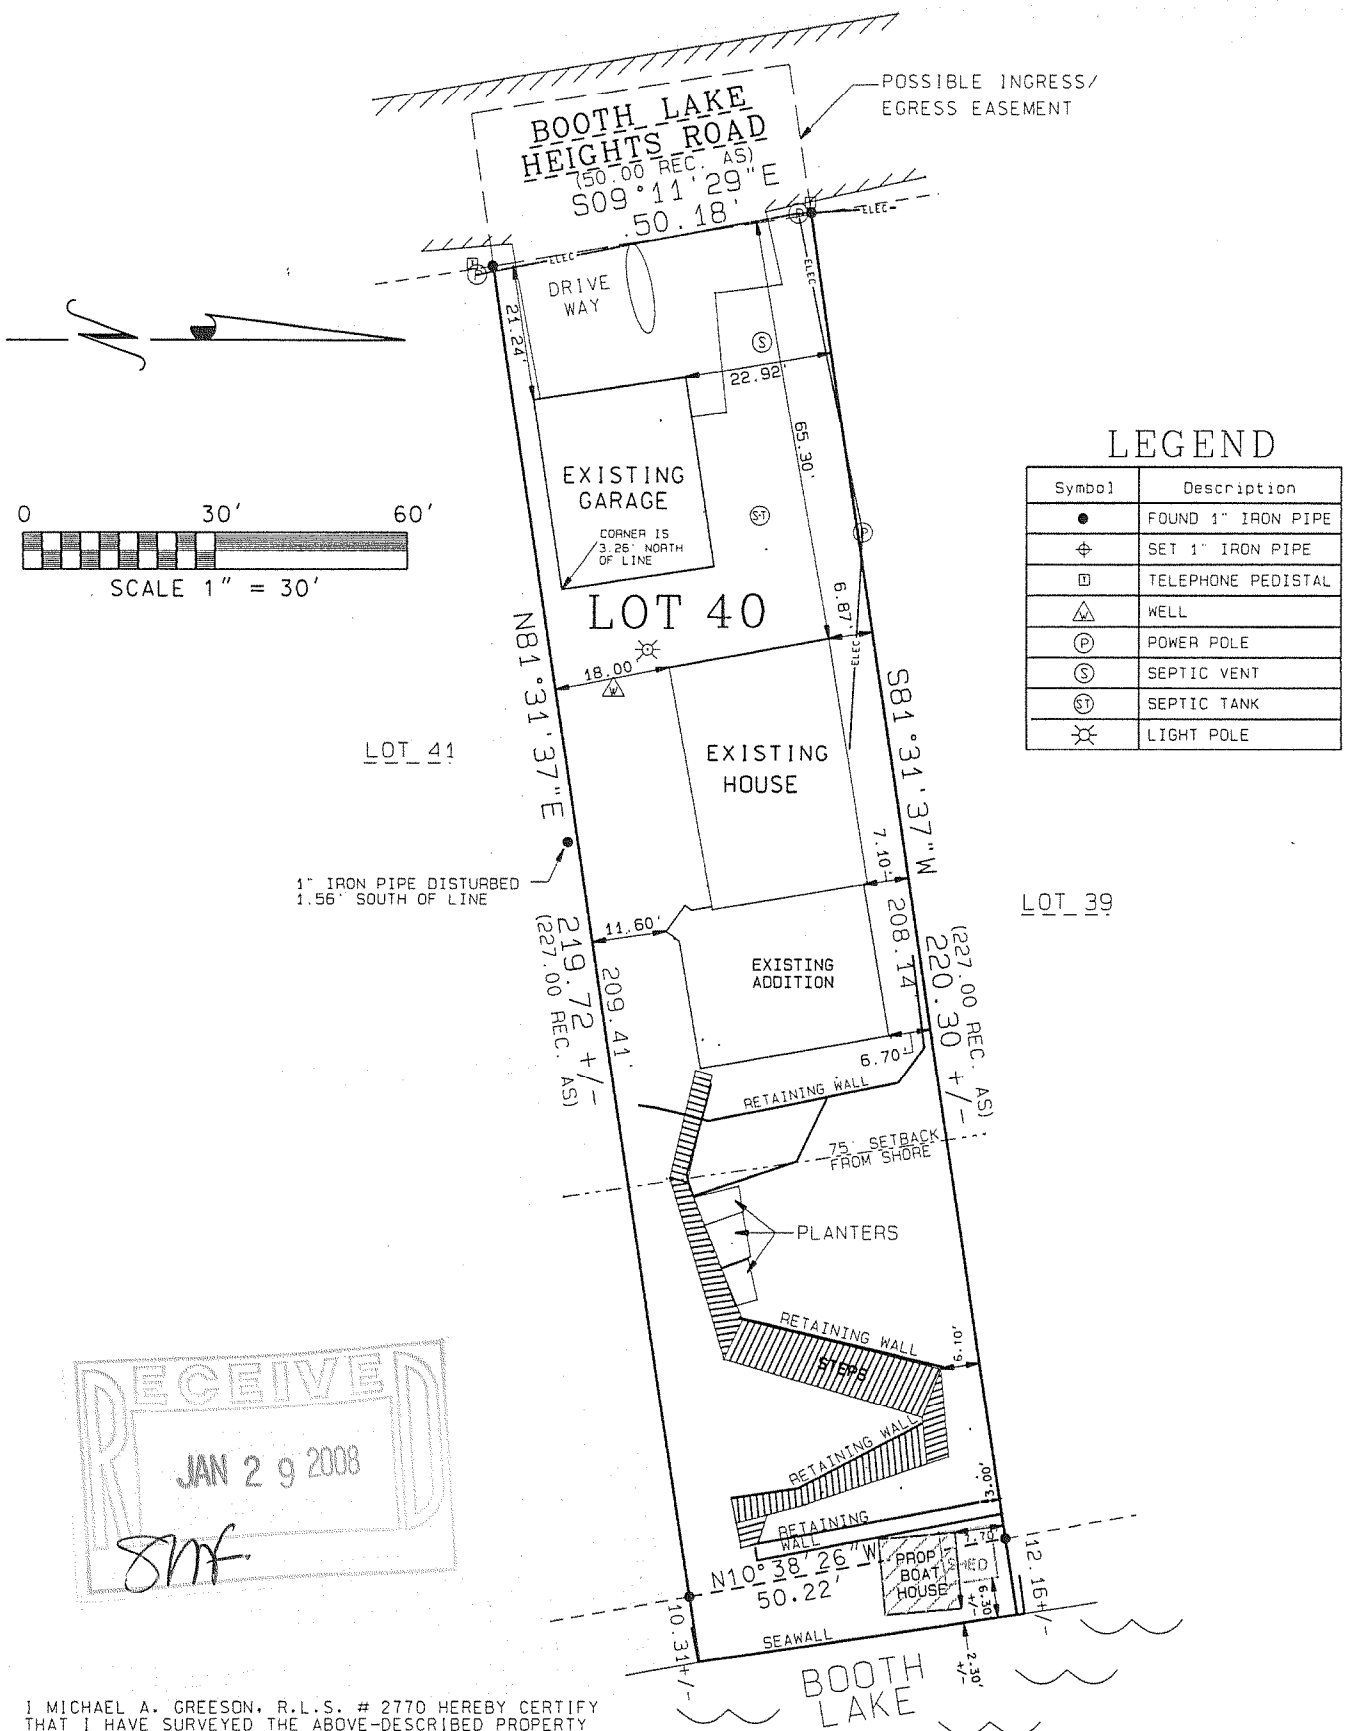

LEGEND

Symbol	Description
●	FOUND 1" IRON PIPE
⊕	SET 1" IRON PIPE
T	TELEPHONE PEDISTAL
W	WELL
P	POWER POLE
S	SEPTIC VENT
ST	SEPTIC TANK
☼	LIGHT POLE

RECEIVED
JAN 29 2008
SMF

I MICHAEL A. GREESON, R.L.S. # 2770 HEREBY CERTIFY THAT I HAVE SURVEYED THE ABOVE-DESCRIBED PROPERTY AND THE ABOVE MAP IS A TRUE REPRESENTATION THEREOF AND SHOWS THE SIZE AND LOCATION OF THE PROPERTY, ITS EXTERIOR BOUNDARIES, THE LOCATION OF ALL STRUCTURES THEREON, FENCES, APPARENT EASEMENTS AND ROADWAYS AND VISIBLE ENCROACHMENTS, IF ANY.

THIS SURVEY IS MADE FOR THE EXCLUSIVE USE OF THE PRESENT OWNERS OF THE PROPERTY, AND ALSO THOSE WHO PURCHASE, MORTGAGE OR INSURE THE TITLE THERETO WITHIN ONE (1) YEAR FROM DATE HEREOF, AND AS TO THEM I WARRANT THE ACCURACY OF SAID SURVEY MAP

Michael A. Greeson 12-10-07

MICHAEL A. GREESON, R.L.S. # 2770
RSV#07101SURVEY.DGN

WISCONSIN
Michael A. Greeson
S-2770
East Troy
Wis
LAND SURVEYOR
(ORIGINAL ONLY IF SEAL IS RED)

LBL - 34

417-859