

Plat of Survey


of

A parcel of land described in a Warranty Deed recorded February 16, 2005 as Document No. 631442 as shown below:


PART OF THE NORTHEAST 1/4 AND NORTHWEST 1/4 OF THE NORTHWEST 1/4 OF SECTION 6, TOWNSHIP 4 NORTH, RANGE 17 EAST, TOWN OF TROY, WALWORTH COUNTY, WISCONSIN, DESCRIBED AS FOLLOWS:
COMMENCING AT A POINT ON THE NORTH LINE OF LINE OF THE NORTHWEST 1/4 OF SAID SECTION 6, 488.73 FEET WEST OF THE NORTHEAST CORNER OF SAID 1/4 SECTION; THENCE SOUTH 03°06'56" WEST 490.09 FEET TO THE NORTH LINE OF S.T.H. "67"; THENCE SOUTH 61°12'18" WEST, ALONG THE NORTH LINE OF S.T.H. "67", 1045.69** FEET TO A POINT; THENCE THENCE NORTH 30°08'20" WEST 120.87 FEET TO A POINT (RECORDED AS NORTH 33°29'40" WEST); THENCE SOUTH 74°57'01" WEST 96.27 TO A POINT (RECORDED AS SOUTH 71°50'20" WEST 96.35 FEET); THENCE NORTH 29°28'59" WEST 74.01 FEET TO A POINT (RECORDED AS NORTH 32°46'40" WEST 74.05 FEET); THENCE NORTH 76°59'15" WEST 123.63 FEET TO A POINT (RECORDED AS NORTH 80°24'40" WEST 123.96 FEET); THENCE NORTH 02°56'14" EAST 891.36 FEET TO A POINT ON THE NORTH LINE OF THE NORTHWEST 1/4 OF SAID SECTION 6; THENCE SOUTH 87°28'20" EAST, ALONG THE NORTH LINE OF SAID 1/4 SECTION 1235.39 FEET TO THE PLACE OF BEGINNING.

** Note: The bearings and distances in this legal description are the same as shown on a Plat of Survey by Terrance E. Pisarek dated December 12, 2002 except that the distance shown in the legal description as 1045.69' is shown on the survey as 1075.69'. This appears to be a scrivener's error on the deed.


Surveyed for: **Tom & Cindy Surdyk**
N9613 State Road 67
Eagle, Wisconsin. 53119

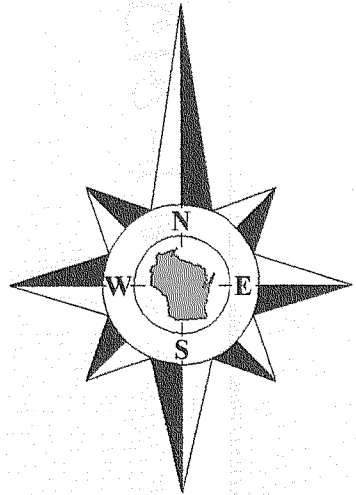

Bearings reference to the Wisconsin State Plane Coordinate System, South Zone.

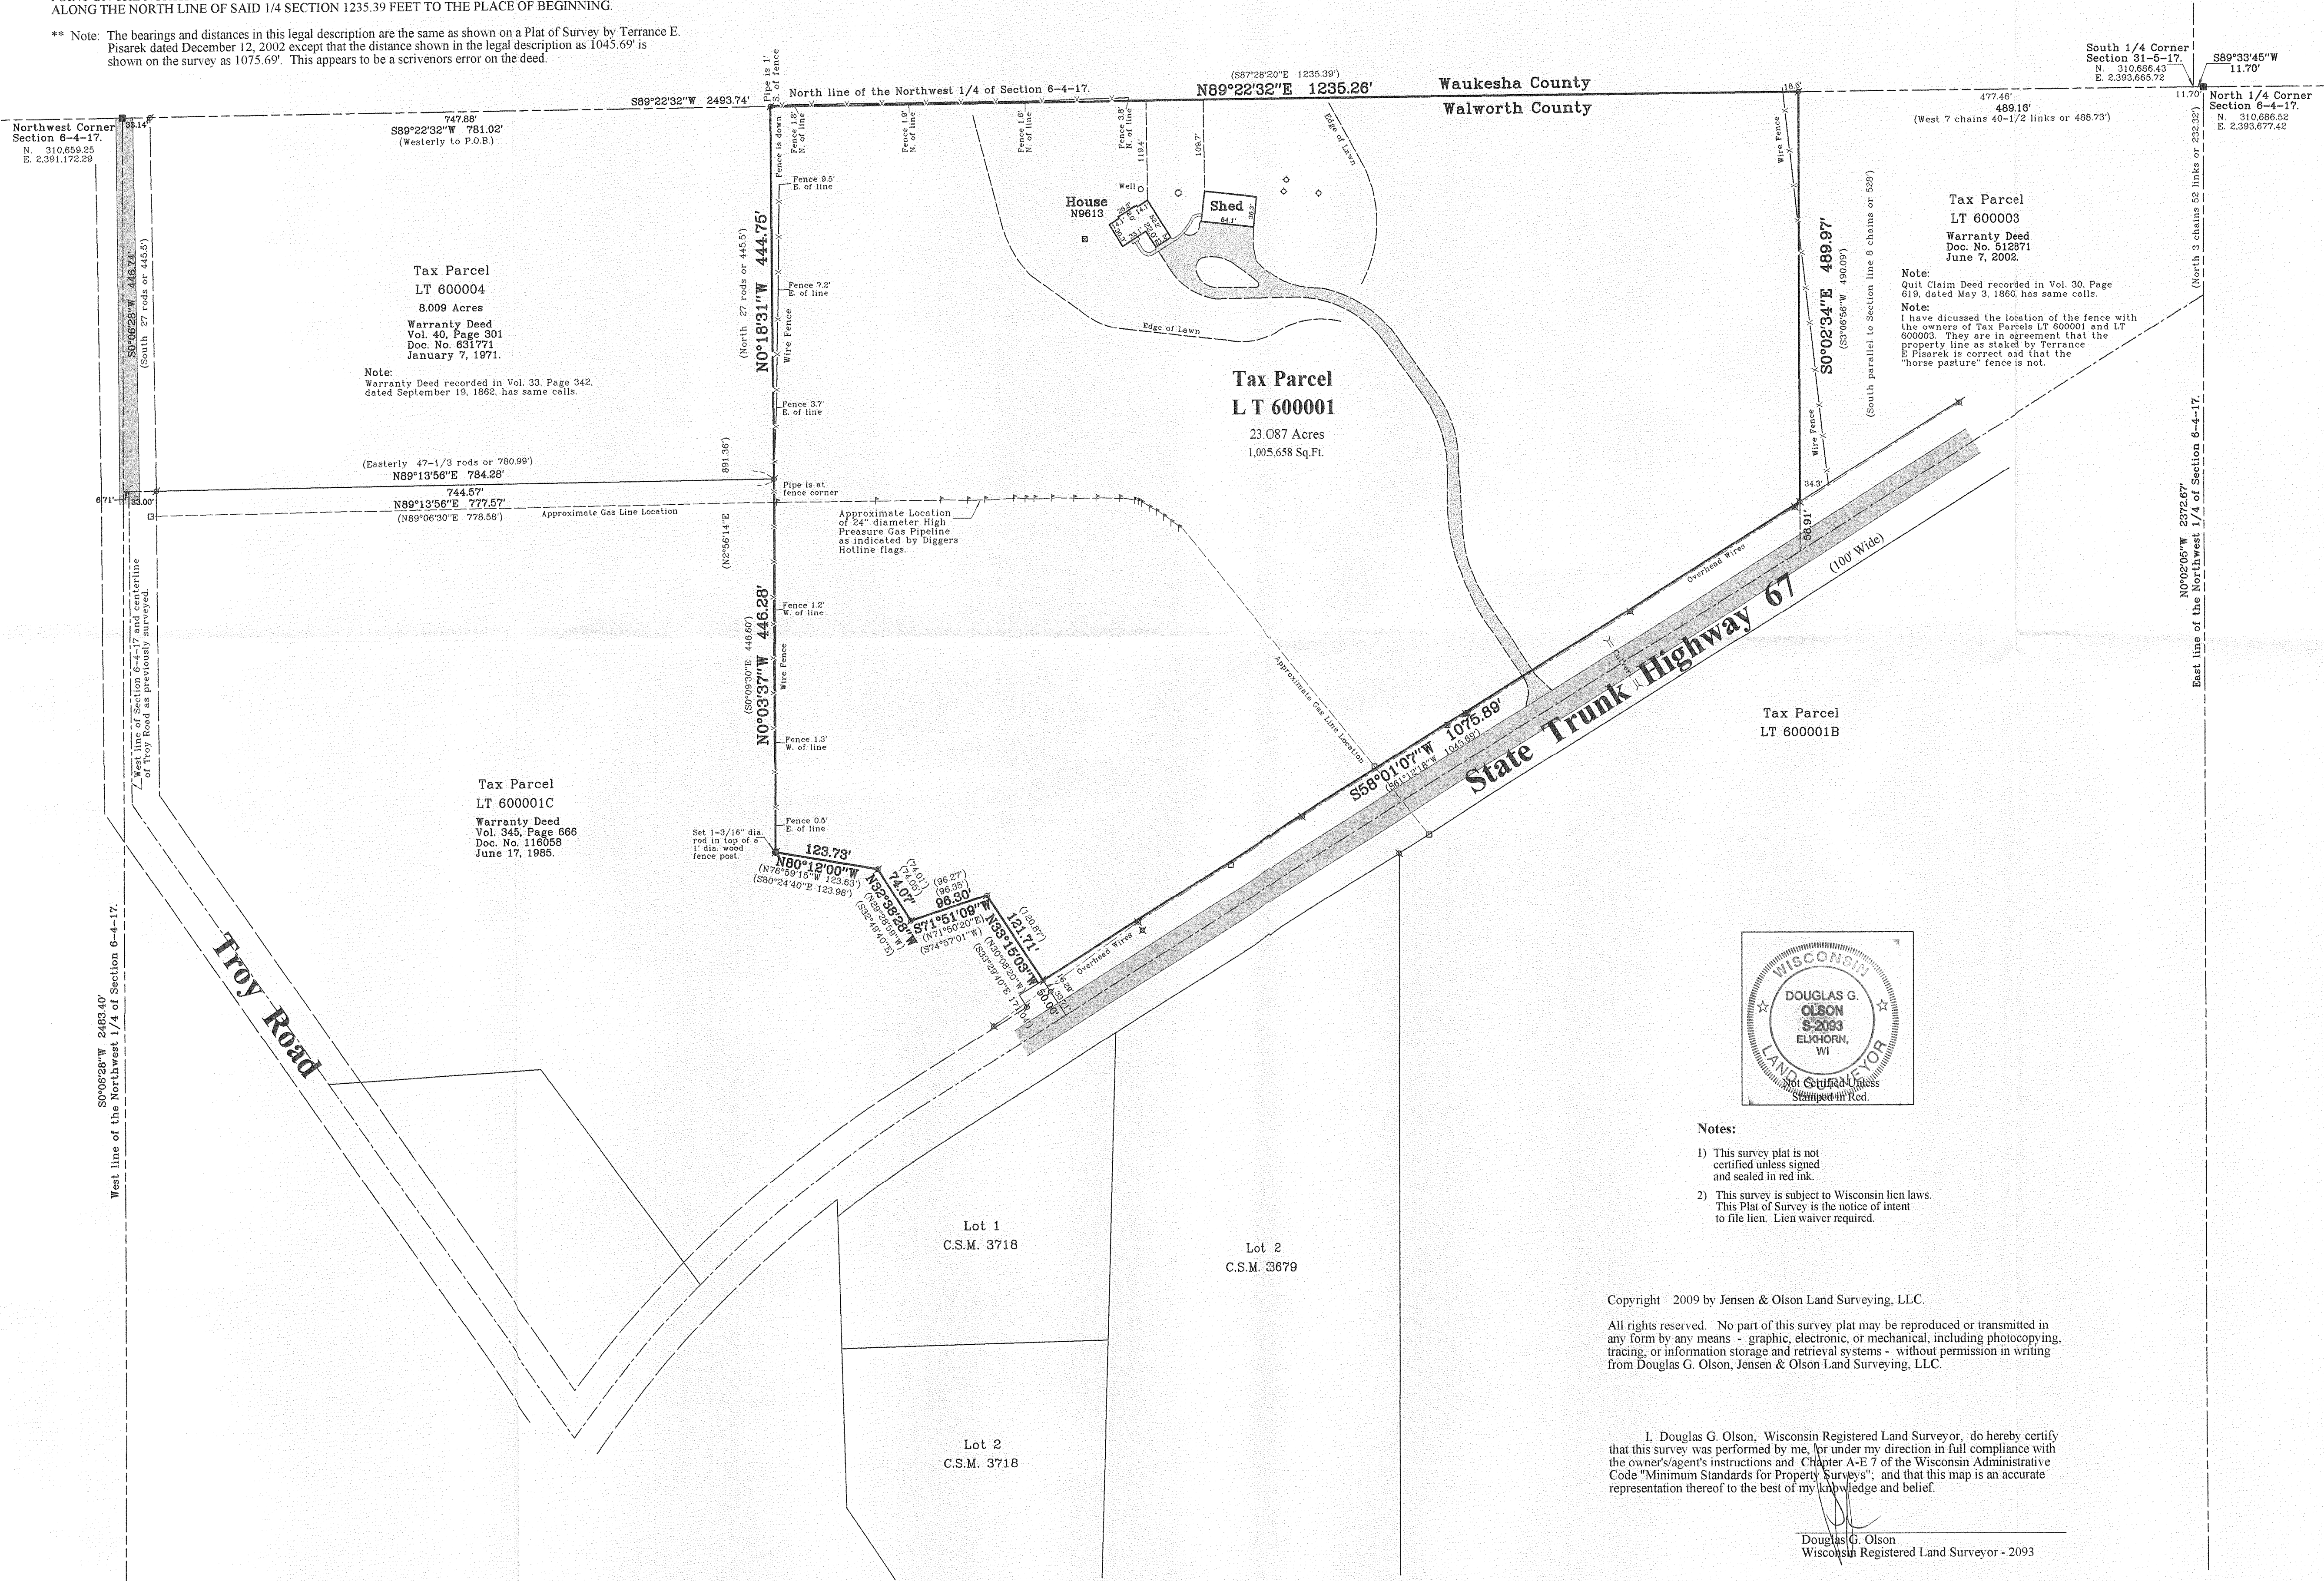

Survey date: May 7, 2009.
Revisions:

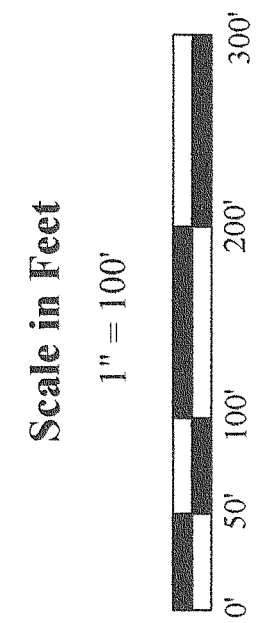

Jensen & Olson Land Surveying, LLC



45 South Wisconsin Street * P.O. Box 322 * Elkhorn, Wisconsin. 53121
Telephone: (262) 723-3434 * Facsimile: (262) 723-8044
Email: jensen.olson@elknet.net

Sheet 1 of 1 Sheets
Job Reference Number
2009.022

2009.022