PLAT OF SURVEY


Sundberg, Carlson and Associates, Inc.
Architects * Engineers * Land Surveyors * Planners
545 BAY VIEW ROAD, MUKWONAGO, WISCONSIN 53149 (414) 363-2004

FOR: Bret and Kathryn Strong **DATE:** 7/1/94

DESCRIPTION: LOT 13 & LOT 14 , BLOCK 11, MIRAMAR SUBDIVISION LOCATED IN SECTIONS 10 AND 11, TOWNSHIP 4 NORTH, RANGE 18 EAST, IN THE TOWN OF EAST TROY, WALWORTH COUNTY, WISCONSIN.

LEGEND

- • IRON PIPE FOUND
- ø IRON PIPE SET
- PP○ POWER POLE
- PAVEMENT

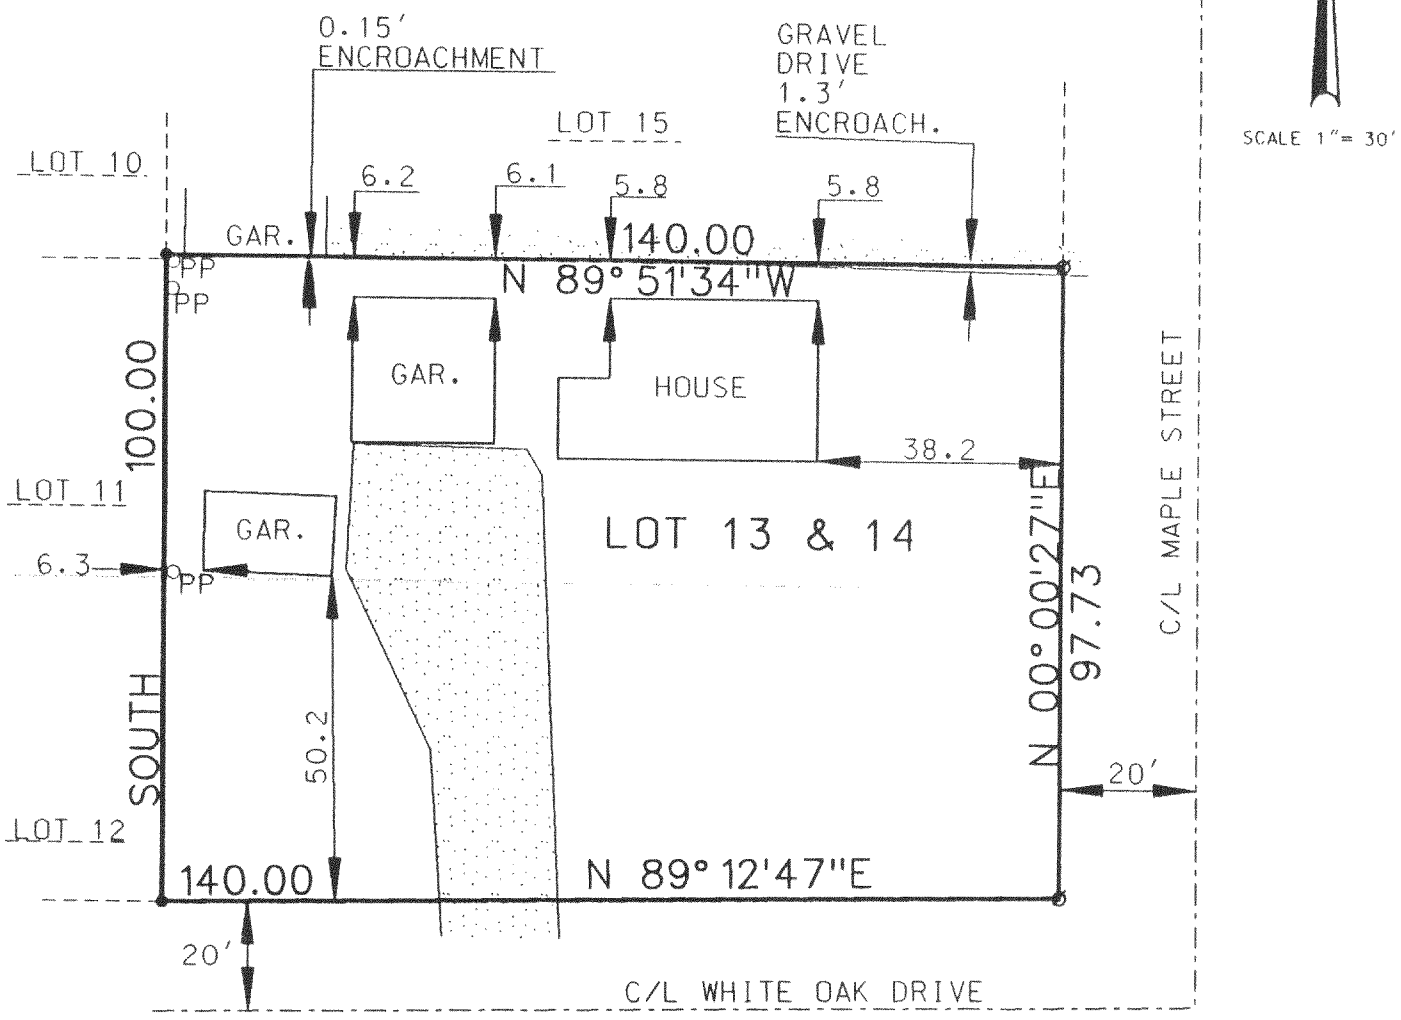

RECEIVED
DEC 28 1994

THE ABOVE MAP IS A TRUE REPRESENTATION THEREOF AND SHOWS THE SIZE AND LOCATION OF ALL THE PROPERTY, EXTERIOR BOUNDARIES, THE LOCATION OF ALL VISIBLE BOUNDARY FENCES, APPARENT EASEMENTS, ROADWAYS AND VISIBLE ENCROACHMENTS, IF ANY.

THIS SURVEY IS MADE FOR THE USE OF THE PRESENT OWNERS OF THE PROPERTY, AND ALSO THOSE WHO PURCHASE, MORTGAGE OR GUARANTEE TITLE THERETO WITHIN ONE (1) YEAR FROM DATE HERETO.

BRADFORD L. SPENCER, R.L.S. 2069

94259.DGN

WISCONSIN
BRADFORD L. SPENCER
S-2069
MUKWONAGO, WIS.
LAND SURVEYOR

THIS IS ORIGINAL PRINT ONLY IF SEAL IS IMPRINTED IN RED

PMR-116

418-1016