

PLAT OF SURVEY

OF

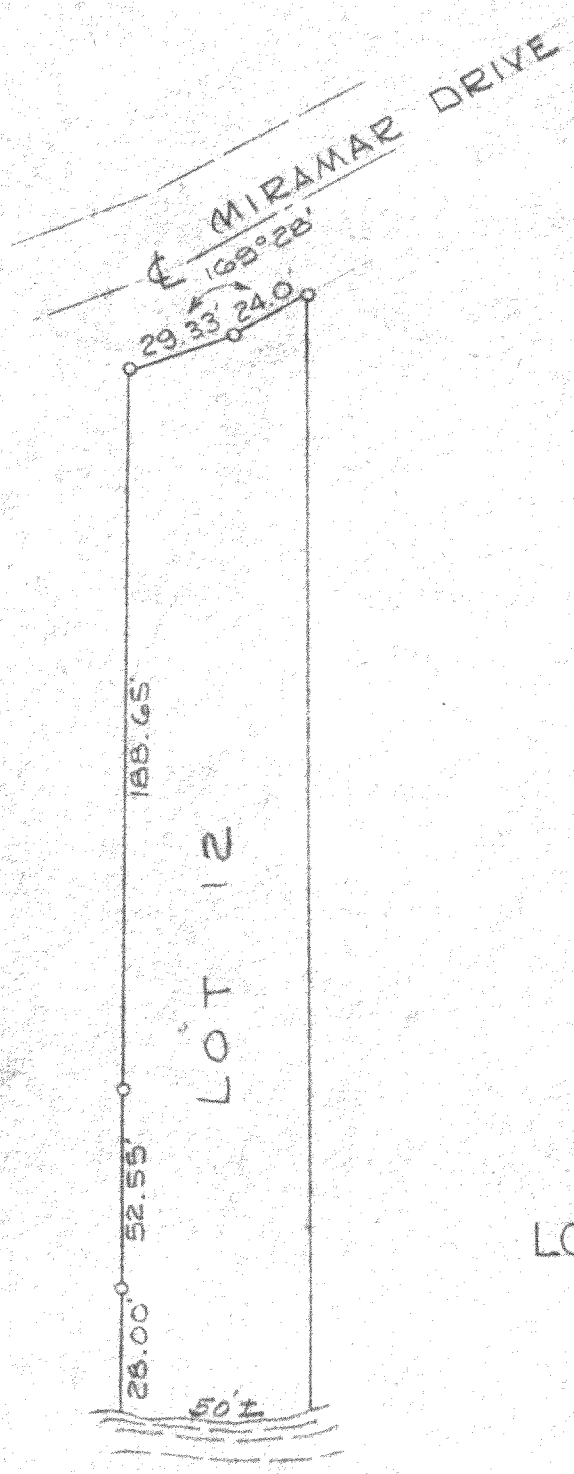

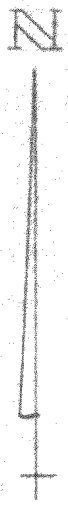

LOT 12 - Block 1, Miramar Subdivision
located in Section 10 & 11
T4N, R18E.
Walworth County,
Wisconsin

SURVEY AND PLAT BY

JENSEN & JOHNSON

CIVIL ENGINEERS AND SURVEYORS

Elkhorn, Wisconsin

LEGEND

o — Iron Pipe

• — Concrete Monument

Scale 1" = 50'

WE CERTIFY: That we have surveyed the above described property and that the plat shown hereon is an accurate survey and a true representation thereof and correctly shows the exterior boundary lines and all divisions of said property.

Date Nov. 1962

Lloyd L. Jensen

LLOYD L. JENSEN, Partner

Wisconsin Registered Land Surveyor, No. S-211

418-103A

PMR-11

NO. 1750—400—1-30-56

418-103A