PLAT OF SURVEY

DATE: 12/19/94

FOR: AMERICAN CLASSIC PROPERTIES

DESCRIPTION: PARCEL 2 OF CSM #1153 BEING A REDIVISION OF LOT 4 AND PART OF LOT 5, BLOCK 2, FREES PARK, A SUBDIVISION LOCATED IN PART OF THE SOUTH 1/2 OF SECTION 4, TOWN 4 NORTH, RANGE 18 EAST, TOWN OF EAST TROY, WALWORTH COUNTY, WISCONSIN.

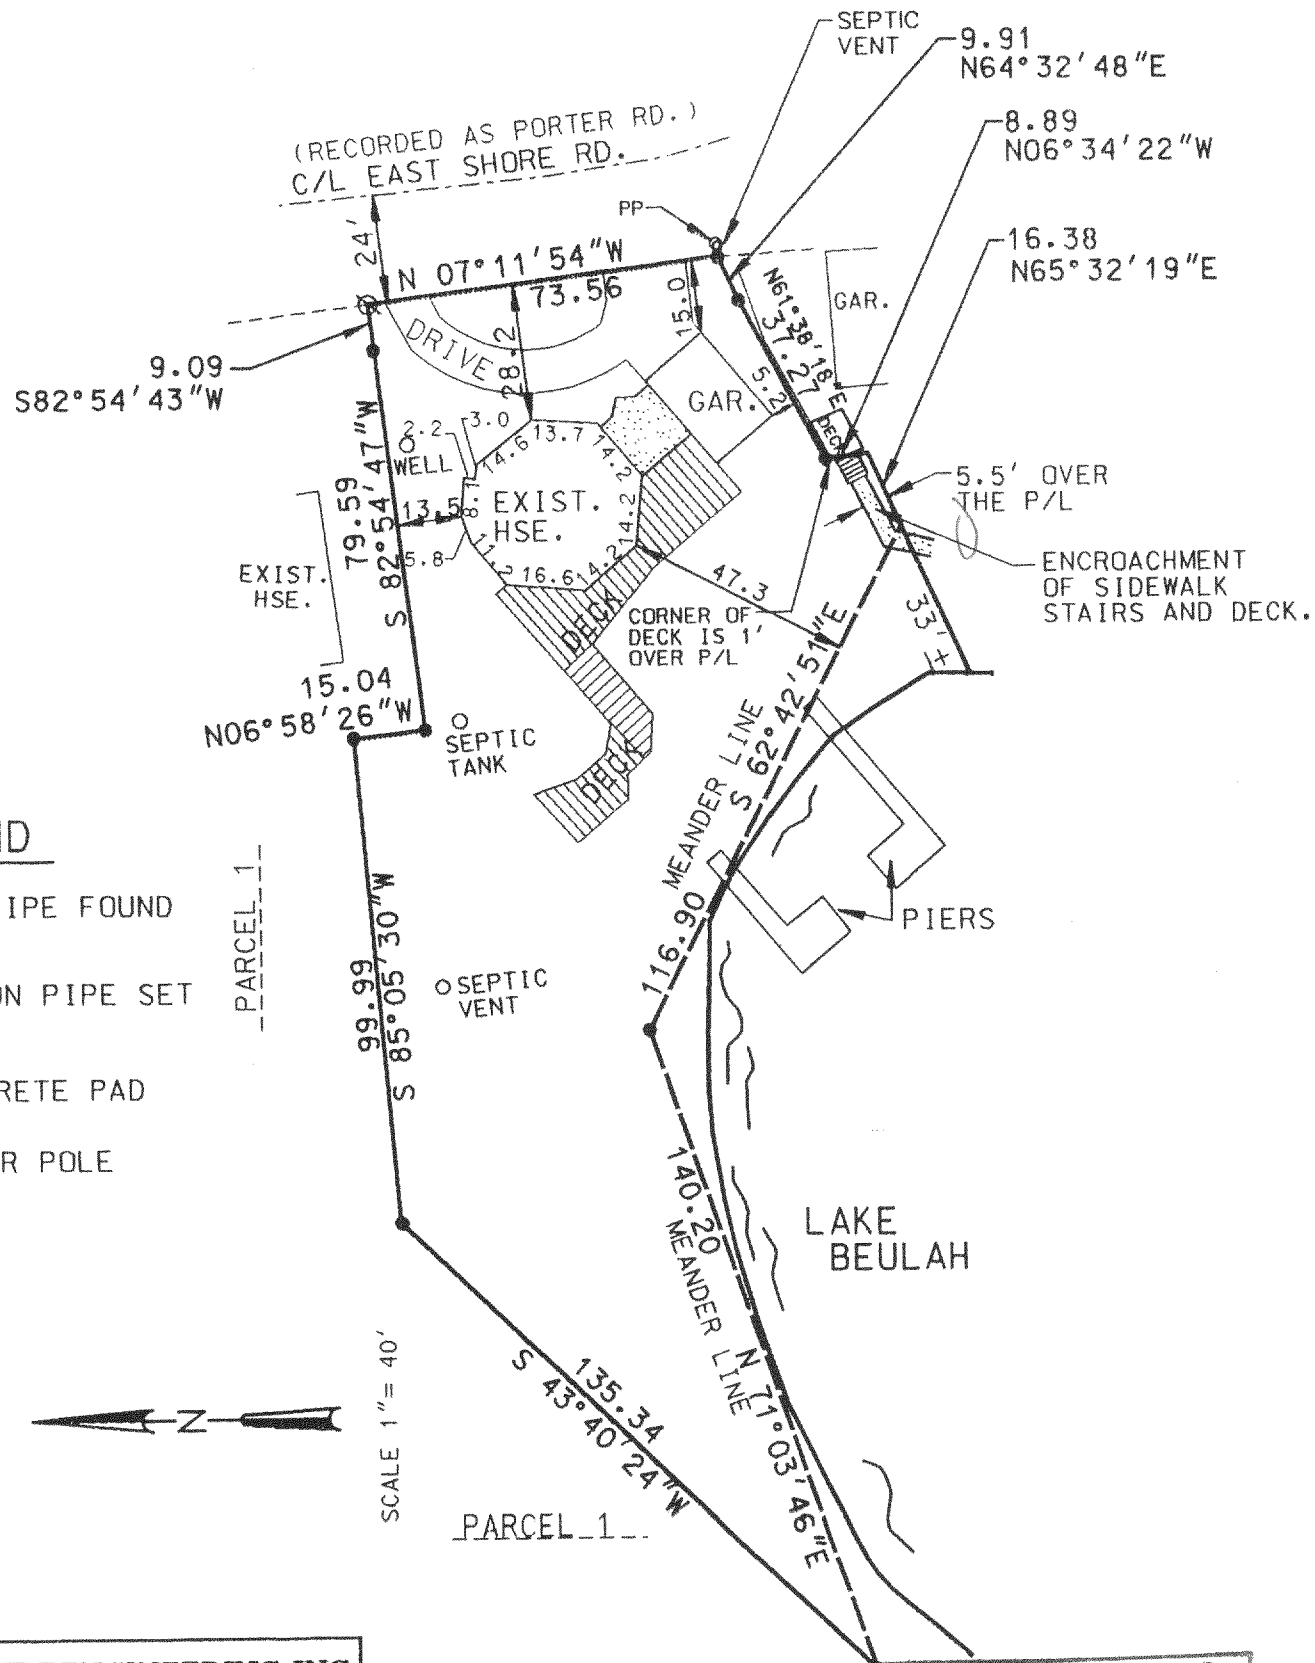

LEGEND

- ● IRON PIPE FOUND
- ⊗ 1" IRON PIPE SET
- CONCRETE PAD
- PP POWER POLE

RSV ENGINEERING, INC
ENGINEERS, PLANNERS, SURVEYORS
CONSTRUCTION MANAGERS
545 BAY VIEW ROAD, MUKWONAGO, WISCONSIN 53149 (414) 363-2004

RECEIVED SEP

THE ABOVE MAP IS A TRUE REPRESENTATION THEREOF AND SHOWS THE SIZE AND LOCATION OF ALL THE PROPERTY, EXTERIOR BOUNDARIES, THE LOCATION OF ALL VISIBLE BOUNDARY FENCES, APPARENT EASEMENTS, ROADWAYS AND VISIBLE ENCROACHMENTS, IF ANY.

THIS SURVEY IS MADE FOR THE USE OF THE PRESENT OWNERS OF THE PROPERTY, AND ALSO THOSE WHO PURCHASE, MORTGAGE OR GUARANTEE TITLE THERETO WITHIN ONE (1) YEAR FROM DATE HERETO.

THIS IS ORIGINAL PRINT ONLY IF SEAL IS IMPRINTED IN RED

WISCONSIN BRADFORD L. SPENCER S-2069 MUKWONAGO, WIS. LAND SURVEYOR

BRADFORD L. SPENCER, R.L.S. 2069
RSV#94351.DGN

418-1054

PA-1153-2