PLAT OF SURVEY

RSV ENGINEERING, INC
ENGINEERS, PLANNERS, SURVEYORS
CONSTRUCTION MANAGERS,
ENVIRONMENTAL SCIENTISTS
801 MAIN STREET, MUKWONAGO, WISCONSIN 53149 (414) 363-2004

FOR: HERB & EVA HACKBARTH DATE: 8/5/97


DESCRIPTION: LOT 14 OF ISLAND CLUB LOCATED IN THE NW 1/4, SW 1/4, SE 1/4 AND SW 1/4 OF THE SW 1/4 OF SECTION 4, TOWN 4 NORTH, RANGE 18 EAST, TOWN OF EAST TROY, WALWORTH COUNTY, WISCONSIN.

LEGEND

- ● IRON PIPE FOUND
- Ø 1" X 24" IRON PIPE SET

N

SCALE 1"= 60'

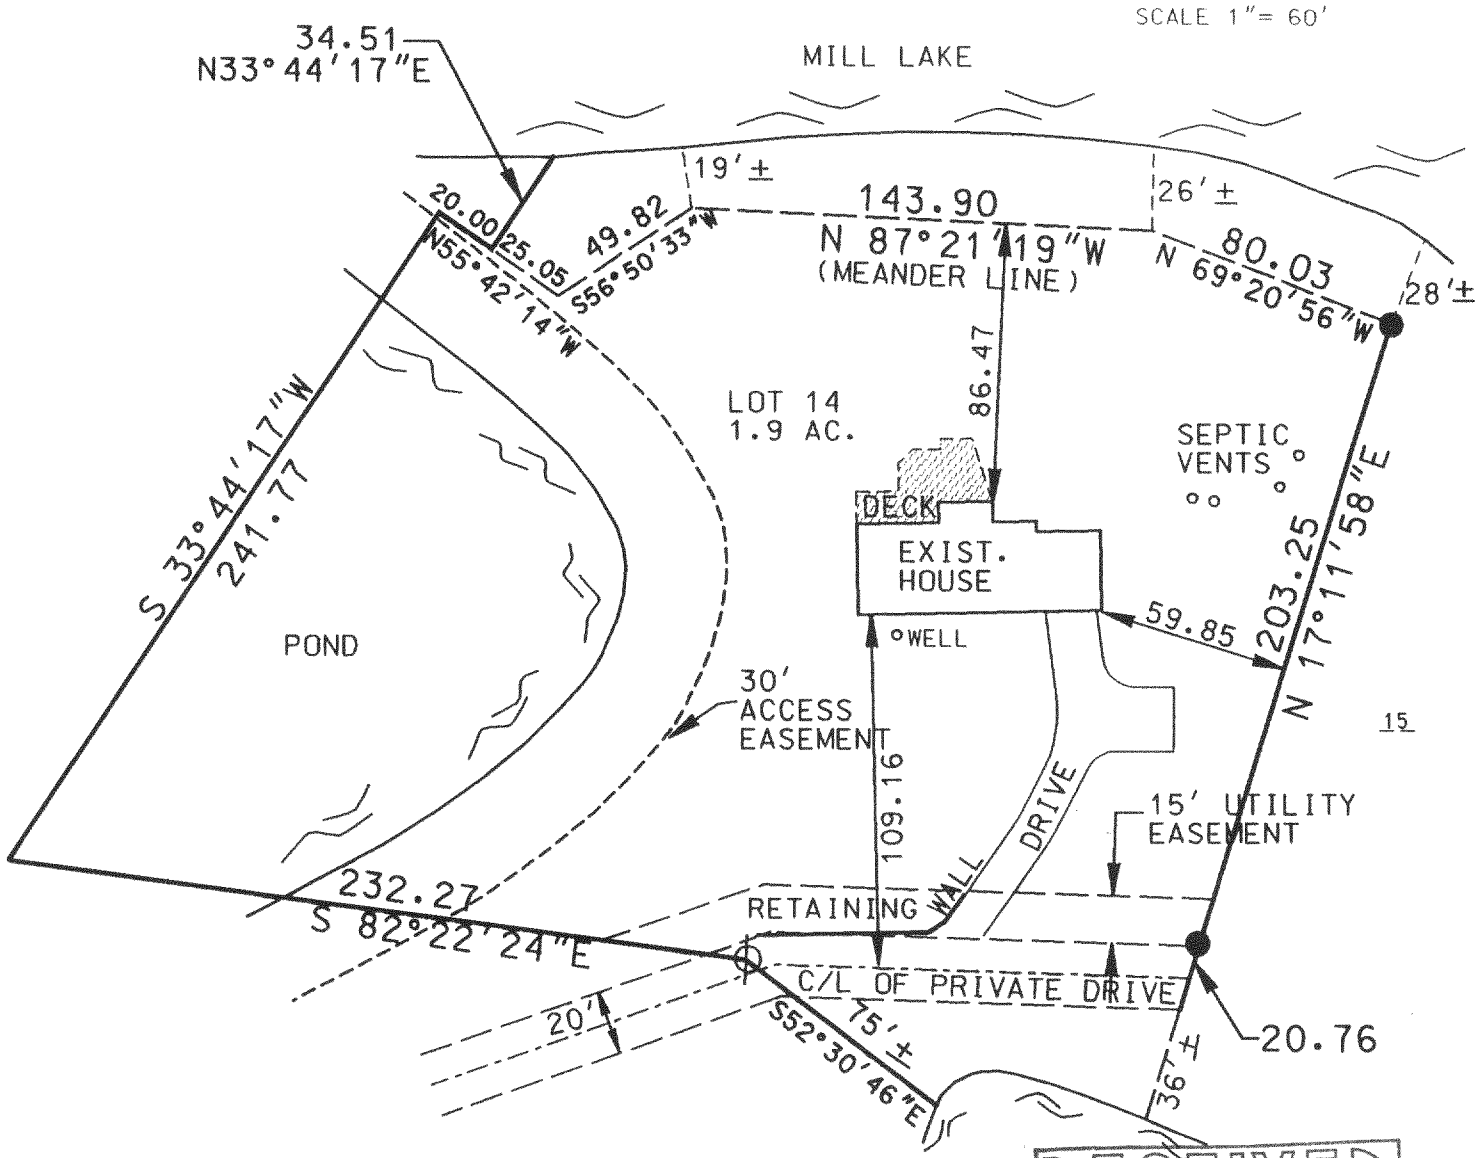

THE ABOVE MAP IS A TRUE REPRESENTATION THEREOF AND SHOWS THE SIZE AND LOCATION OF ALL THE PROPERTY, EXTERIOR BOUNDARIES, THE LOCATION OF ALL VISIBLE BOUNDARY FENCES, APPARENT EASEMENTS, ROADWAYS AND VISIBLE ENCROACHMENTS, IF ANY.

THIS SURVEY IS MADE FOR THE USE OF THE PRESENT OWNERS OF THE PROPERTY, AND ALSO THOSE WHO PURCHASE, MORTGAGE OR GUARANTEE TITLE THERETO WITHIN ONE (1) YEAR FROM DATE HERETO.

RECEIVED
MAR 3 1998

WISCONSIN
BRADFORD L. SPENCER
S-2069
MUKWONAGO, WIS.
LAND SURVEYOR

THIS IS ORIGINAL PRINT ONLY IF SEAL IS IMPRINTED IN RED

BRADFORD L. SPENCER, R.L.S. 2069
RSV# 97185

418-1232

P1-14