
#31-72

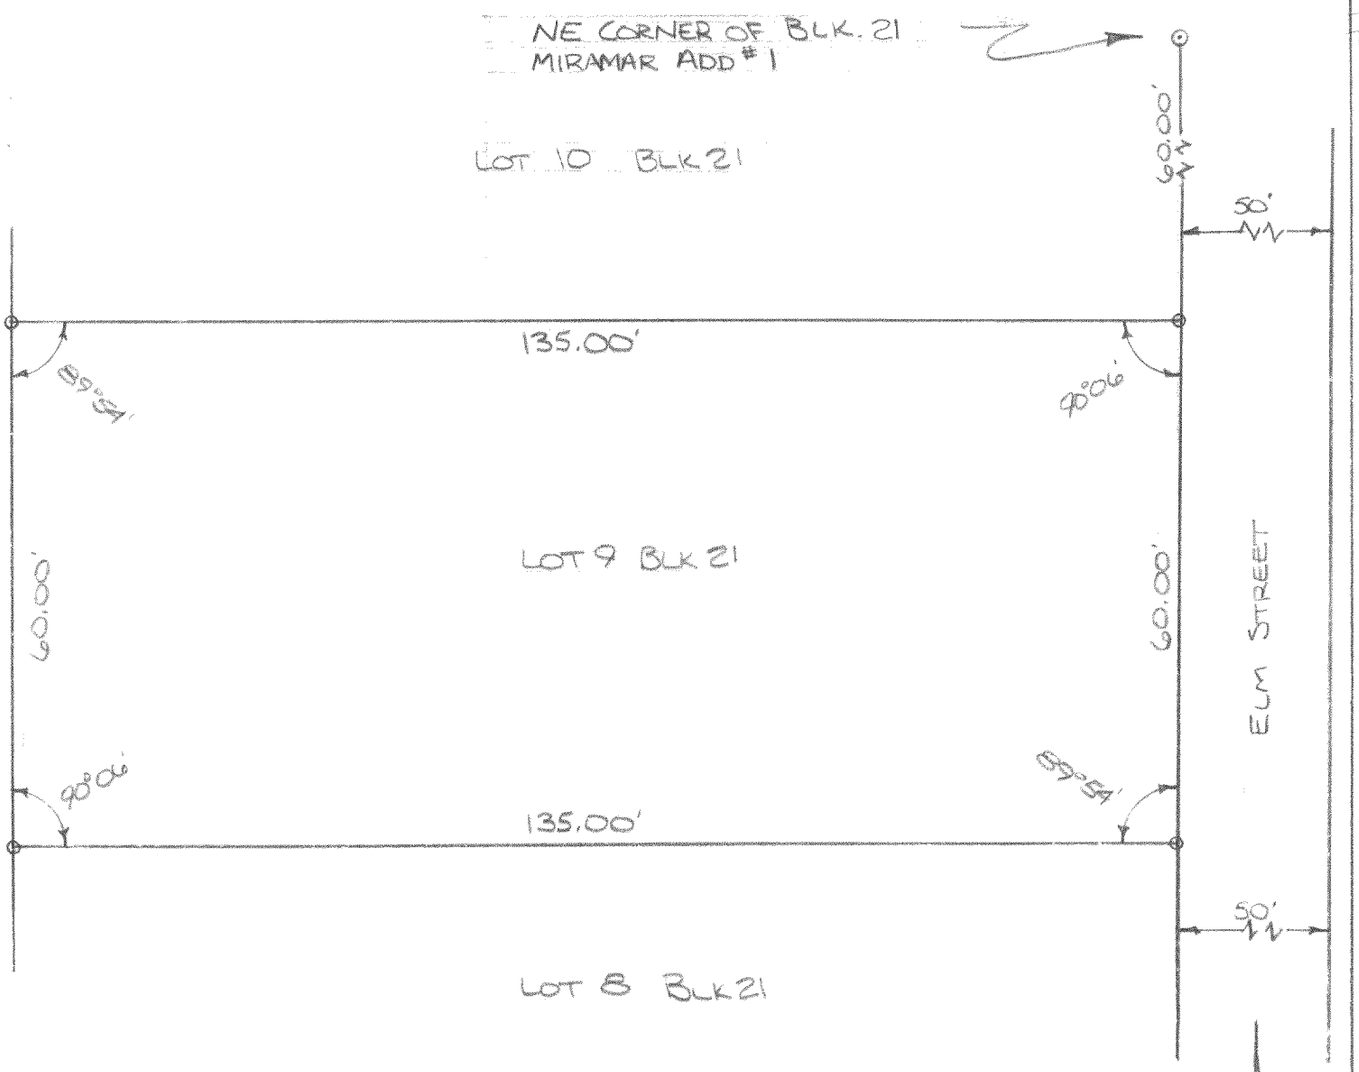

DESCRIPTION: Lot 9, Block 21, of Miramar Add. No. 1, located in the NE¼ of Section 10, East Troy Twp., Walworth County, Wisconsin.

CERTIFICATE: I, James F. Biagi, surveyor, do hereby certify that I have surveyed the lands hereon described.

DATE: May 22, 1972

James F. Biagi R.L.S. 272

WISCONSIN JAMES F. BIAGI MILWAUKEE, WIS. LAND SURVEYOR

o-INDICATES IRON PIPE

PM21-43

418-124B