982477
982477S1.DWG

DEGEN, FOAT SURVEYING ASSOCIATES

100 SOUTH SECOND STREET
WATERFORD, WISCONSIN
(414)534-5404 (FAX)534-2022

PLAT OF SURVEY

THE SOUTH 1/2 OF LOT 10 IN ROMADKA PARK, IN THE SOUTHEAST 1/4 OF SECTION 5, AND THE NORTHEAST 1/4 OF SECTION 8, TOWNSHIP 4 NORTH, RANGE 18 EAST, IN THE COUNTY OF WALWORTH AND STATE OF WISCONSIN.

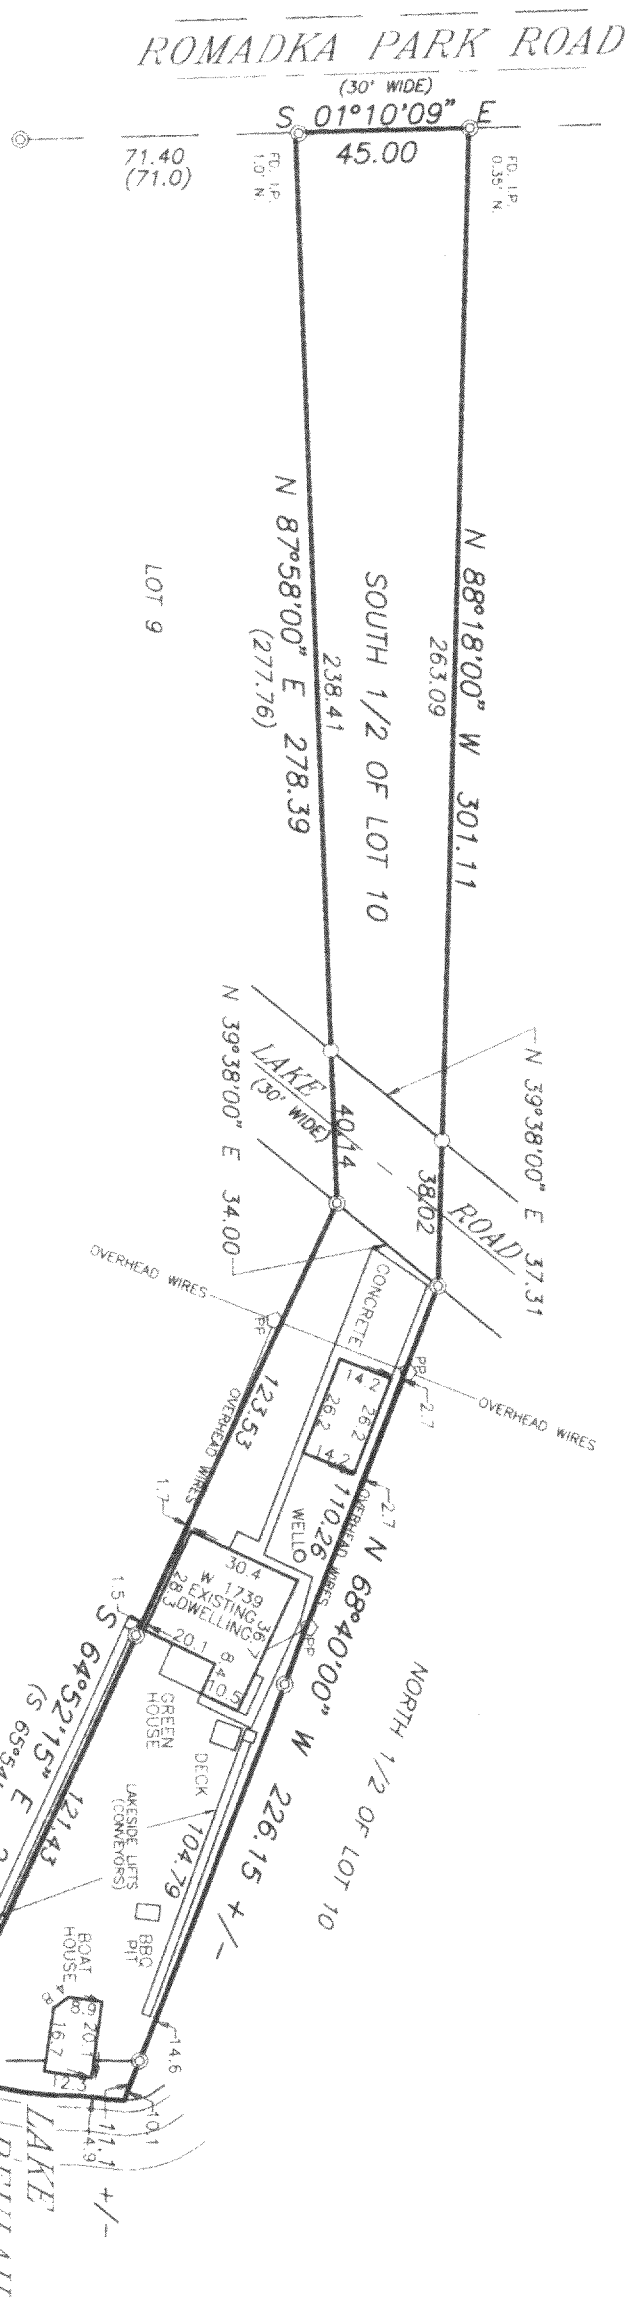

SURVEY PREPARED FOR: JIM MACIOSEK
28020 KRAMER DRIVE
WATERFORD, WI 53185

SCALE: 1" = 50'

LEGEND

- ◎ = FOUND IRON PIPE
- ○ = SET IRON PIPE
- ○PP = POWER POLE
- ( ) = RECORDED AS

RECEIVED
MAR 30 1999

I HEREBY CERTIFY THAT I HAVE SURVEYED THE ABOVE DESCRIBED PROPERTY AND THE ABOVE MAP IS A TRUE REPRESENTATION THEREOF AND SHOWS THE SIZE AND LOCATION OF THE PROPERTY, THE LOCATION OF ALL VISIBLE STRUCTURES AND DIMENSIONS OF ALL PRINCIPAL BUILDINGS THEREON, BOUNDARY FENCES, APPARENT EASEMENTS, ROADWAY AND VISIBLE ENCROACHMENTS, IF ANY.

THIS SURVEY IS MADE FOR THE PRESENT OWNERS OF THE PROPERTY, AND ALSO THOSE WHO PURCHASE, OR GUARANTEE THE TITLE THERETO WITHIN (1) YEAR FROM THE DATE HEREOF.

DATED AT WATERFORD, WI THIS 8th DAY OF JANUARY 19 99

RECERTIFIED

Gary D. Foat

418-1273
PRP-11