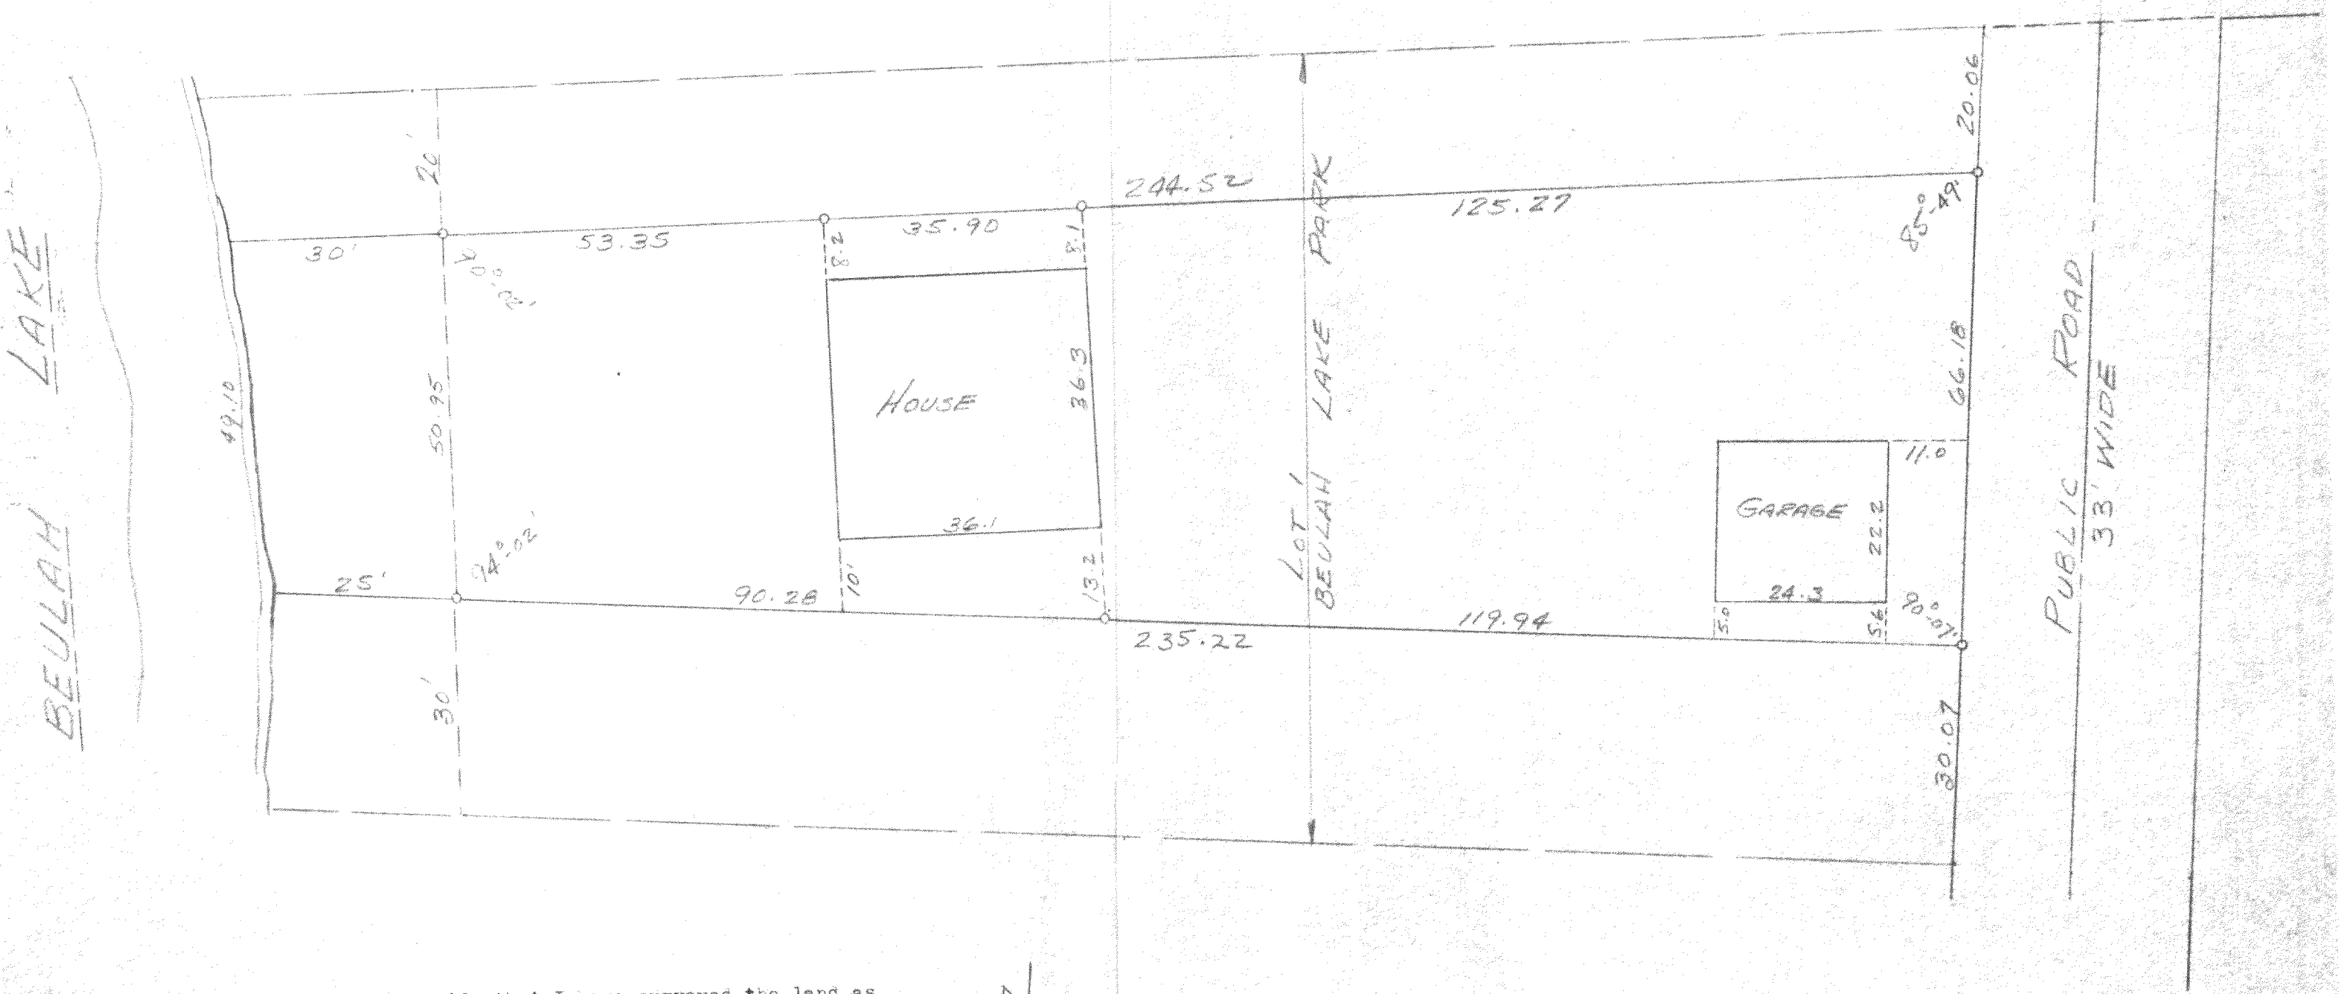


I, Lloyd L. Jensen, do hereby certify that I have surveyed the land as described herein: Lot one (1) of Beulah Lake Park except the North twenty (20) feet thereof and also except the South thirty (30) feet thereof, being of Section Four (4), T4N R18E of the 4th P.M., Town of East Troy, Walworth County, Wisconsin and that the above plat is an accurate survey and a true representation thereof and correctly shows the exterior boundary lines and location of buildings on said property and the correct measurements thereof.

August 5, 1966

Lloyd L. Jensen, Surveyor
Elkhorn, Wisconsin

WISCONSIN LLOYD L. JENSEN S-211 ELKHORN, WIS. LAND SURVEYOR

418-129 J

# PLAT OF SURVEY
OF

LOT 1 (EXCEPT N 20' AND S 30') BEULAH LAKE PARK SUBDIVISION SECTION 4, T4N-R18E, WALWORTH COUNTY, WIS.

Lloyd L. Jensen
SURVEYOR

SCALE 1" = 20'

DATE AUGUST 5, 1966

PBL-2