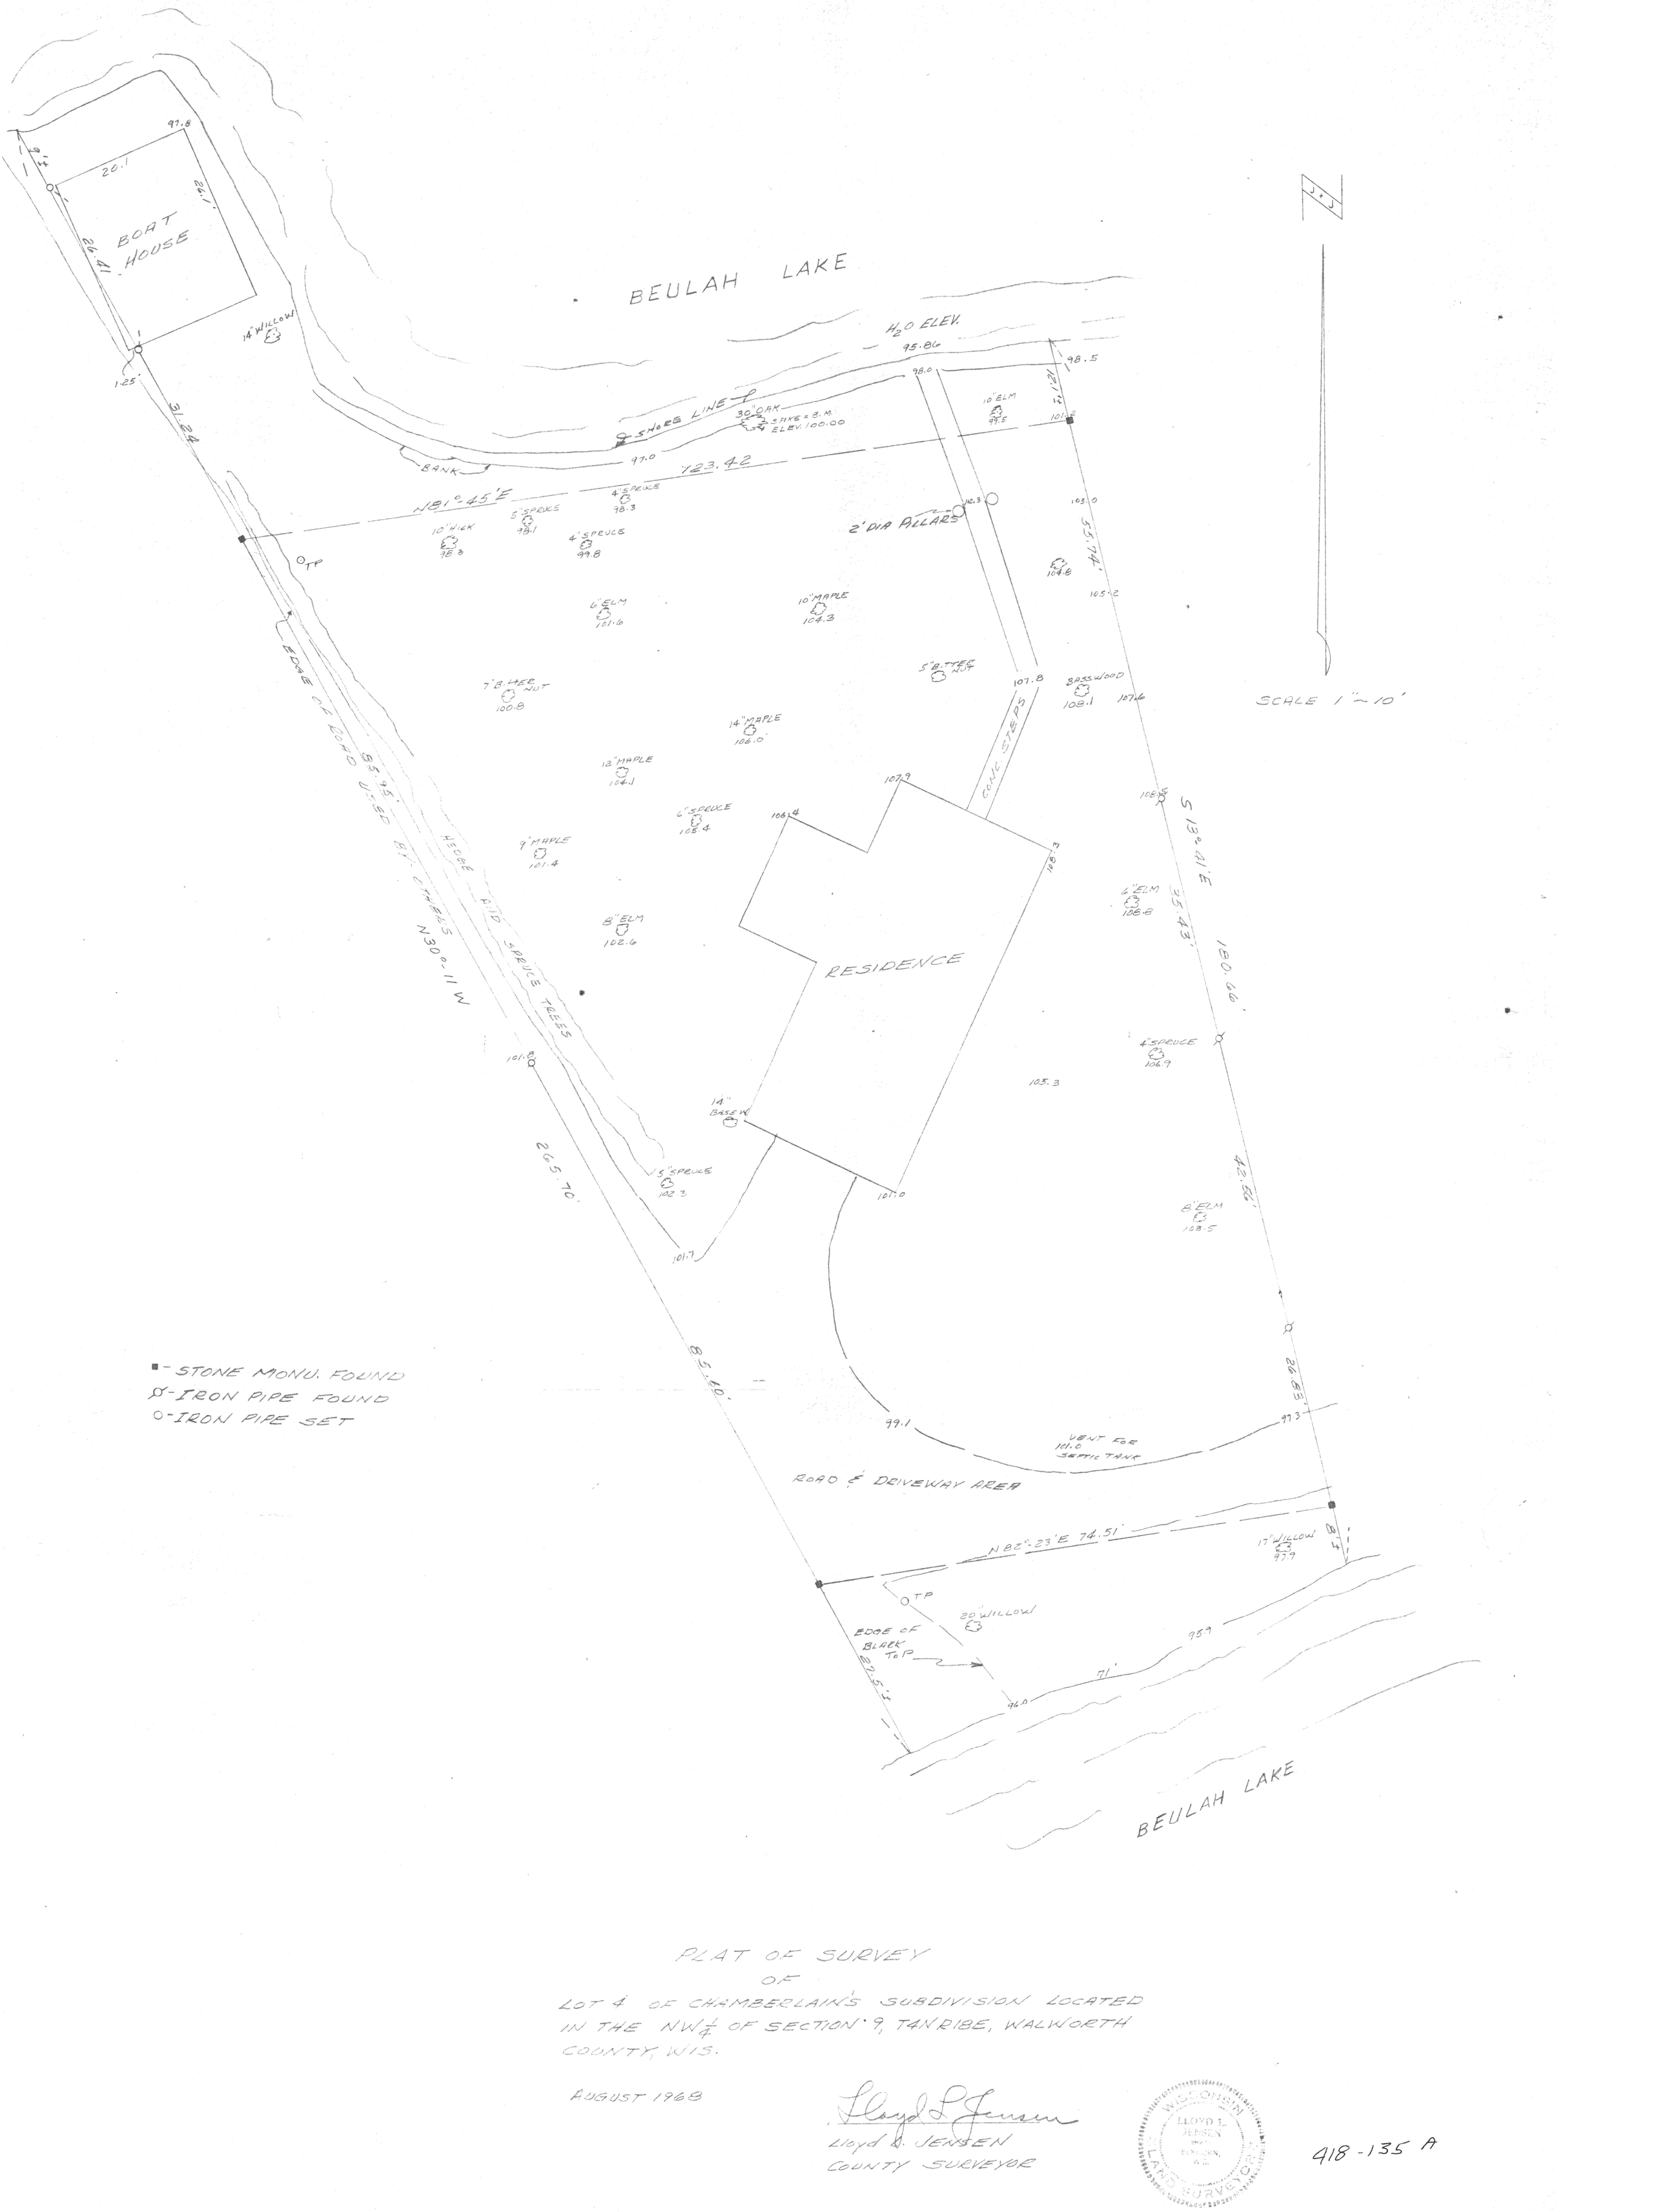


■ - STONE MONU. FOUND
⊗ - IRON PIPE FOUND
○ - IRON PIPE SET

PLAT OF SURVEY
OF
LOT 4 OF CHAMBERLAIN'S SUBDIVISION LOCATED IN THE NW¼ OF SECTION 9, T4N R18E, WALWORTH COUNTY, WIS.

AUGUST 1968

Lloyd L Jensen
Lloyd L. JENSEN
COUNTY SURVEYOR

WISCONSIN
LLOYD L. JENSEN
LAND SURVEYOR

418-135 A