RECEIVED
MAR 1 5 2000


PLAT OF SURVEY

FOR

RON ANDERS

LOCATION: N9164 HUMPHREY LANE

DESCRIPTION: All of LOT 9 BEULAH MANOR, excepting the Southerly 11 Feet thereof; also part of LOT 8 of said BEULAH Manor, Walworth County, Wisconsin, to-wit: Starting at a point on the Westerly line of said LOT NO. 8 said point being S.36°34'W., and 7.28 feet distant from the Northwesterly corner of said LOT 8 and running thence S.71°26'E., to the shore of Beulah Lake, thence Southerly along shore line to the South East corner of said LOT 8, thence Westerly along the South line of LOT 8 to the Southwest corner of said lot, thence Northerly along the West line of said lot to the place of beginning, said land being in the West 1/2 of Section 3, Town 4 North, Range 18 East.

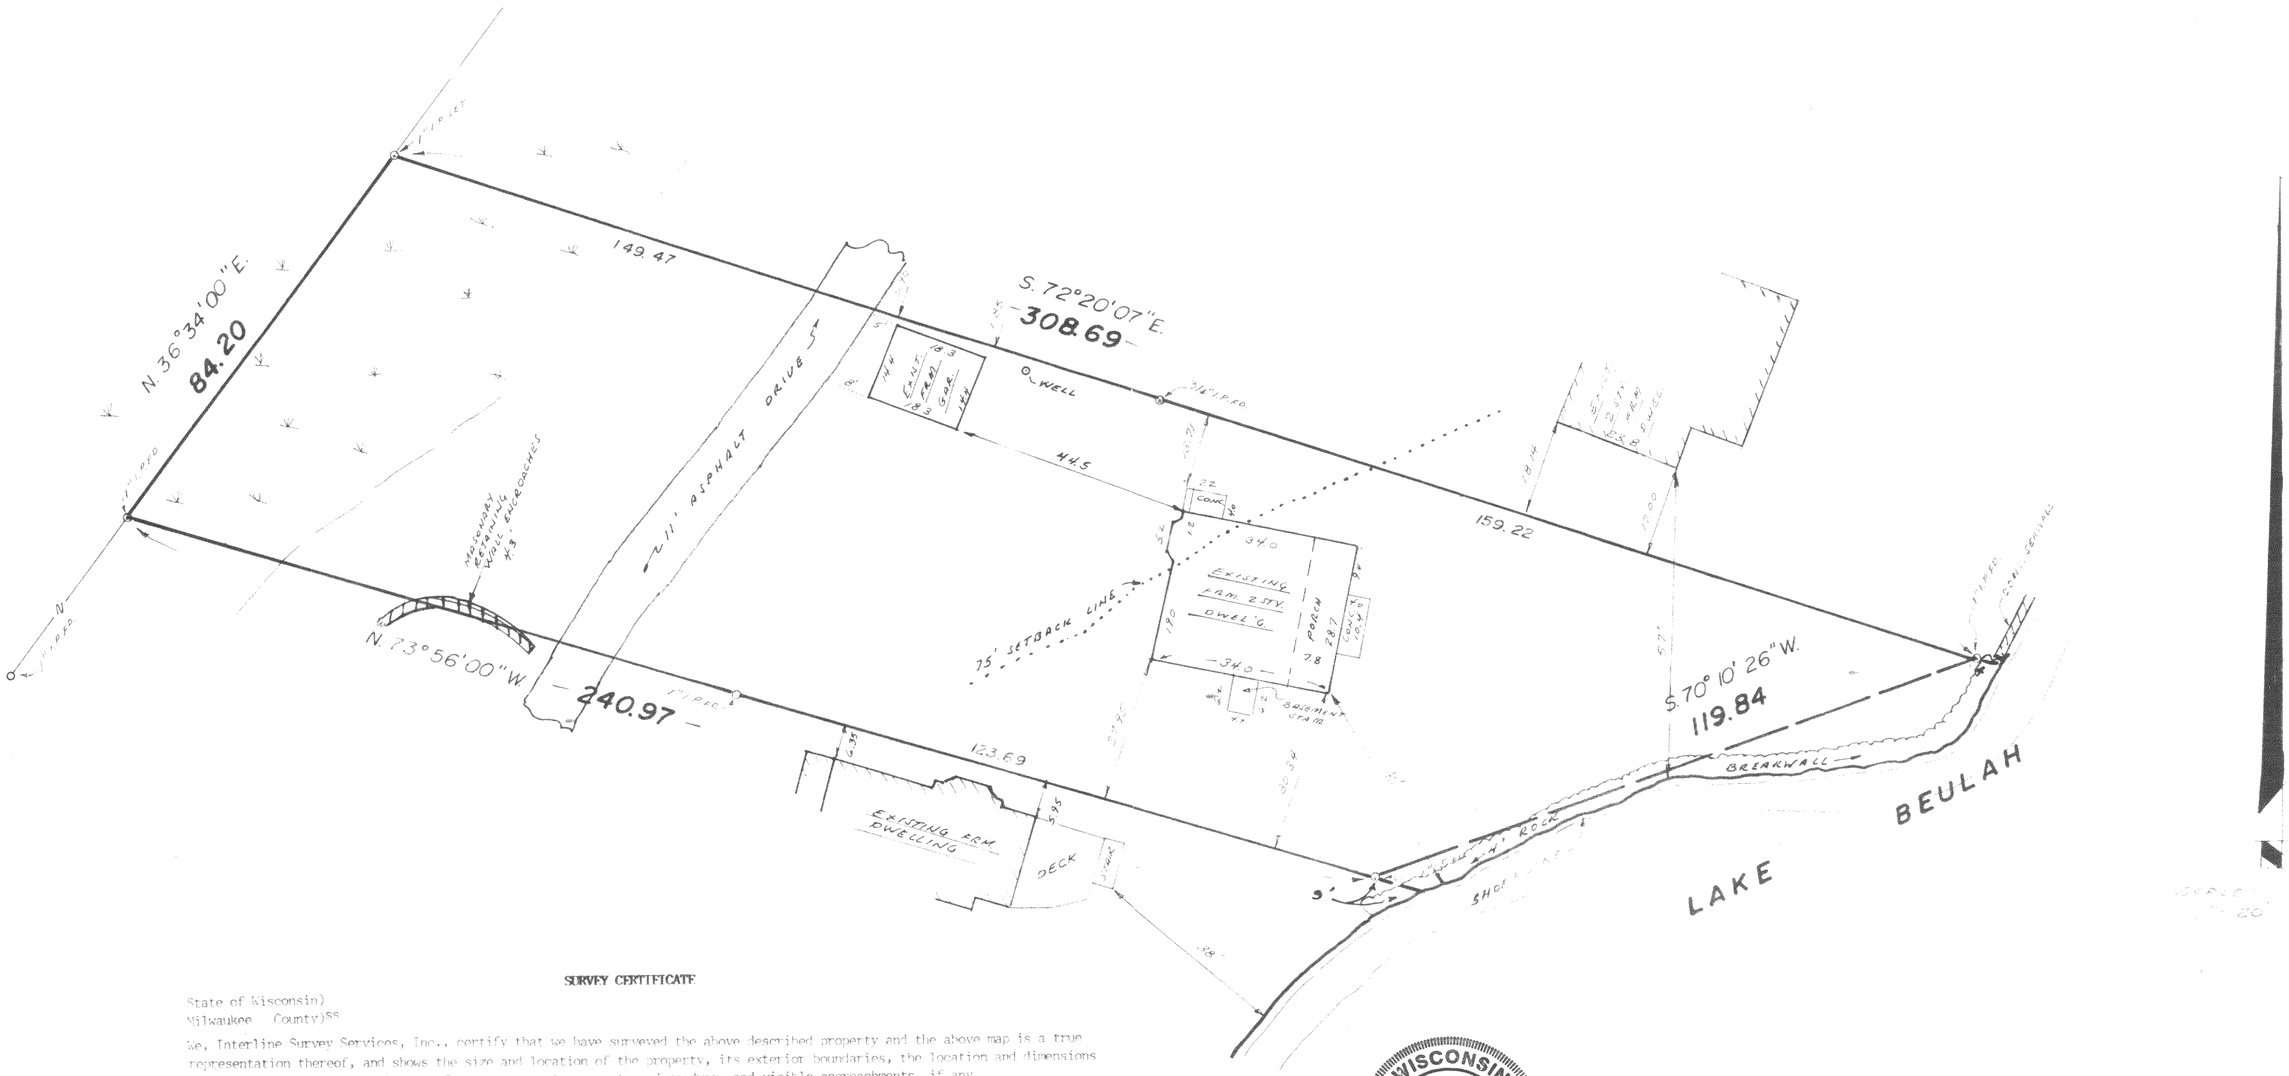

SURVEY CERTIFICATE

State of Wisconsin)
Milwaukee County)ss

We, Interline Survey Services, Inc., certify that we have surveyed the above described property and the above map is a true representation thereof, and shows the size and location of the property, its exterior boundaries, the location and dimensions of all visible structures thereon, fences, apparent easements and roadways and visible encroachments, if any.

This survey is made for the exclusive use of the present owners of the Property, and also those who purchase, mortgage, or guarantee the title thereto, within one (1) year from date hereof.

Gary J. Smith
Wisconsin Registered Land Surveyor

WISCONSIN
GARY J. SMITH
2195
MILWAUKEE, WI
LAND SURVEYOR

INTERLINE SURVEY SERVICES, INC.

JOB NO. 27377

PBM-7 418-1377