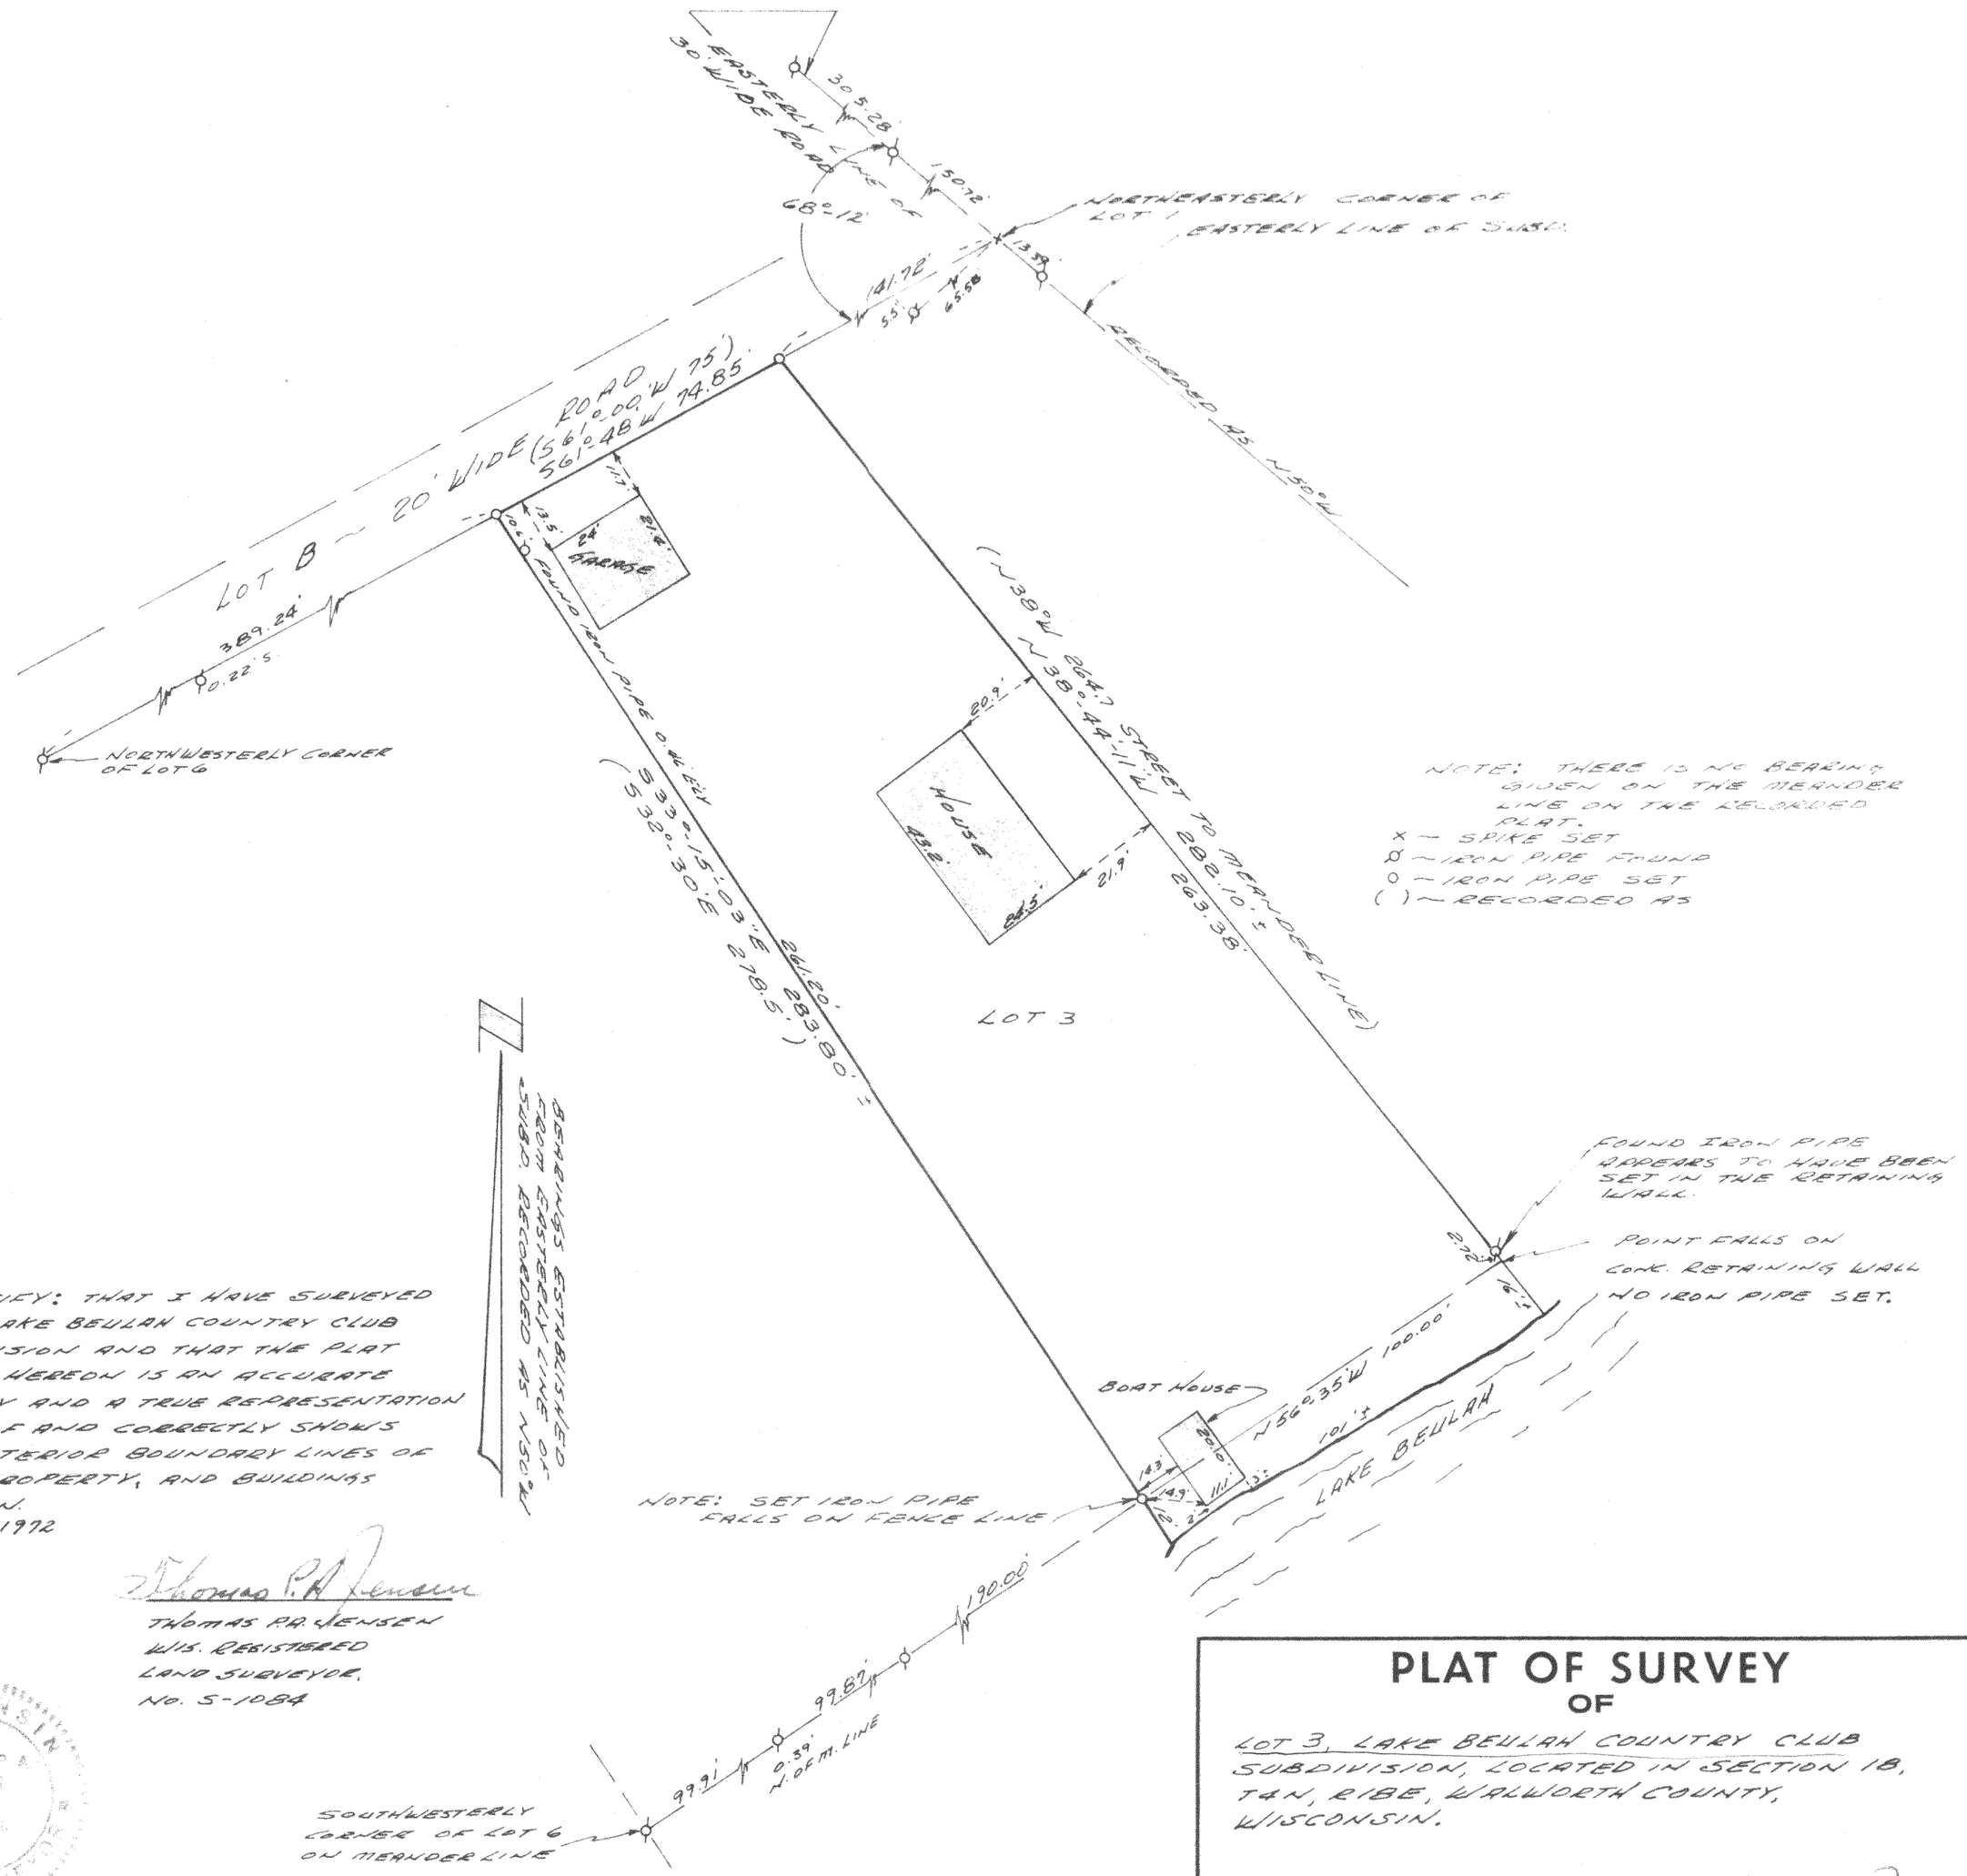

I CERTIFY: THAT I HAVE SURVEYED LOT 3, LAKE BEULAH COUNTRY CLUB SUBDIVISION AND THAT THE PLAT SHOWN HEREON IS AN ACCURATE SURVEY AND A TRUE REPRESENTATION THEREOF AND CORRECTLY SHOWS THE EXTERIOR BOUNDARY LINES OF SAID PROPERTY, AND BUILDINGS THEREON.
OCT. 10, 1972

Thomas P.H. Jensen
THOMAS P.H. JENSEN
WIS. REGISTERED
LAND SURVEYOR.
NO. S-1084

WISCONSIN
THOMAS P. H. JENSEN
S-1084
ELKHORN, WIS.
LAND SURVEYOR

PLAT OF SURVEY
OF

LOT 3, LAKE BEULAH COUNTRY CLUB SUBDIVISION, LOCATED IN SECTION 18, T4N, R18E, WALWORTH COUNTY, WISCONSIN.

Thomas P.H. Jensen
SURVEYOR

SCALE 1" = 30'

DATE OCT. 1972

418-147-J

PL-3

NO. 175H 300 9-68

418-147 J