
PLAT OF SURVEY

RSV ENGINEERING, INC
ENGINEERS, PLANNERS, SURVEYORS
CONSTRUCTION MANAGERS,
ENVIRONMENTAL SCIENTISTS
801 MAIN STREET, MUKWONAGO, WISCONSIN 53149 (262) 363-2004

DATE: 10/4/01

FOR: JAMES KUTCHENREUTER

DESCRIPTION:
THE NORTHERLY HALF OF LOT 13, BEULAH PARK SUBDIVISION, LOCATED IN SECTION 4, TOWN 4 NORTH, RANGE 18 EAST, TOWN OF EAST TROY, WISCONSIN.

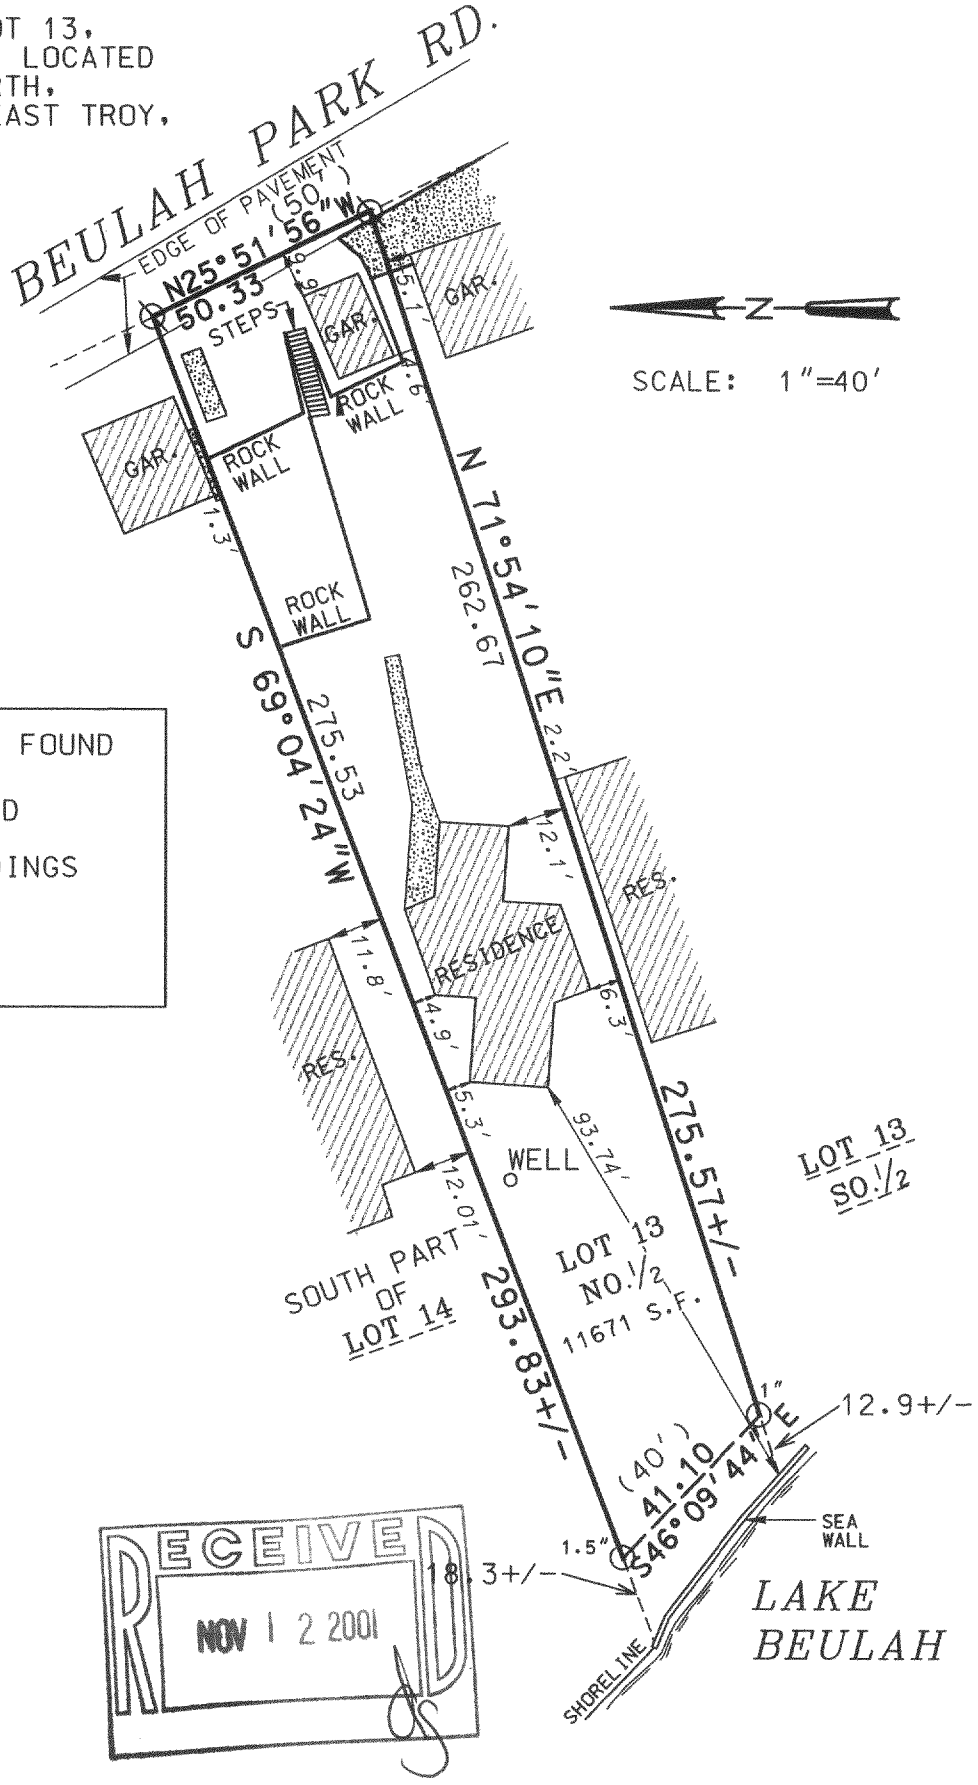

SCALE: 1"=40'

LEGEND

⊗	RAILROAD SPIKE FOUND
○	IRON PIPE FOUND
▨	EXISTING BUILDINGS
▒	CONCRETE
( )	RECORDED AS

RECEIVED
NOV 1 2 2001

THE ABOVE MAP IS A TRUE REPRESENTATION THEREOF AND SHOWS THE SIZE AND LOCATION OF ALL THE PROPERTY, EXTERIOR BOUNDARIES, THE LOCATION OF ALL VISIBLE BOUNDARY FENCES, APPARENT EASEMENTS, ROADWAYS AND VISIBLE ENCROACHMENTS, IF ANY.

THIS SURVEY IS MADE FOR THE USE OF THE PRESENT OWNERS OF THE PROPERTY, AND ALSO THOSE WHO PURCHASE, MORTGAGE OR GUARANTEE TITLE THERETO WITHIN ONE (1) YEAR FROM DATE HERETO.

BRADFORD L. SPENCER, R.L.S. 2069
RSV#01277

WISCONSIN
BRADFORD L. SPENCER
S-2069
MUKWONAGO WIS.
LAND SURVEYOR
THIS IS ORIGINAL PRINT ONLY IF SEAL IS IMPRINTED IN RED

PBL-15\ 418-1504