
PLAT OF SURVEY

OF

LOTS 5 & 6, BLK. 13 OF MIRAMAR SUBD. LOCATED IN SECTIONS 10 & 11, T4N, R18E, WALWORTH CO., WISCONSIN

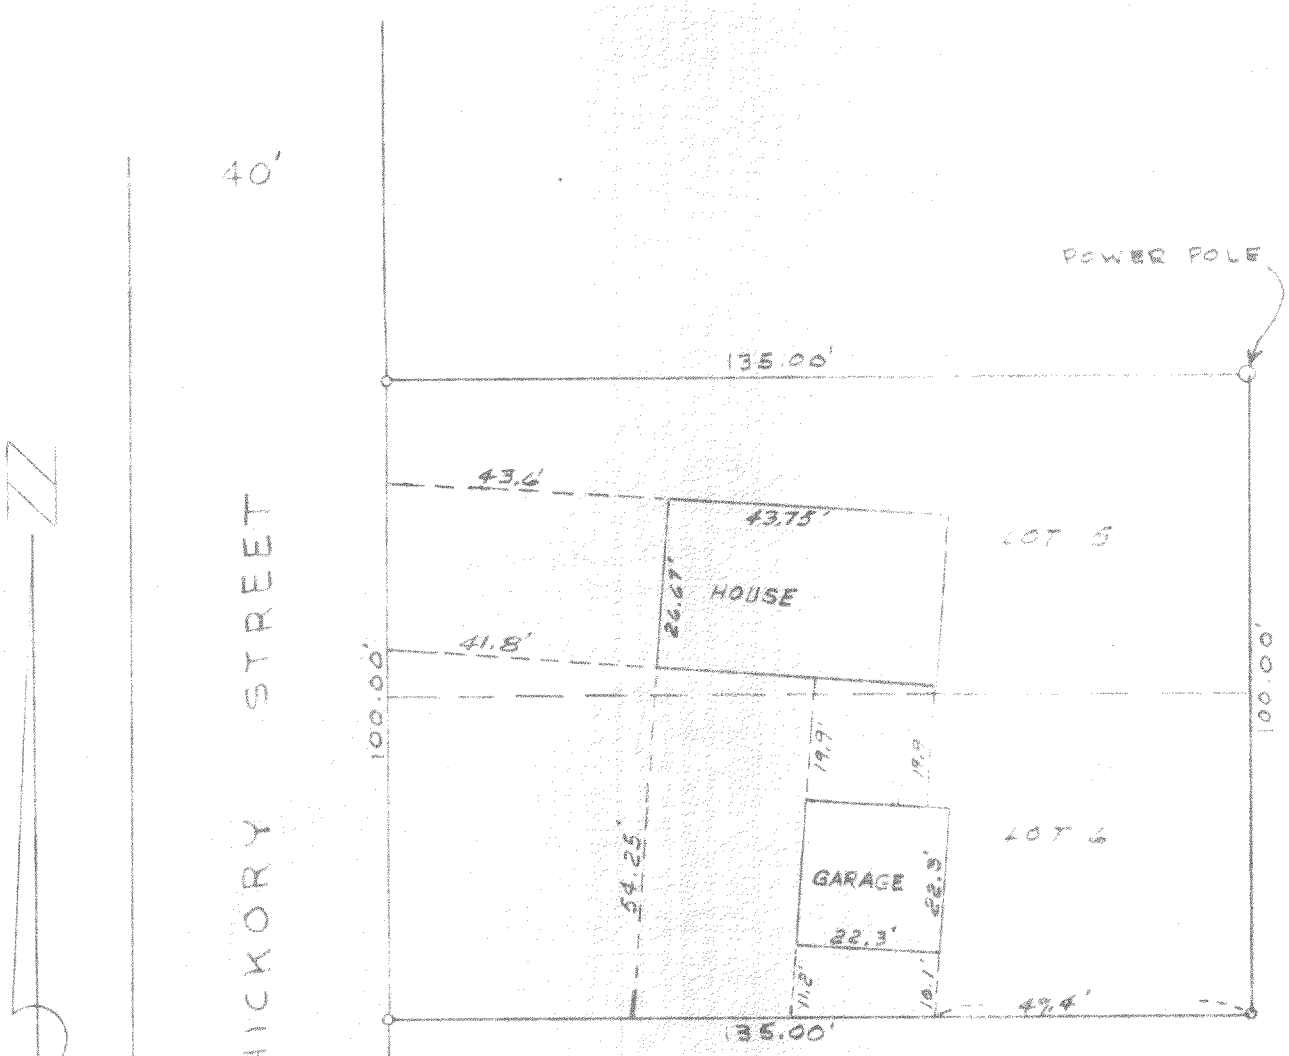

WISCONSIN
LLOYD L. JENSEN
S-211
ELKHORN, WIS.
LAND SURVEYOR

SURVEY AND PLAT BY

JENSEN & JOHNSON, INC.

CIVIL ENGINEERS AND SURVEYORS

Elkhorn, Wisconsin

LEGEND

○ — Iron Pipe FOUND

● — Concrete Monument

Scale 1" = 30'

WE CERTIFY: That we have surveyed the above described property and that the plat shown hereon is an accurate survey and a true representation thereof and correctly shows the exterior boundary lines and all divisions of said property. AND ALL BUILDINGS THEREON.

Date JAN. 9, 1969

Lloyd L. Jensen

LLOYD L. JENSEN,

Wisconsin Registered Land Surveyor, No. S-211

17914—500—11-68

418-162 J

PMR-145