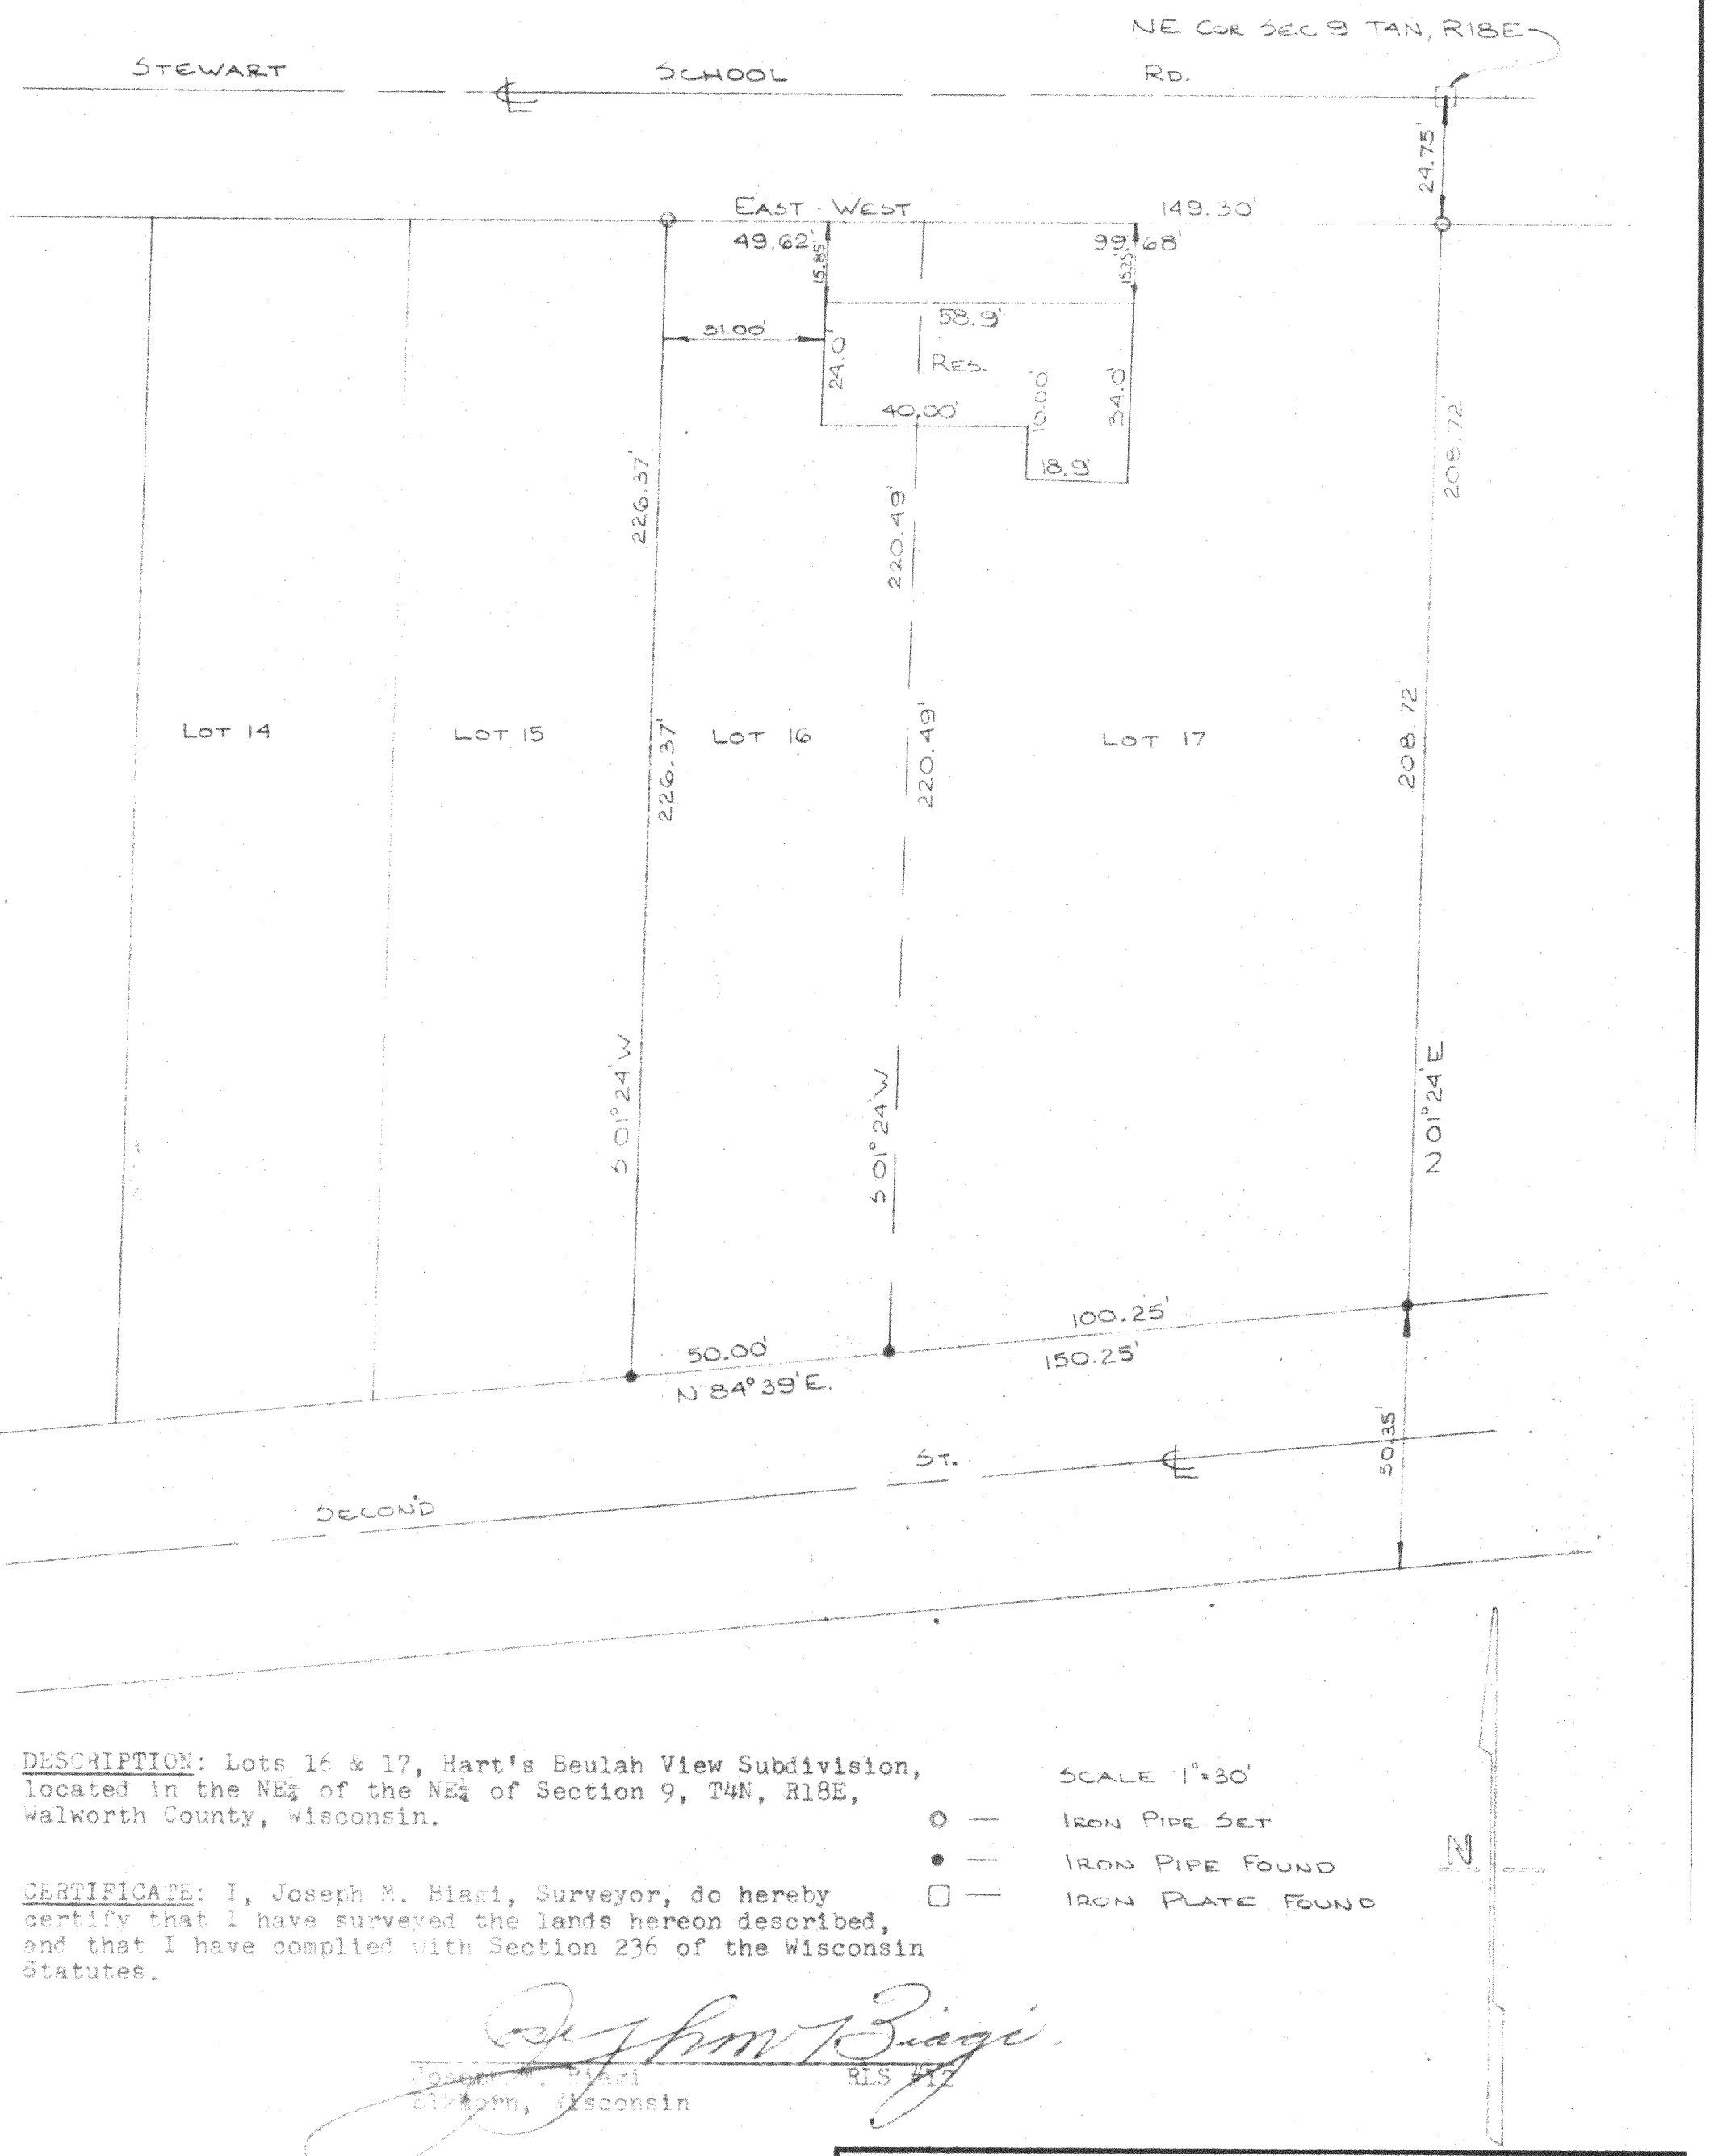


DESCRIPTION: Lots 16 & 17, Hart's Beulah View Subdivision, located in the NE¼ of the NE¼ of Section 9, T4N, R18E, Walworth County, Wisconsin.

SCALE 1"=30'

○ — IRON PIPE SET

● — IRON PIPE FOUND

□ — IRON PLATE FOUND

N

CERTIFICATE: I, Joseph M. Biani, Surveyor, do hereby certify that I have surveyed the lands hereon described, and that I have complied with Section 236 of the Wisconsin Statutes.

Joseph M. Biani RLS #12
Elkhorn, Wisconsin

DATE: December 10, 1973

SCALE:	APPROVED BY:	DRAWN BY
DATE:		REVISED

418-208
DRAWING NUMBER

PHS-16,17