
PLAT OF SURVEY

DESCRIPTION:
BEING PART OF LOT 12 OF ROMADKA PARK SUBDIVISION, LOCATED IN THE SE¼ OF SECTION 5, TOWN 4 NORTH, RANGE 18 EAST, TOWN OF EAST TROY, WALWORTH COUNTY, WISCONSIN. DESCRIBED AS FOLLOWS: BEGINNING AT THE SE CORNER OF SAID LOT 12, SAID POINT BEING ON THE WESTERLY SHORE OF LAKE BEULAH; THENCE N76°17'45"W, A DISTANCE OF 19.56' +/- TO A MEANDER POINT ON SAID WESTERLY SHORE; THENCE N76°17'45"W, A DISTANCE OF 154.44'; THENCE N81°59'45"W, A DISTANCE OF 30.00'; THENCE N01°07'25"E, A DISTANCE OF 40.75'; THENCE S79°21'09"E, A DISTANCE OF 183.39' TO A MEANDER POINT ALONG WESTERLY SHORE OF LAKE BEULAH; THENCE S79°21'09"E, A DISTANCE OF 8.11'+/- TO A POINT ON THE WESTERLY SHORELINE OF LAKE BEULAH; THENCE SOUTH ALONG SAID SHORE LINE TO THE POINT OF BEGINNING. SAID PARCEL INCLUDES LAND BETWEEN THE MEANDER LINE AND ORDINARY HIGH WATER MARK ON LAKE BEULAH.

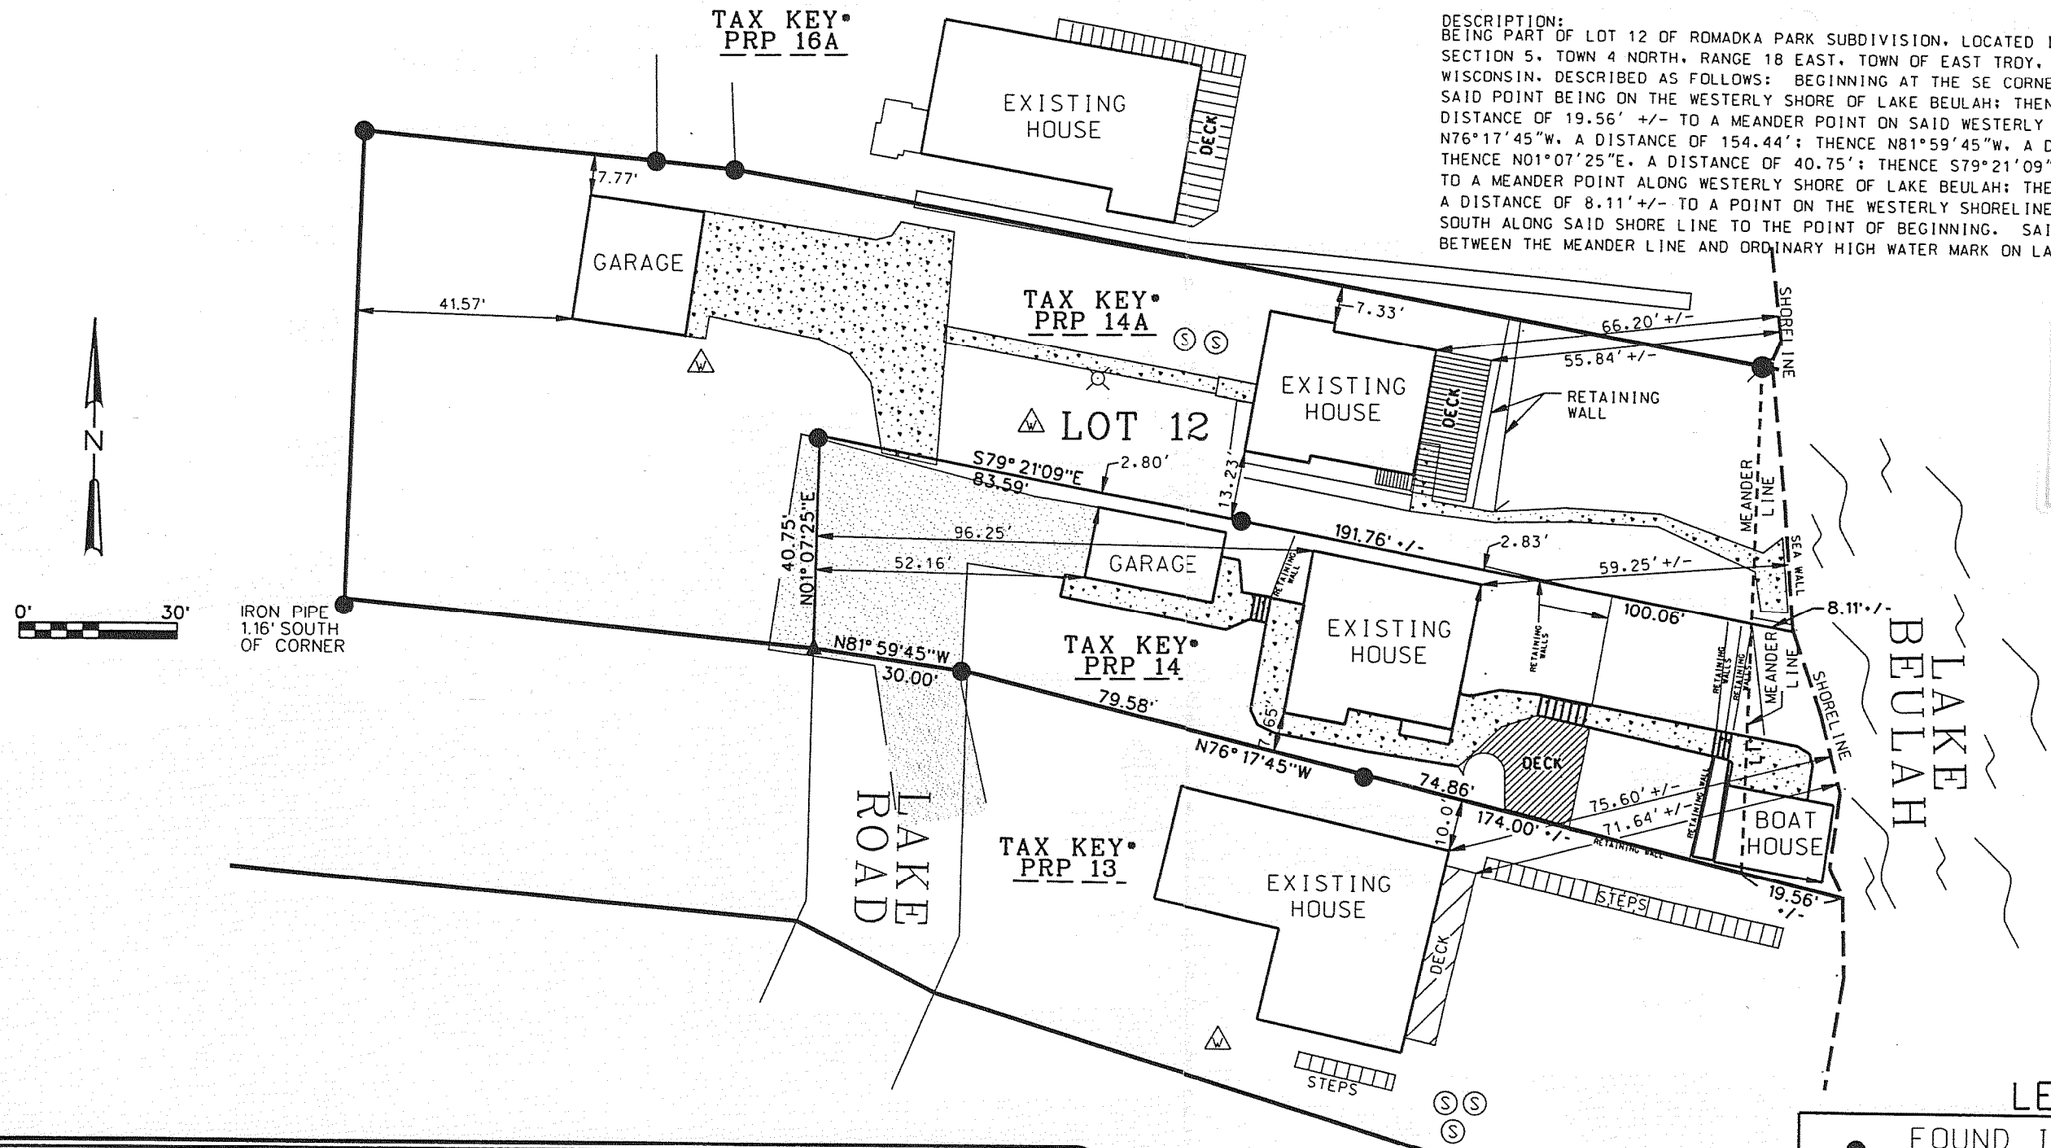

LINE TABLE

L1	S01° 37'20"W	47.63'

RECEIVED
JAN 29 2008
SMK

LEGEND:

- FOUND IRON PIPE/ REBAR AS NOTED
- SET 1" IRON PIPE
- SET PK NAIL IN PAVEMENT
- CONCRETE SIDEWALK
- ASPHALT PAVED AREA

SURVEY DATE: 10/15/07
SURVEY MADE FOR:
KATHY KIERNAN
5724 GIDDINGS
HINSDALE, IL 60521

THIS SURVEY IS MADE FOR THE USE OF THE PRESENT OWNERS OF THE PROPERTY, AND ALSO THOSE WHO PURCHASE, MORTGAGE OR GUARANTEE TITLE TO WITHIN ONE (1) YEAR FROM DATE HERETO.

I, MICHAEL A. GREESON R.L.S. •2770, HEREBY CERTIFY THAT THIS SURVEY WAS MADE IN ACCORDANCE WITH THE MINIMUM STANDARDS FOR PROPERTY SURVEYS (CHAPTER A-E 7) FOR THE STATE OF WISCONSIN AND HAS BEEN PREPARED UNDER MY DIRECTION AND CONTROL AND IS CORRECT TO THE BEST OF MY KNOWLEDGE AND BELIEF.

Michael A. Greeson S-2770 East Troy Wis — WISCONSIN — 10-15-07 — LAND SURVEYOR

RSV ENGINEERING, INC.
W232 S7530 BIG BEND DRIVE
BIG BEND, WI 53103
(262) 662-4292

PLOT DATE: 10/15/2007
RSV JOB•: 04-175 KIERNAN

PRP-14 PRP-14A

418-2086

FILE NAME: 04SURVEYS/041757KIERNANUPDTATE.DGN