LOT 6, GREYSTONE ESTATES, BEING PART OF THE SOUTHEAST 1/4 AND SOUTHWEST 1/4 OF THE NORTHWEST 1/4 OF SECTION 14 AND PART OF THE NORTHEAST 1/4 AND NORTHWEST 1/4 OF THE SOUTHWEST 1/4 OF SECTION 14, ALL IN TOWN 4 NORTH, RANGE 18 EAST, TOWN OF EAST TROY, WALWORTH COUNTY, WISCONSIN.

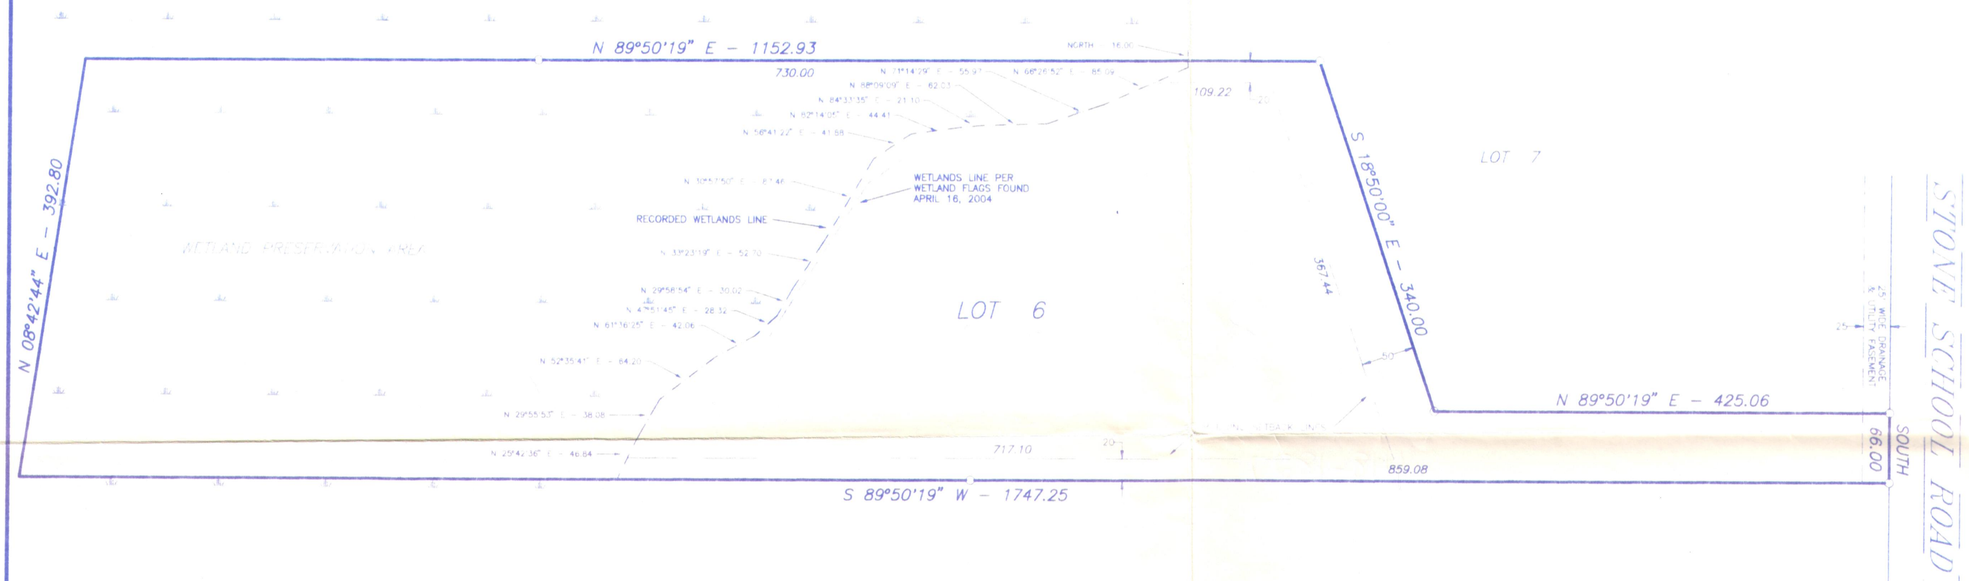

PROJECT

PLAT OF SURVEY

PROJECT NO.

048111
048111S1.DWG

DATE

APRIL 14, 2004

REVISIONS

SURVEYOR

GARY B. FOAT
DEGEN - FOAT SURVEYING

PREPARED FOR

GARY DIERKS
4833 S. MARIN WAY
NEW BERLIN, WI 53151

SCALE: 1" = 100'
BEARING BASE AS RECORDED AS

LEGEND

- ○ = SET 1" IRON PIPE
- x—x = FENCE
- ( ) = RECORDED AS
- ♦ = SOIL BORING

IN ACCORDANCE WITH A-E 7.01(2)(b) OF THE WISCONSIN ADMINISTRATIVE CODE
GARY DIERKS, OWNER AND GARY B. FOAT, SURVEYOR DO HEREBY
MUTUALLY AGREE TO WAIVE MONUMENTATION OF THE ABOVE DESCRIBED PARCEL.

RECEIVED
FEB 14 2005

WISCONSIN
GARY B. FOAT
S-1598
Waterford, Wis.
LAND SURVEYOR

DEGEN-FOAT SURVEYING LLC
100 SOUTH SECOND STREET
WATERFORD, WISCONSIN
(262)534-5404 (FAX)534-2022

I HEREBY CERTIFY THAT I HAVE SURVEYED THE ABOVE DESCRIBED PROPERTY AND THE ABOVE MAP IS A TRUE REPRESENTATION THEREOF AND SHOWS THE SIZE AND LOCATION OF THE PROPERTY, THE LOCATION OF ALL VISIBLE STRUCTURES AND DIMENSIONS OF ALL PRINCIPAL BUILDINGS THEREON, BOUNDARY FENCES, APPARENT EASEMENTS, ROADWAY AND VISIBLE ENCROACHMENTS, IF ANY.

THIS SURVEY IS MADE FOR THE PRESENT OWNERS OF THE PROPERTY, AND ALSO THOSE WHO PURCHASE, OR GUARANTEE THE TITLE THERETO WITHIN (1) YEAR FROM THE DATE HEREOF

DATED AT WATERFORD THIS 14th DAY OF APRIL 20 04

RECERTIFIED _____

Gary B. Foat

PGRE 6

418-2311