Plat Of Survey


Property Address: W979 Miramar Drive, East Troy, Wisconsin

Property Description: Lot 19, Block 1, PLAT OF MIRAMAR, being a subdivision located in Sections 10 and 11, Township 4 North, Range 18 East, in the Town of East Troy, Walworth County, Wisconsin.

September 12, 2013

Survey No. 13126

Prepared For:
Mark & Luann Provost

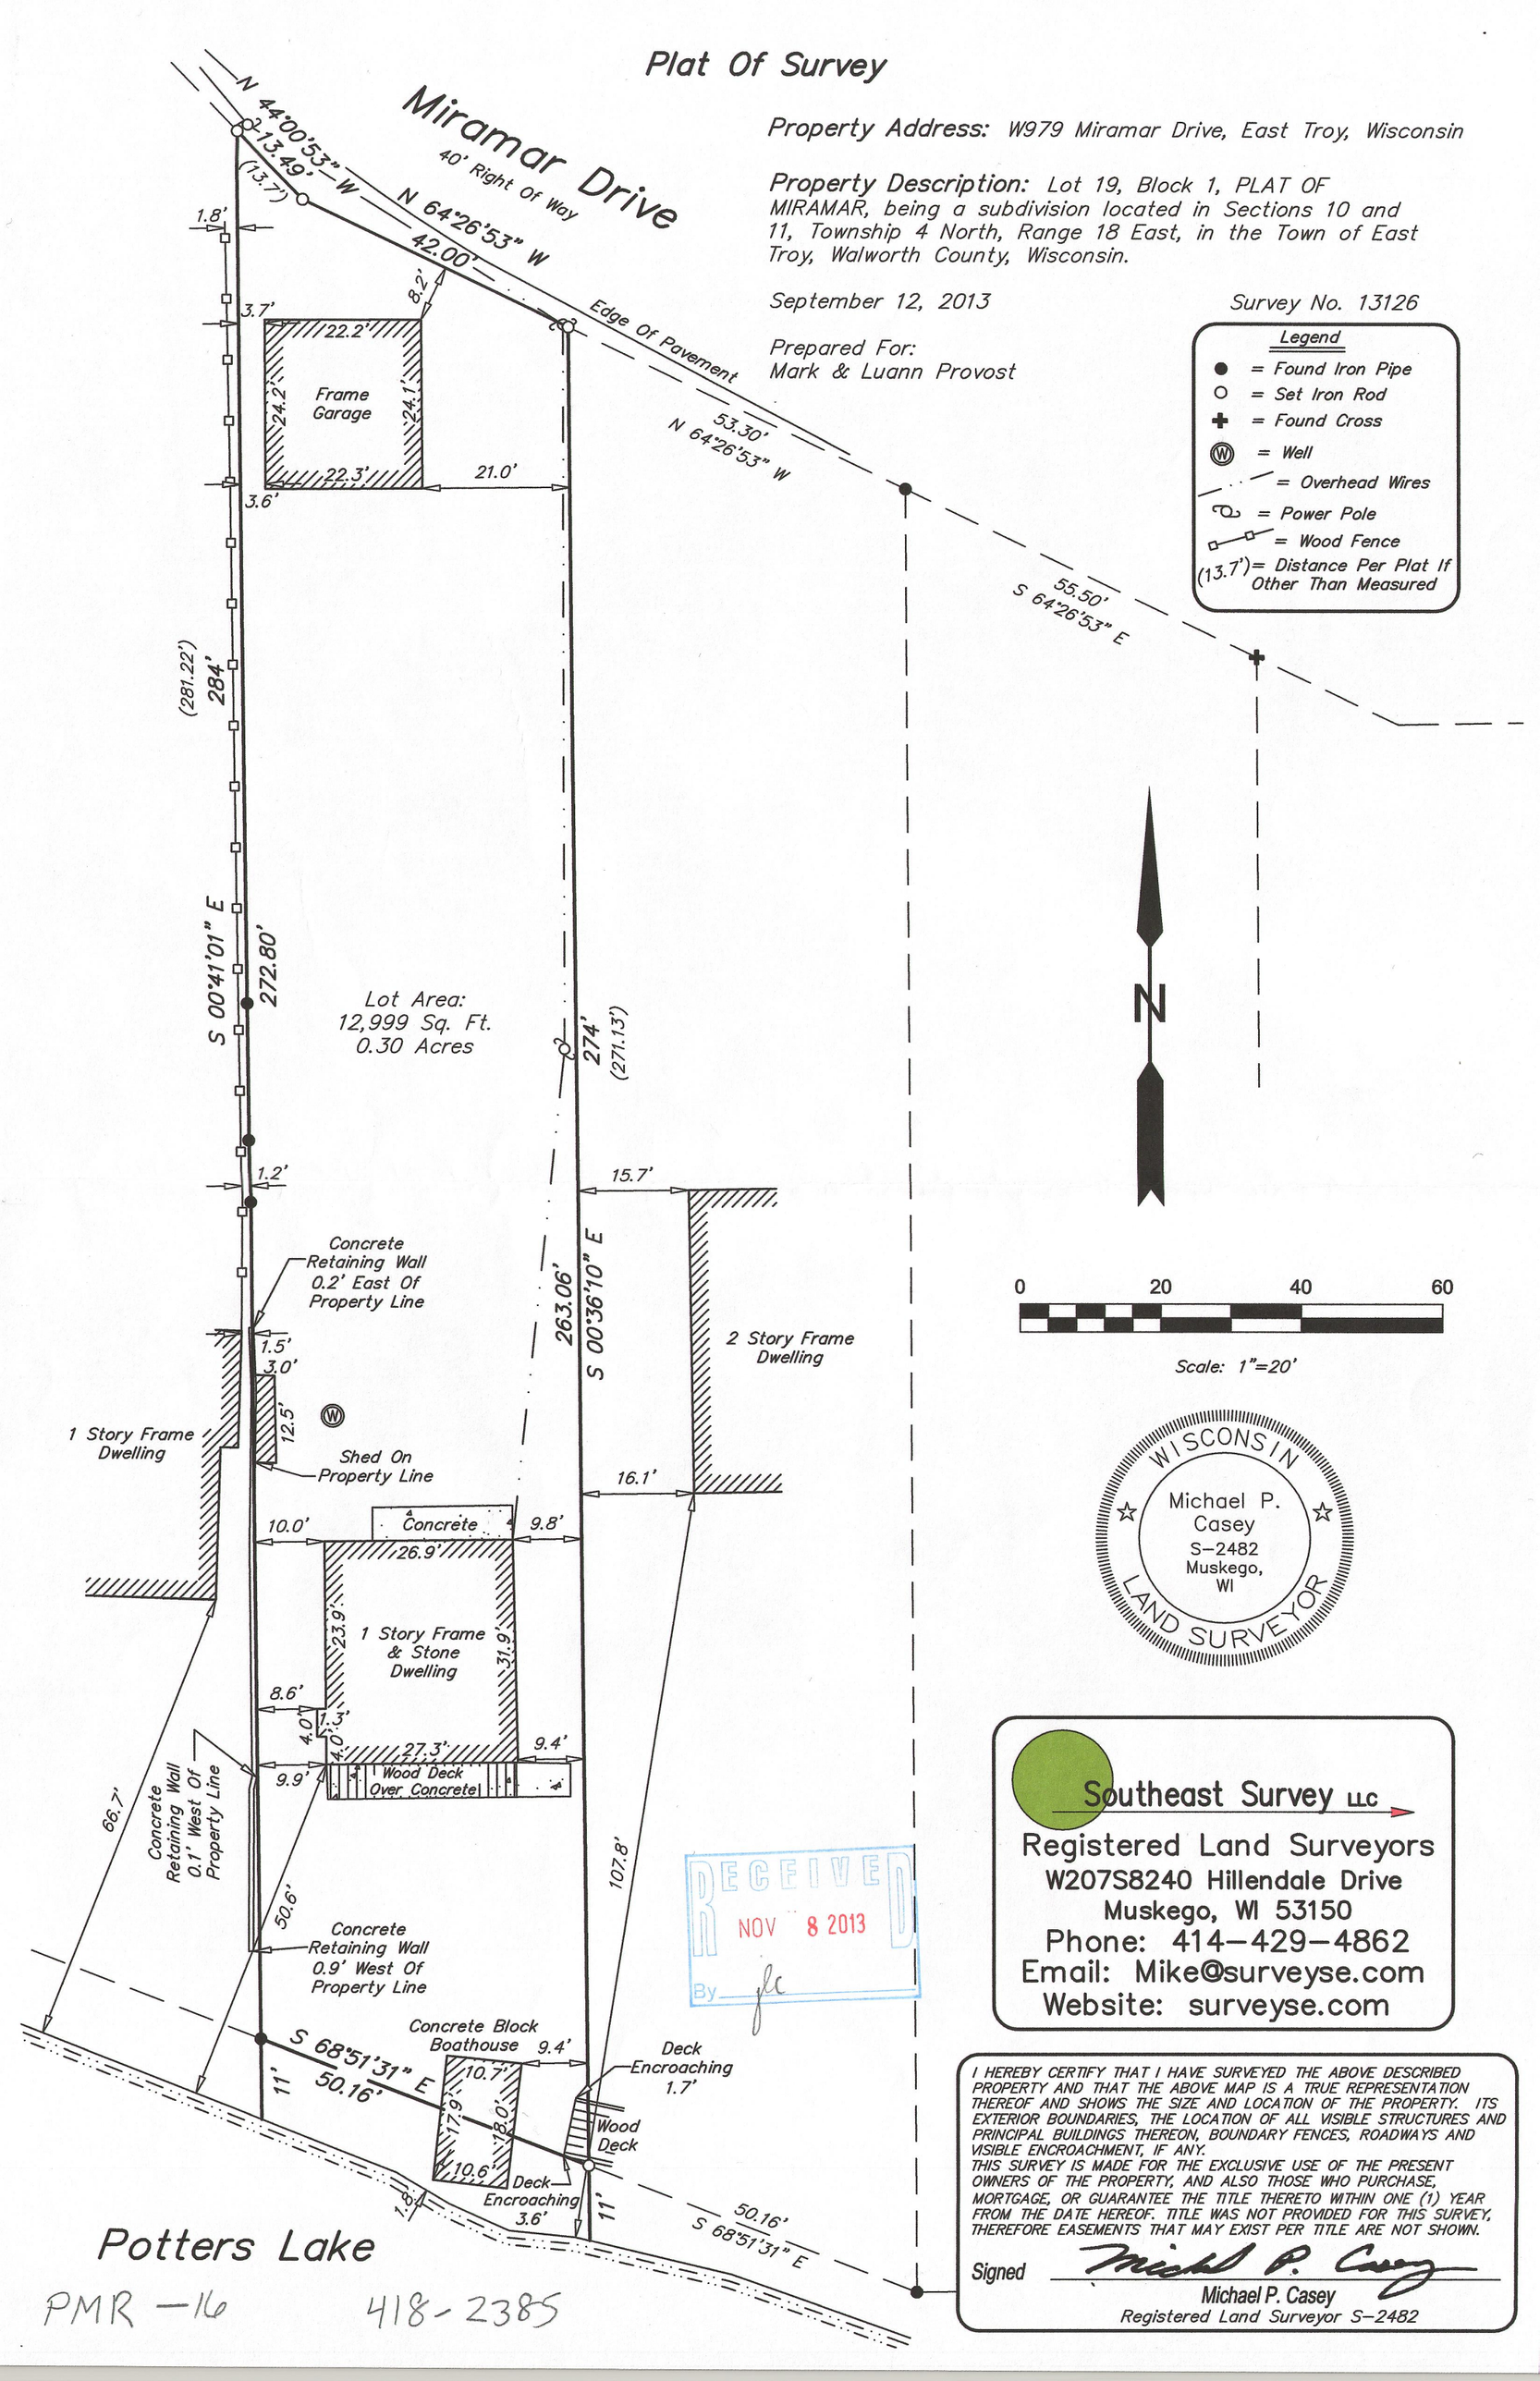

Legend

- ● = Found Iron Pipe
- ○ = Set Iron Rod
- ✚ = Found Cross
- Ⓦ = Well
- = Overhead Wires
- = Power Pole
- = Wood Fence
- (13.7') = Distance Per Plat If Other Than Measured

WISCONSIN
Michael P. Casey
S-2482
Muskego, WI
LAND SURVEYOR

RECEIVED
NOV 8 2013
By jlc

Southeast Survey LLC
Registered Land Surveyors
W207S8240 Hillendale Drive
Muskego, WI 53150
Phone: 414-429-4862
Email: Mike@surveyse.com
Website: surveyse.com

I HEREBY CERTIFY THAT I HAVE SURVEYED THE ABOVE DESCRIBED PROPERTY AND THAT THE ABOVE MAP IS A TRUE REPRESENTATION THEREOF AND SHOWS THE SIZE AND LOCATION OF THE PROPERTY. ITS EXTERIOR BOUNDARIES, THE LOCATION OF ALL VISIBLE STRUCTURES AND PRINCIPAL BUILDINGS THEREON, BOUNDARY FENCES, ROADWAYS AND VISIBLE ENCROACHMENT, IF ANY.
THIS SURVEY IS MADE FOR THE EXCLUSIVE USE OF THE PRESENT OWNERS OF THE PROPERTY, AND ALSO THOSE WHO PURCHASE, MORTGAGE, OR GUARANTEE THE TITLE THERETO WITHIN ONE (1) YEAR FROM THE DATE HEREOF. TITLE WAS NOT PROVIDED FOR THIS SURVEY, THEREFORE EASEMENTS THAT MAY EXIST PER TITLE ARE NOT SHOWN.

Signed Michael P. Casey
Michael P. Casey
Registered Land Surveyor S-2482

PMR -16 418-2385