
HAROLD H. KOLB

REGISTERED PROFESSIONAL LAND SURVEYOR
LAKE GENEVA, WISCONSIN

PLAT OF SURVEY OF

A parcel of land located in the Southeast ¼ of Section 10, T 4 N, R 18 E, Walworth County, Wisconsin, described as follows: Commencing at the North ¼ corner of said Section 10; thence S 6°54'55" W 3495.31 feet to the place of beginning; thence N 89°57'55" E 473.24 feet; thence S 72°20'20" E 378.34 feet; thence S 51°25'50" W 192.01 feet; thence S 31°28'10" W 79.38 feet; thence S 20°37'50" W 165.20 feet; thence West 584.89 feet; thence N 0°03'05" W 456.93 feet to the place of beginning.
Containing 7.00 acres.
Lots 3-6, Spleas Subdivision, T 4 N, R 18 E, Walworth County, Wisconsin

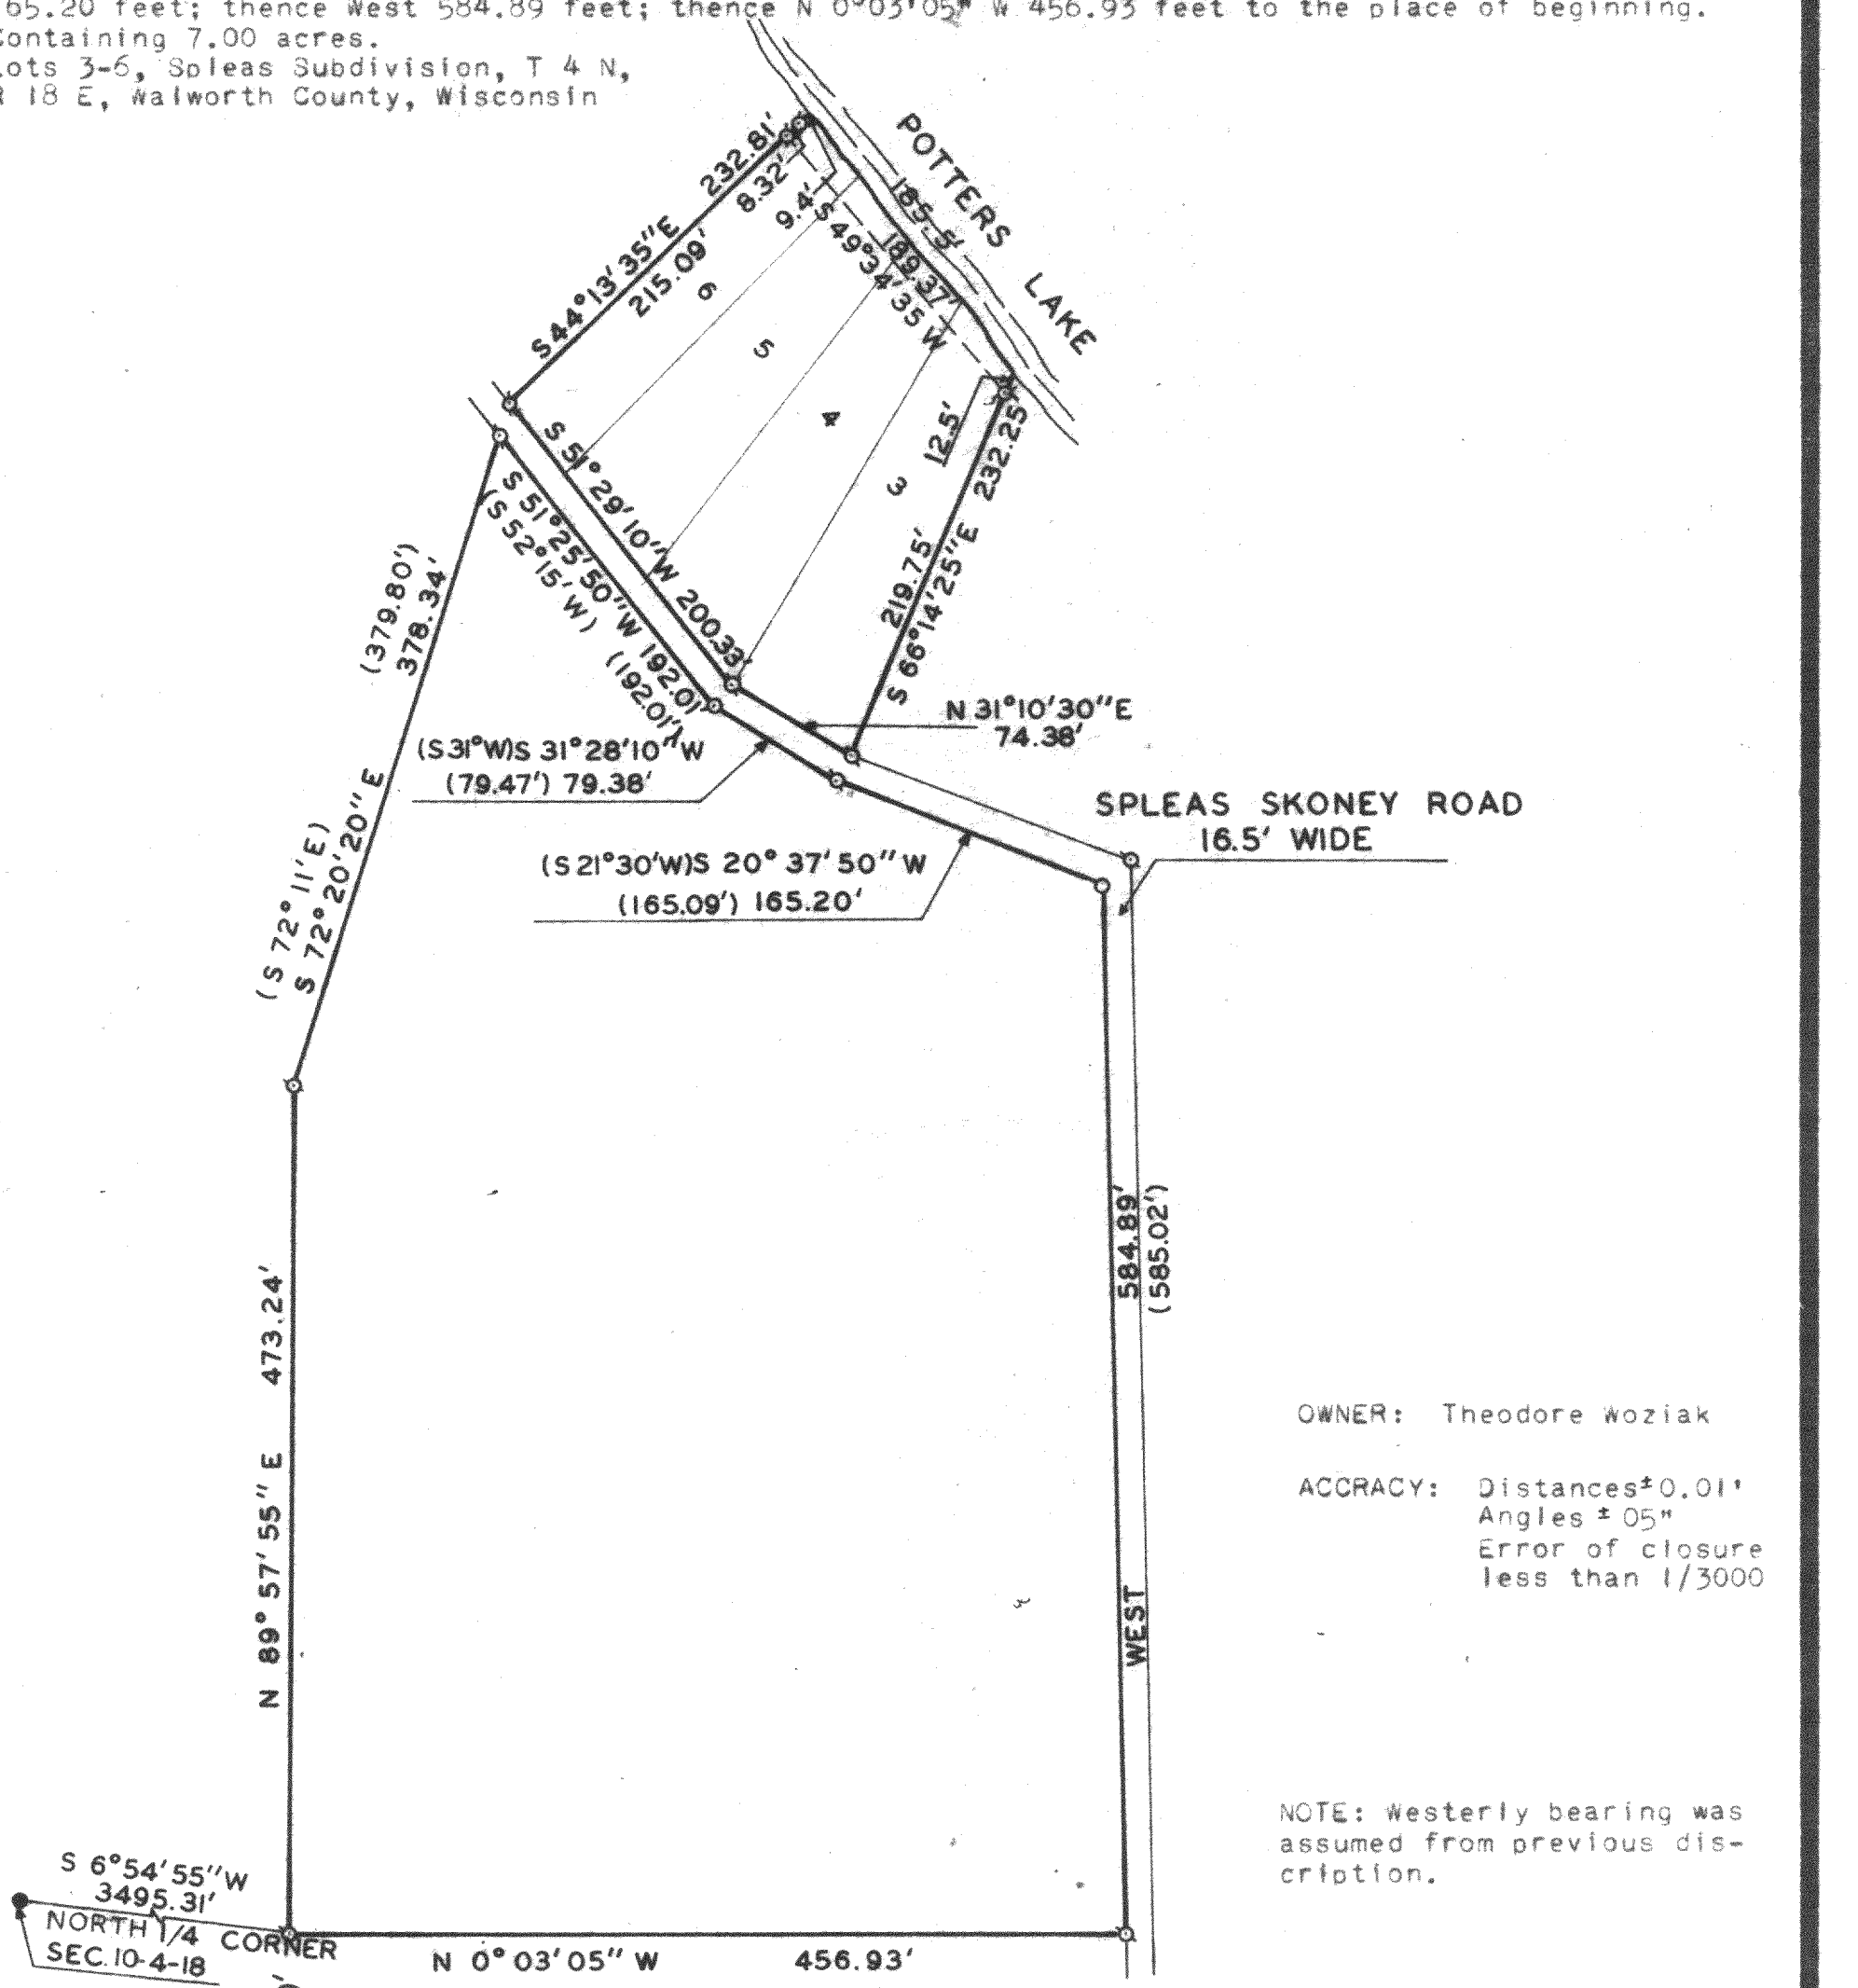

OWNER: Theodore Woziak

ACCRACY: Distances ± 0.01'
Angles ± 05"
Error of closure less than 1/3000

NOTE: Westerly bearing was assumed from previous discription.

LEGEND
- ⌀ — IRON PIPE FOUND
- O — IRON PIPE PLACED
- ● — CONCRETE MONUMENT
- x — SPIKE
- ()- Discribed As

WISCONSIN
HAROLD H. KOLB
S-187
LAKE GENEVA, WIS.
LAND SURVEYOR

I, HAROLD H. KOLB, DO HEREBY CERTIFY THAT I HAVE SURVEYED THE PROPERTY HEREON DESCRIBED ACCORDING TO THE OFFICIAL RECORDS, AND THAT THE PLAT HEREON IS A CORRECT REPRESENTATION OF THE LOT LINES.

Harold H. Kolb
HAROLD H. KOLB
WISCONSIN REGISTERED LAND SURVEYOR, S—187
DATE Sept. 6, 1974

418-242

ET-10-14 and ~~SP-1, SP-2~~ + SP-3