Plat of Survey


of

A parcel of land described in a Warranty Deed recorded October 31, 2012 as Document No. 849957 as shown below:


A parcel of land located in the recorded plat of Williams Park, a Subdivision located in Section 4, T4N, R18E, of Walworth County, Wisconsin described as follows, to-wit: Commencing at the Southeast Corner of said Williams Park, thence N 6° 30' W 121.13 feet to a point: thence S 85° 33' W 33.02 feet to the West line of the public highway; thence N 6° 30' W along the edge of said highway 923.22 feet to the place of beginning; thence S 89° 17' W 140.78 feet; thence N 0° 43' W 402.60 feet to the South line of County Trunk Highway "J", thence N 89° 17' E along said County Trunk Highway 100 feet to the Westerly line of a Town Highway; thence S 6° 30' along said Town Highway 404.65 feet to the place of beginning.

Tax Key No: PWP 00015D

Note:
See lands that appear to have been conveyed to Walworth County by Warranty Deed recorded in Vol. 531 on Page 383 as Doc. No. 503979.

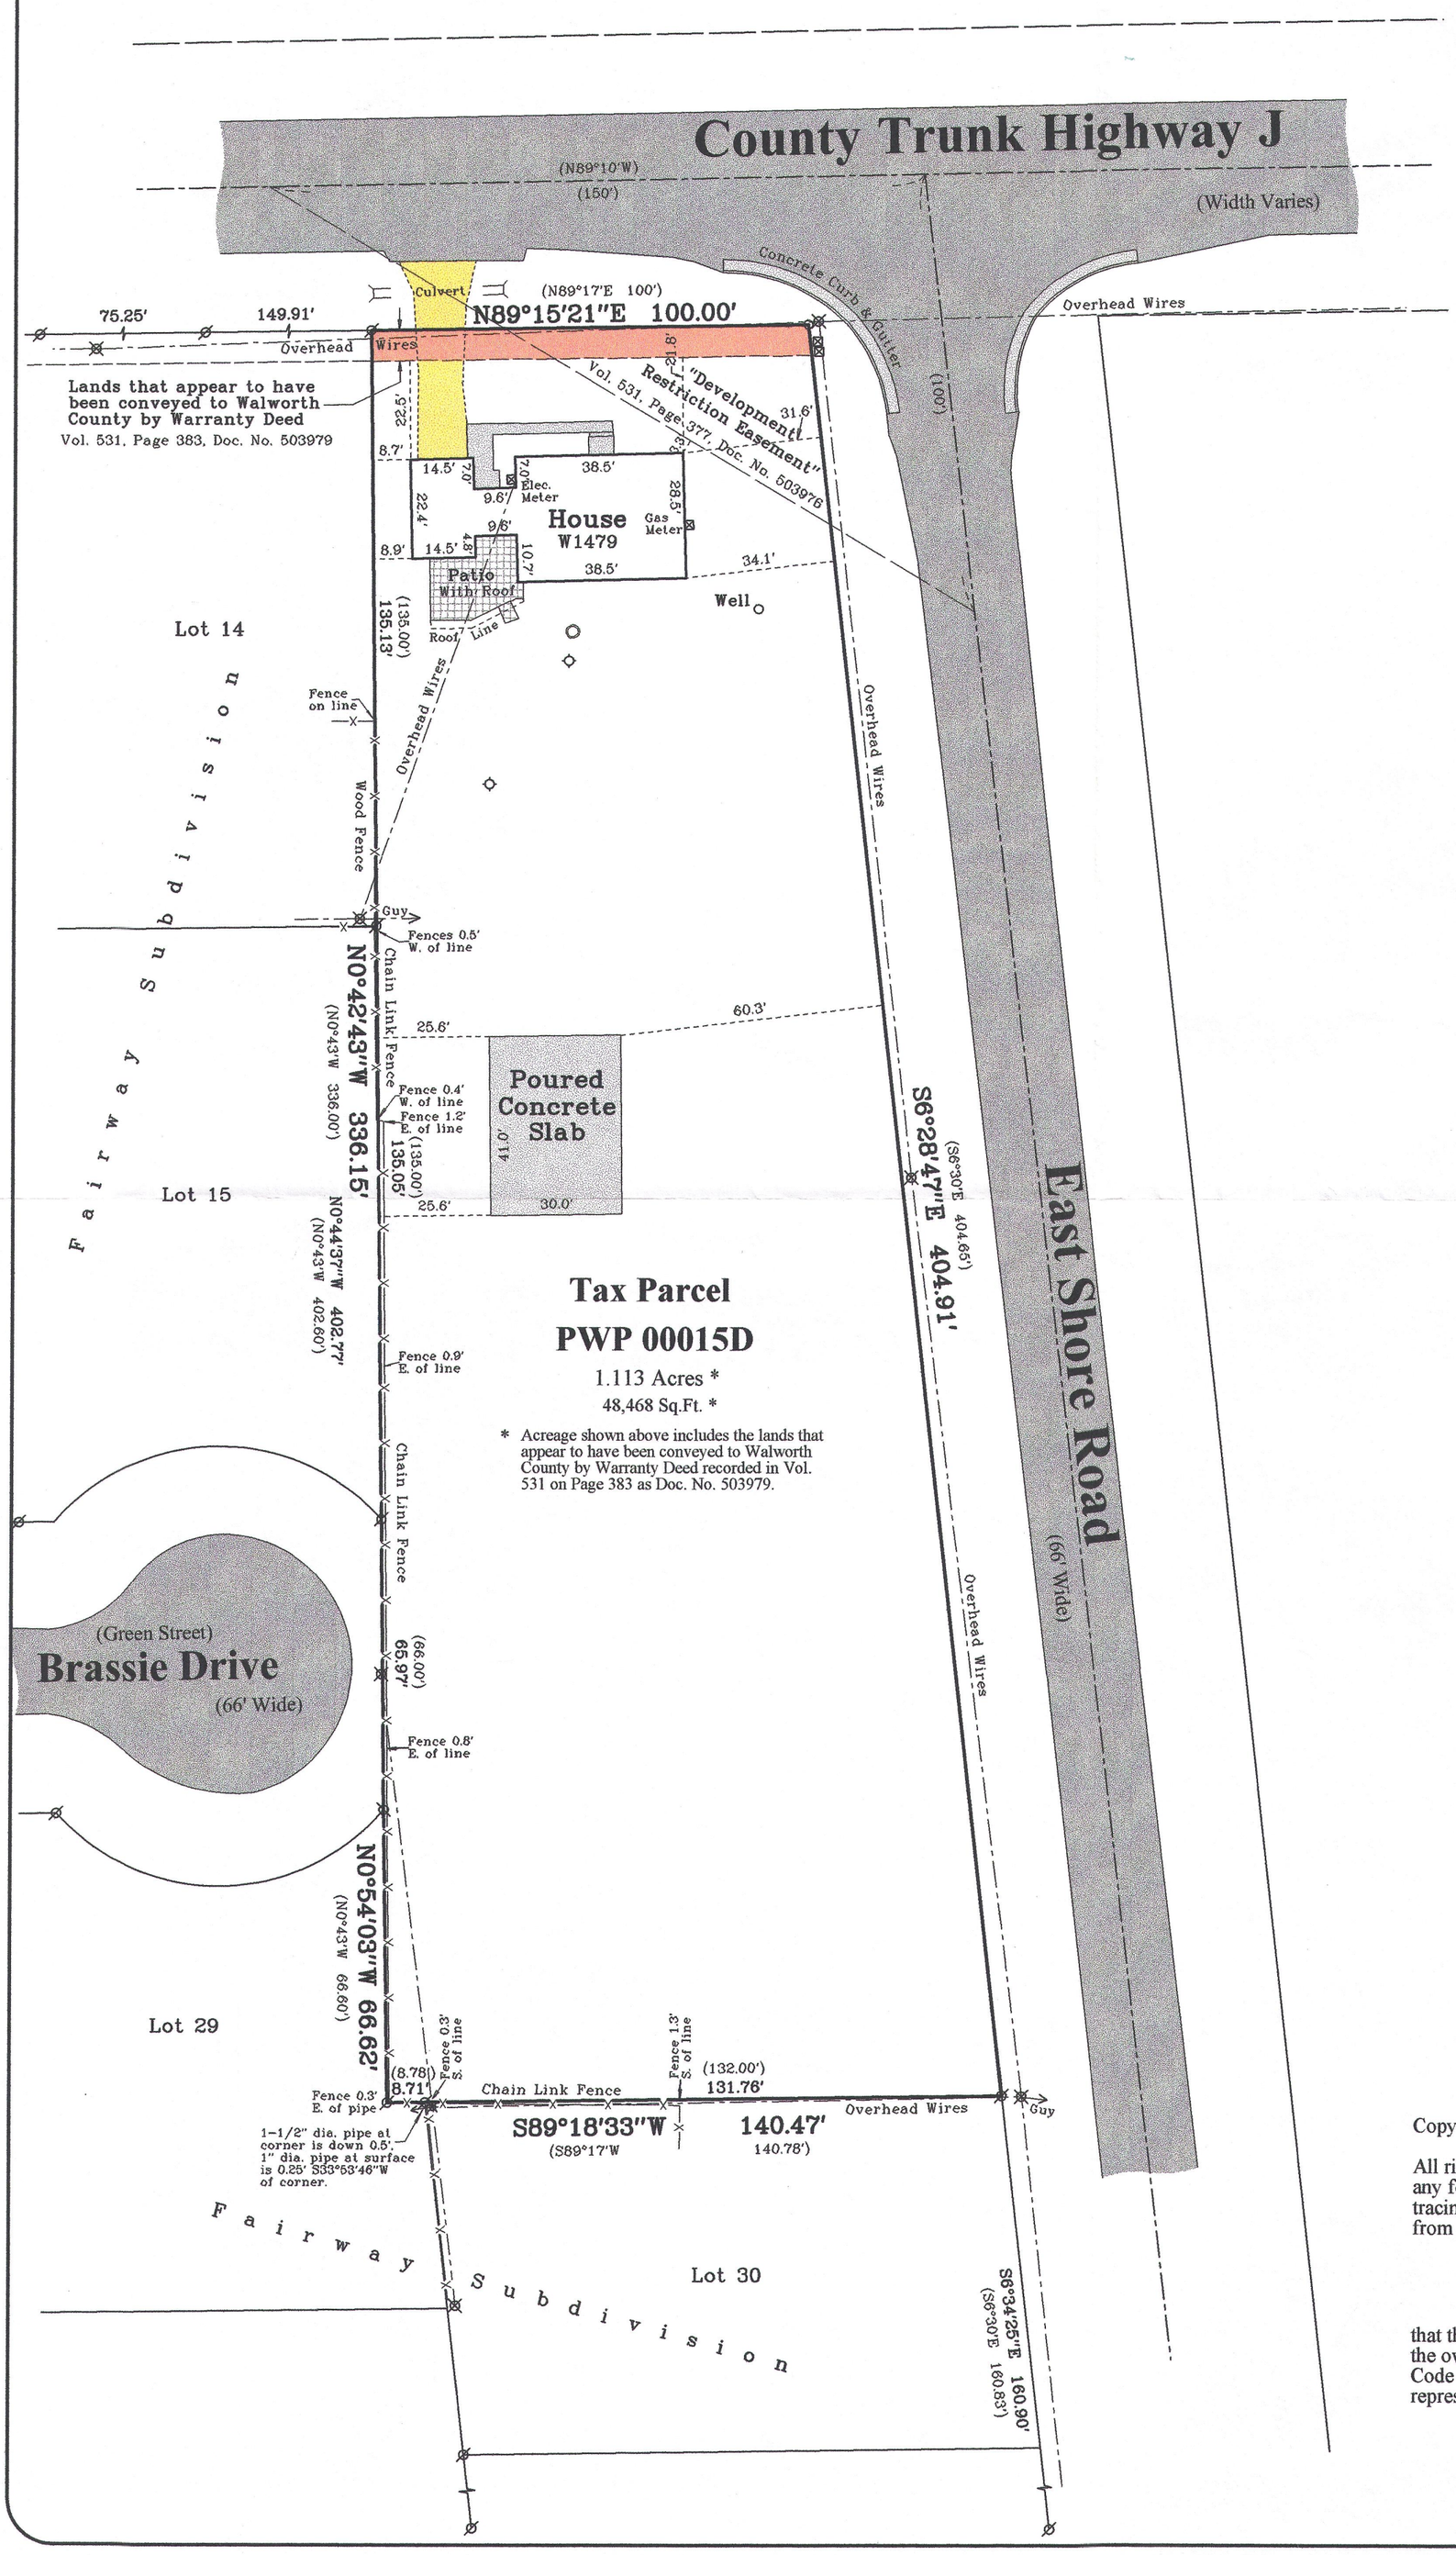

Surveyed for: **Mike Cliff**
W1479 County Road J
Mukwonago, Wisconsin. 53149

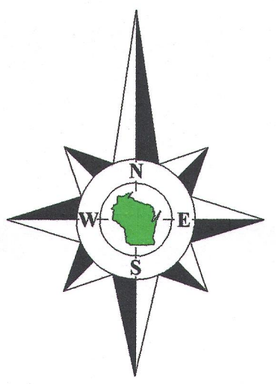

Bearings reference to the plat of Fairway Subdivision.

RECEIVED
JUN 1 2015
By

WISCONSIN
DOUGLAS OLSON
S-2093
ELKHORN, WI
LAND SURVEYOR

Not Certified Unless Stamped in Red.

Notes:

1) This survey plat is not certified unless signed and sealed in red ink.
2) This survey is subject to Wisconsin lien laws. This Plat of Survey is the notice of intent to file lien. Lien waiver required.

Copyright 2014 by Jensen & Olson Land Surveying, LLC.

All rights reserved. No part of this survey plat may be reproduced or transmitted in any form by any means - graphic, electronic, or mechanical, including photocopying, tracing, or information storage and retrieval systems - without permission in writing from Douglas G. Olson, Jensen & Olson Land Surveying, LLC.

I, Douglas G. Olson, Wisconsin Registered Land Surveyor, do hereby certify that this survey was performed by me, or under my direction in full compliance with the owner's/agent's instructions and Chapter A-E 7 of the Wisconsin Administrative Code "Minimum Standards for Property Surveys"; and that this map is an accurate representation thereof to the best of my knowledge and belief.

Douglas G. Olson
Wisconsin Registered Land Surveyor - 2093

2014.045

Sheet 1 of 1 Sheets

Drawing Name: t4nr18e-2014045-2014045Plat.scj

Job Reference Number
2014.045

Legend

Found Iron Pipe	Set Wood Stake
Set Iron Pipe, 1" dia.	
( ) Recorded Information	
Utility Pole	Pedestal
Concrete Cover	
Septic Vent	
Asphalt Surface	Concrete
Gravel Surface	Brick

Jensen & Olson Land Surveying, LLC
45 South Wisconsin Street * P.O. Box 322 * Elkhorn, Wisconsin. 53121
Telephone: (262) 723-3434 * Facsimile: (262) 723-8044
Email: jensen.olson@elknet.net

Scale in Feet
1" = 30'
0' 15' 30' 60'

Survey Date: June 3, 2014.
Revisions: No. 1 – Poured Concrete Foundation

PWP-15d

418-2441