PREPARED FOR:
DMS HOLDINGS LLC
MIKE KLUMB
W565 COUNTY RD. L
EAST TROY WI. 53120

PLAT OF SURVEY

-OF-

LOTS 1, 2 AND 3 OF CERTIFIED SURVEY MAP NO. 4351
LOCATED IN GOVERNMENT LOT 3 SECTION 9 TOWN 4
NORTH, RANGE 18 EAST, WALWORTH COUNTY, WISCONSIN.

LYNCH & ASSOCIATES
ENGINEERING CONSULTANTS, LLC.
405 SKYLINE DRIVE, SUITE C
LAKE GENEVA, WI 53147
(262) 248-3697

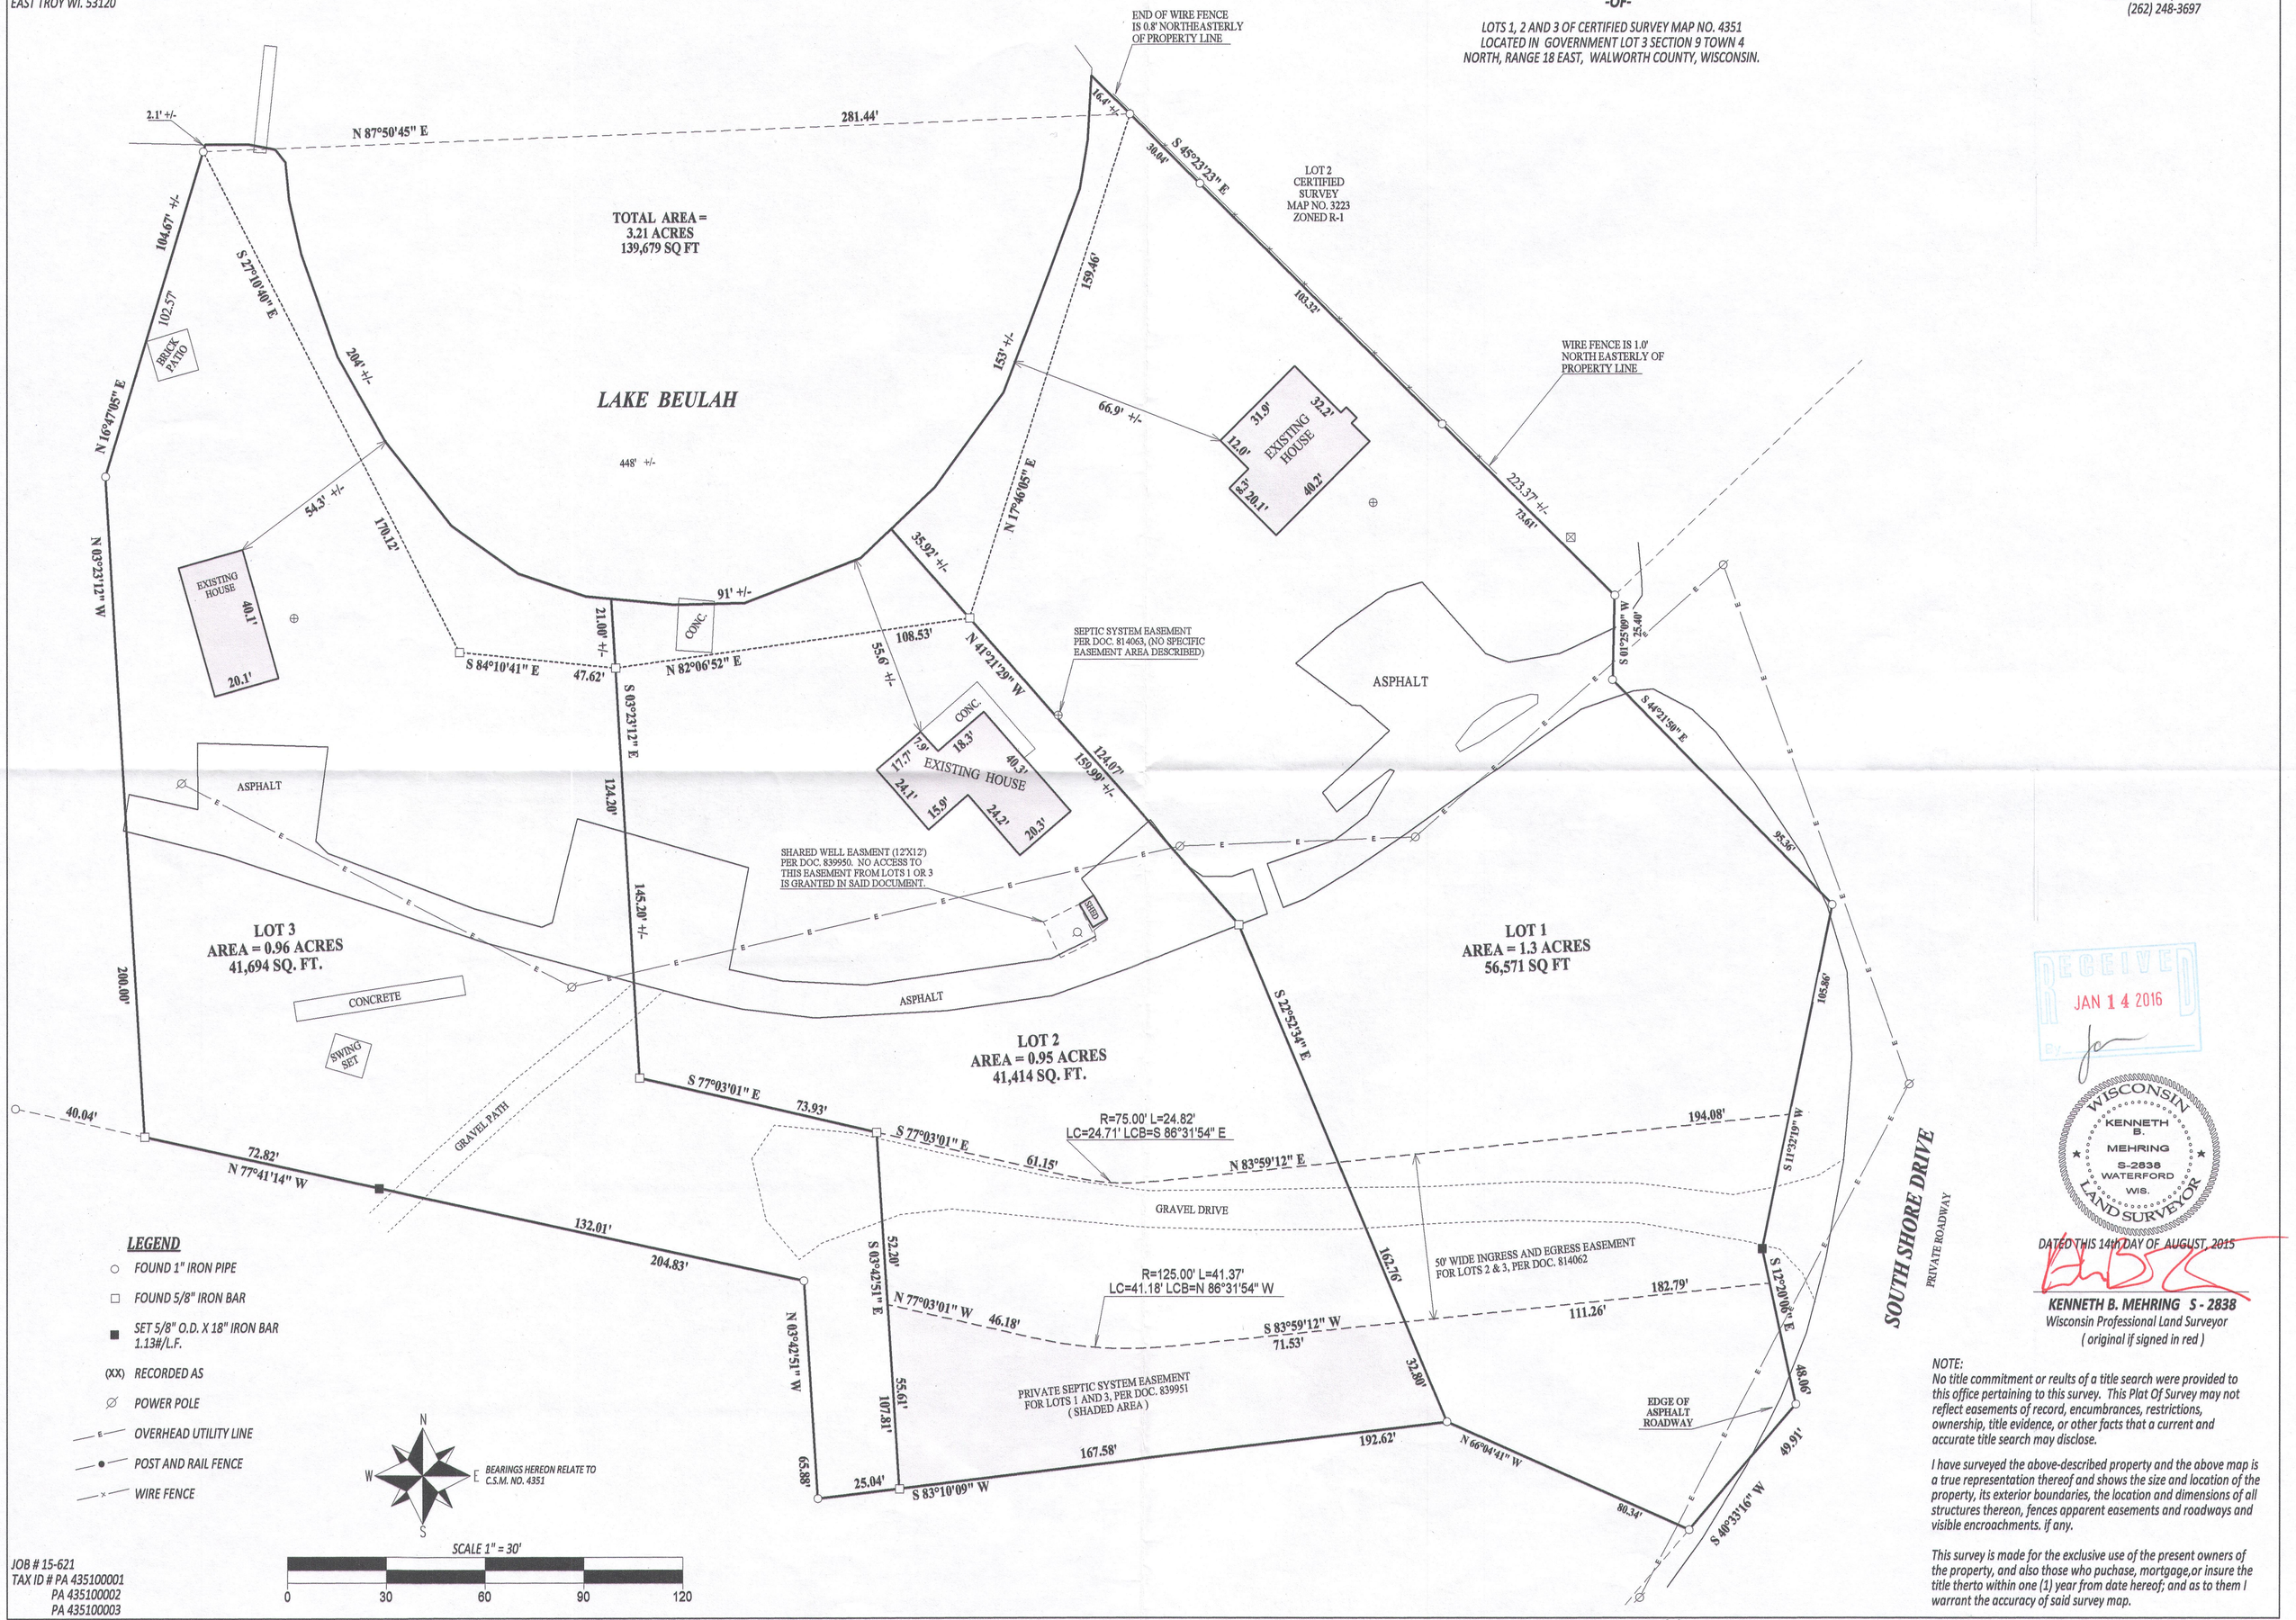

RECEIVED
JAN 14 2016
BY:

WISCONSIN
KENNETH B. MEHRING
S-2838
WATERFORD
WIS.
LAND SURVEYOR

DATED THIS 14th DAY OF AUGUST, 2015

KENNETH B. MEHRING S - 2838
Wisconsin Professional Land Surveyor
(original if signed in red)

NOTE:
No title commitment or reults of a title search were provided to this office pertaining to this survey. This Plat Of Survey may not reflect easements of record, encumbrances, restrictions, ownership, title evidence, or other facts that a current and accurate title search may disclose.

I have surveyed the above-described property and the above map is a true representation thereof and shows the size and location of the property, its exterior boundaries, the location and dimensions of all structures thereon, fences apparent easements and roadways and visible encroachments. if any.

This survey is made for the exclusive use of the present owners of the property, and also those who puchase, mortgage,or insure the title therto within one (1) year from date hereof; and as to them I warrant the accuracy of said survey map.

LEGEND

- FOUND 1" IRON PIPE
- FOUND 5/8" IRON BAR
- SET 5/8" O.D. X 18" IRON BAR 1.13#/L.F.
- (XX) RECORDED AS
- POWER POLE
- OVERHEAD UTILITY LINE
- POST AND RAIL FENCE
- WIRE FENCE

N W E S — BEARINGS HEREON RELATE TO C.S.M. NO. 4351

SCALE 1" = 30'

0 30 60 90 120

JOB # 15-621
TAX ID # PA 435100001
PA 435100002
PA 435100003

PA4351-1
PA4351-2
PA4351-3

418-2478