
Plat of Survey

LOT S 107 AND 108 IN O-TON-KAH SUBDIVISION, located in Section 10, Town 4 North, Range 18 East, Town of East Troy, Walworth County, Wisconsin.

ALSO: That portion of **OUTLOT B, O-TON-KAH SUBDIVISION**, lying Northerly of the Southerly line of Lot 107 extended Westerly to the West side of said Outlot.

ALSO: That portion of vacated **O-TON-KAH Drive** lying between the Southerly line of Lot 107 extended and Northerly line of Lot 108 extended.

Surveyed for: Clara Berger

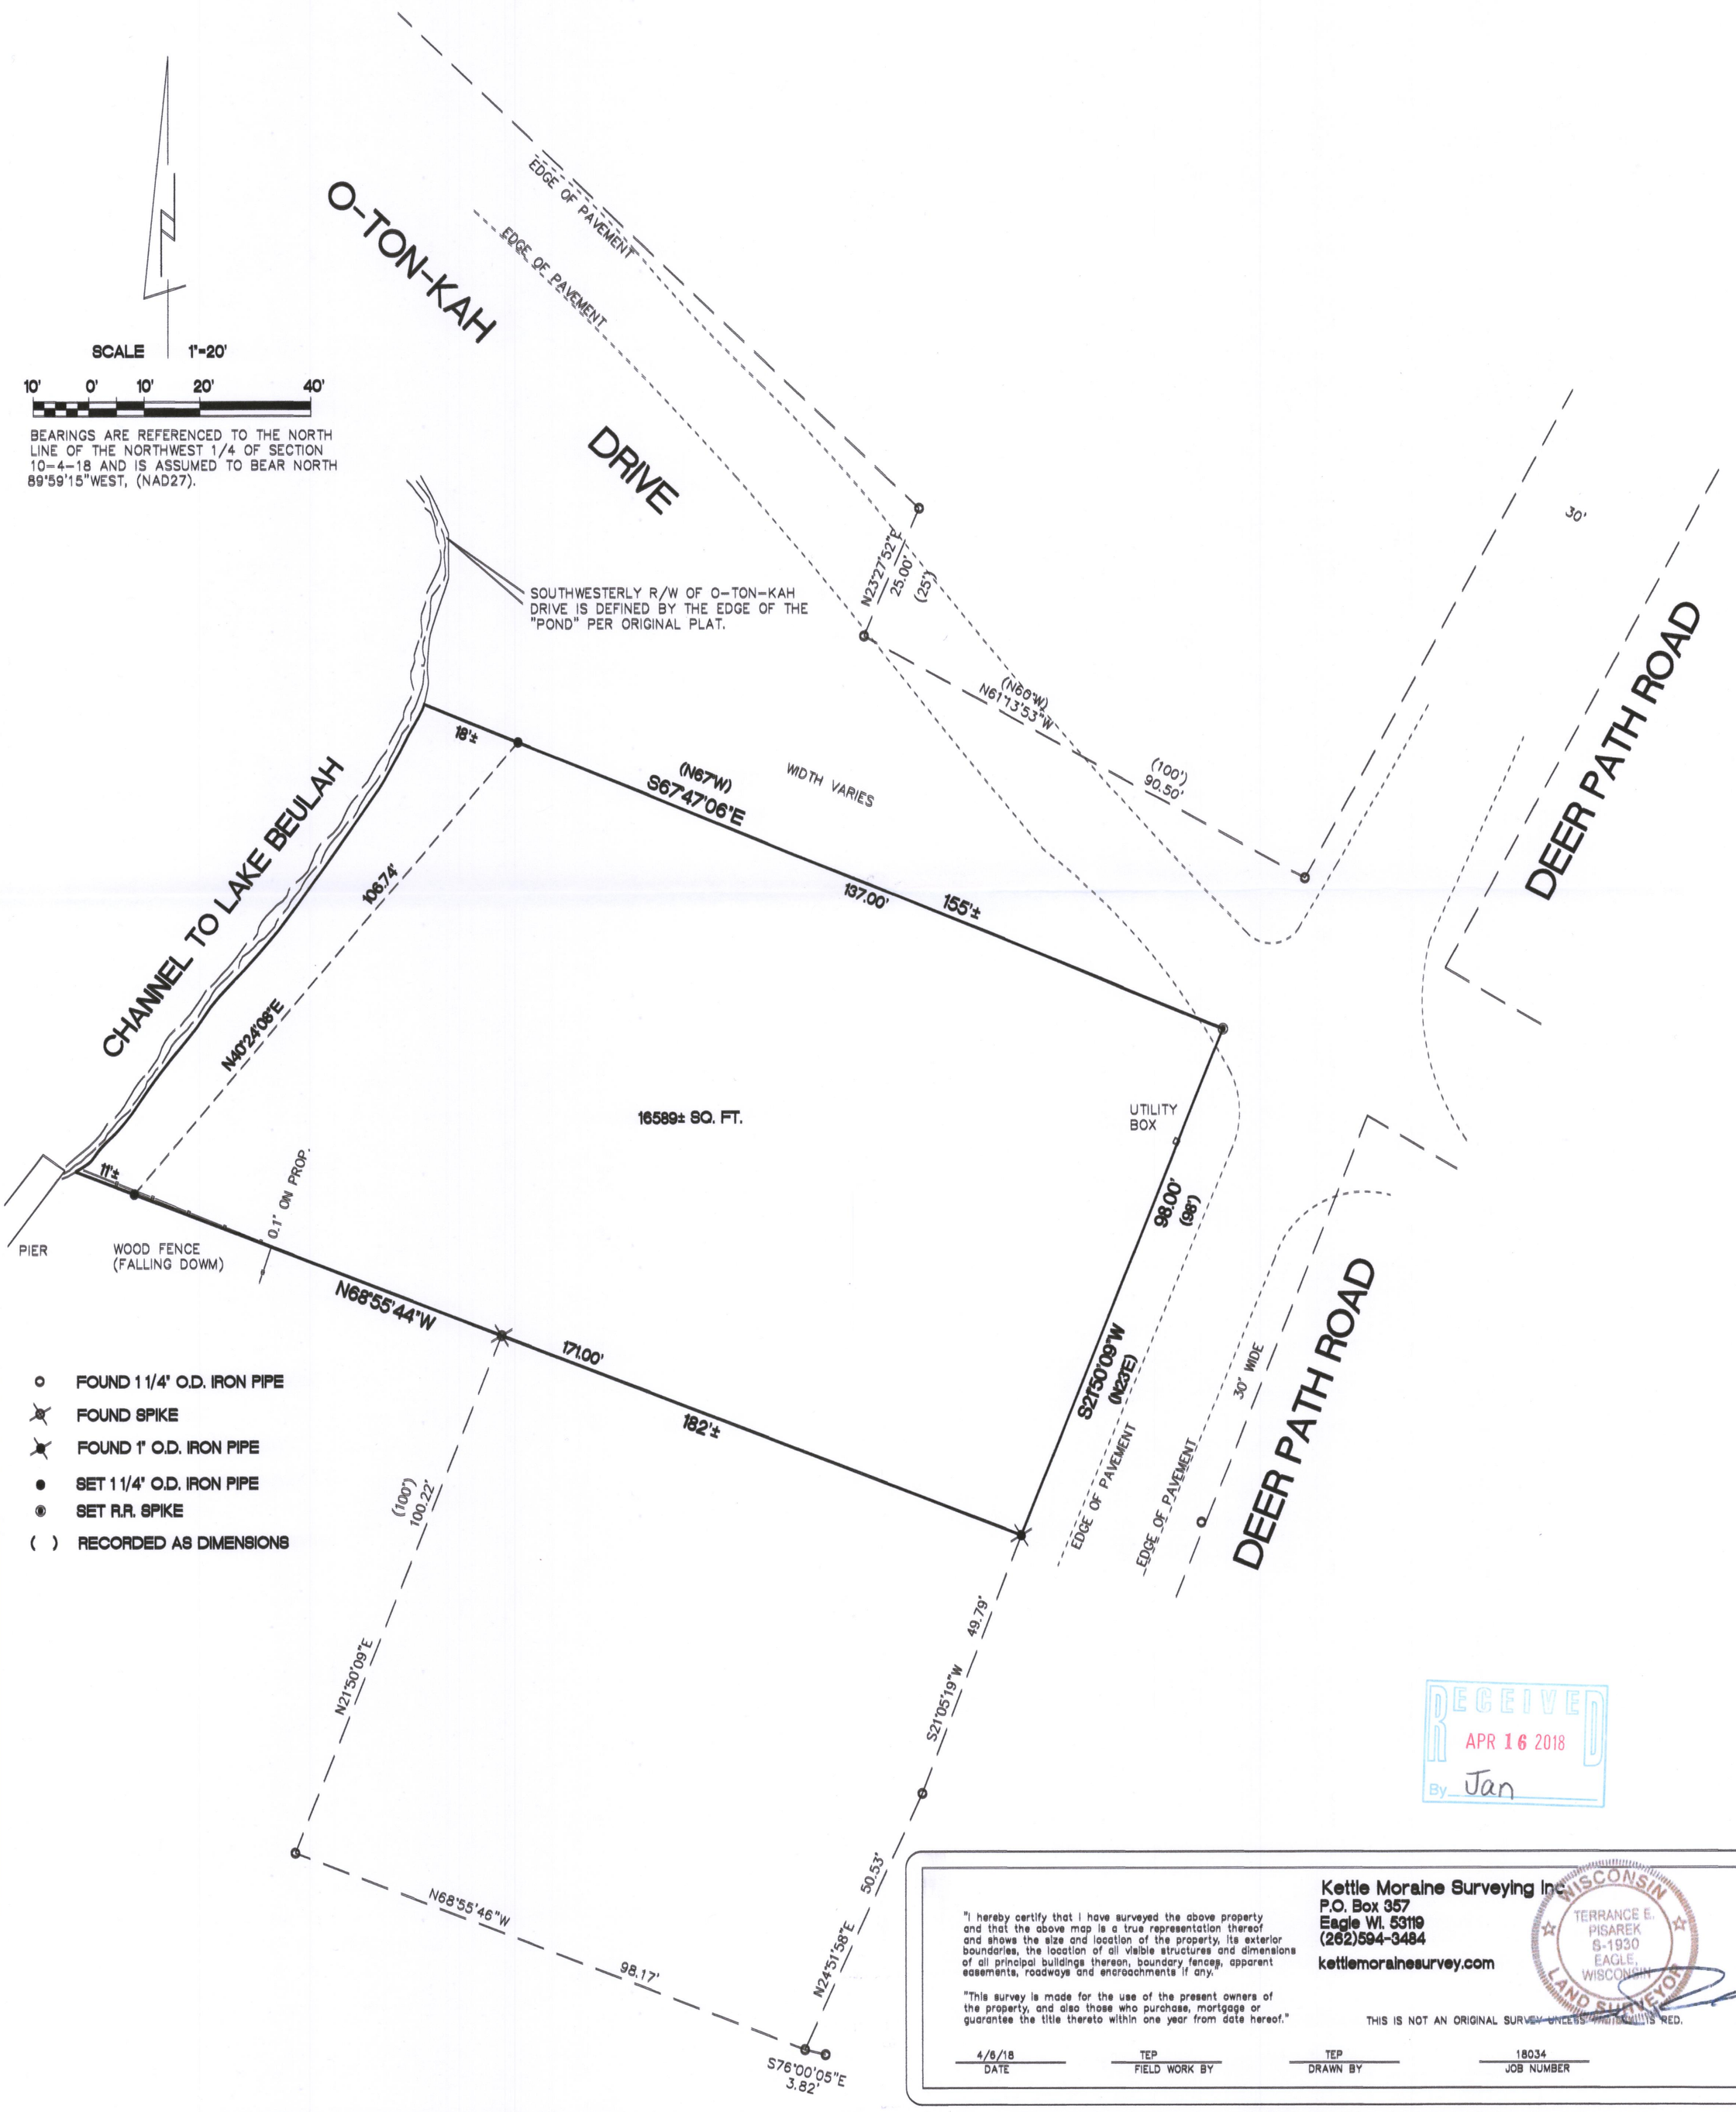

RECEIVED
APR 16 2018
By Jan

"I hereby certify that I have surveyed the above property and that the above map is a true representation thereof and shows the size and location of the property, its exterior boundaries, the location of all visible structures and dimensions of all principal buildings thereon, boundary fences, apparent easements, roadways and encroachments if any."

"This survey is made for the use of the present owners of the property, and also those who purchase, mortgage or guarantee the title thereto within one year from date hereof."

Kettle Moraine Surveying Inc.
P.O. Box 357
Eagle WI. 53119
(262)594-3484
kettlemorainesurvey.com

WISCONSIN
TERRANCE E. PISAREK
S-1930
EAGLE, WISCONSIN
LAND SURVEYOR

THIS IS NOT AN ORIGINAL SURVEY UNLESS [illegible] IS RED.

4/6/18	TEP	TEP	18034
DATE	FIELD WORK BY	DRAWN BY	JOB NUMBER

POT-41B 418-2592