.K.R. SURVEYING, INC.
121 22ND AVENUE
ENOSHA, WI 53143

WISCONSIN
JEFFREY K. RAMPART
S-2141
KENOSHA, WI
LAND SURVEYOR

I hereby certify that this property was surveyed under my direction and this plat is a true representation thereof.

Reg. Land Surveyor

January 15, 2018
Revised 1/17/18
Revised 1/26/18
Revised 5/2/18

Scale
1" = 50'

denotes iron pipe

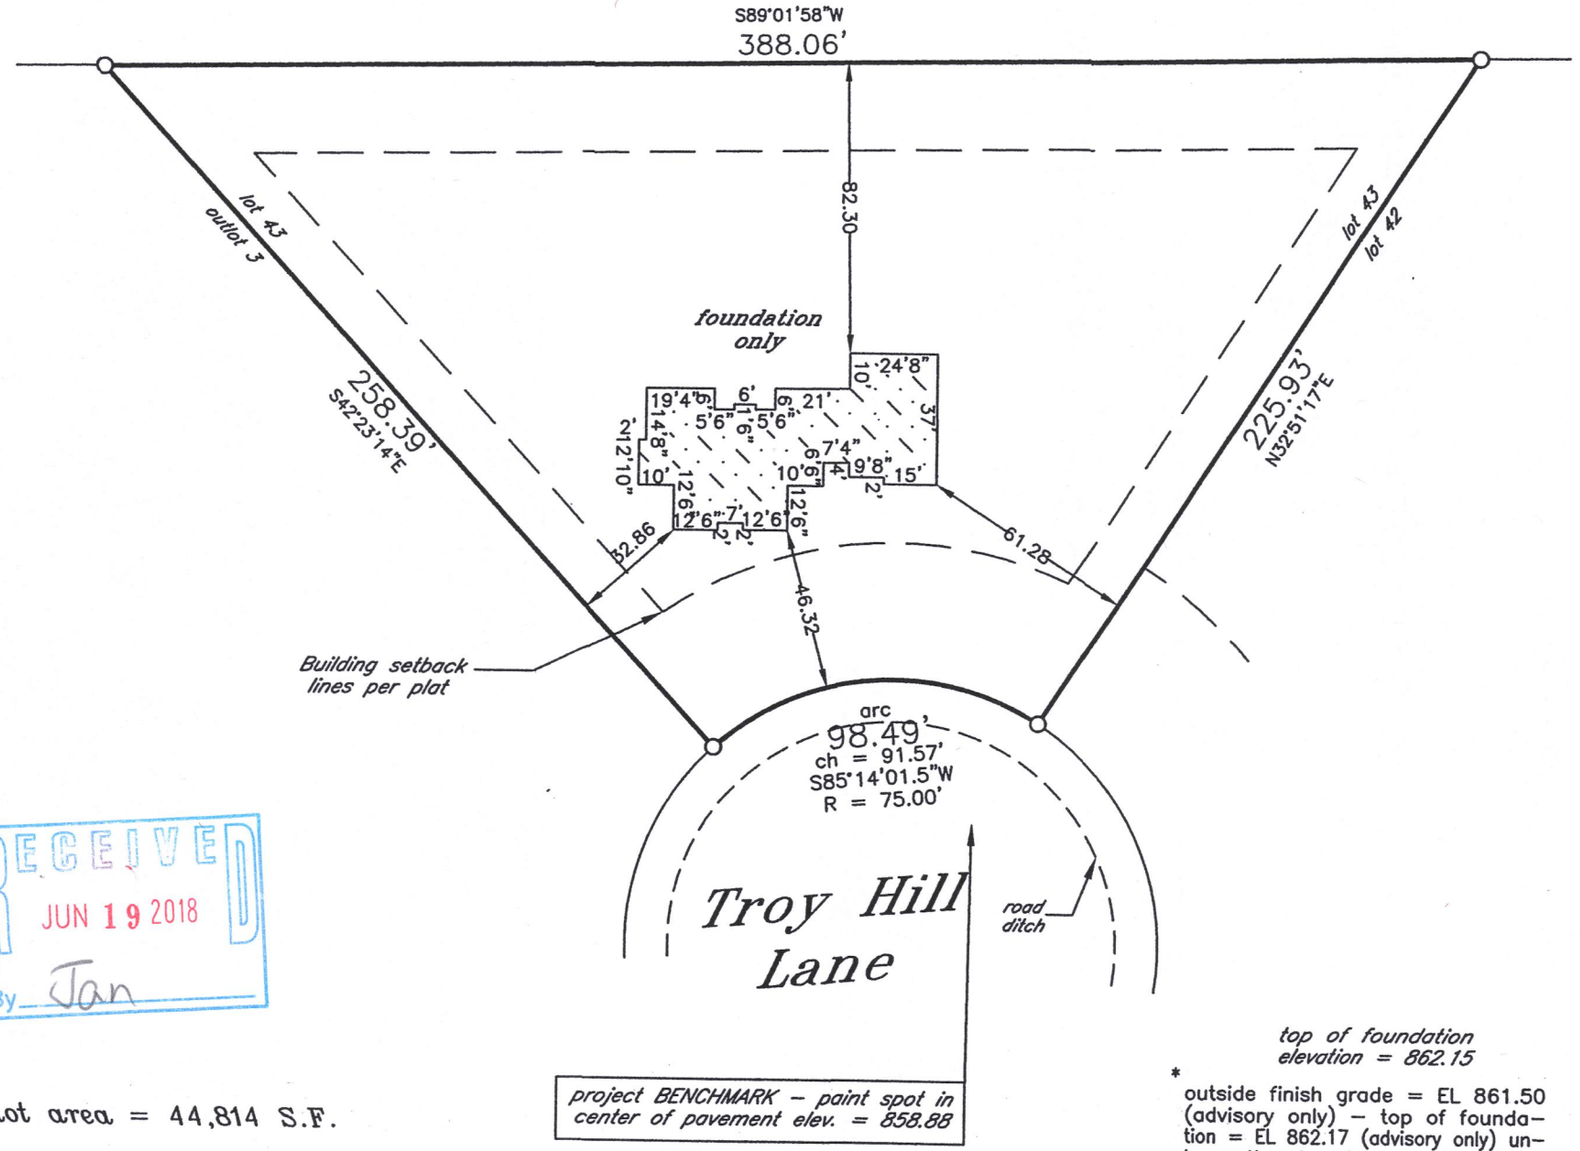

Plat of Survey of

LOT 43 IN

TROY HILL ESTATES

n SW1/4 Section 30-4-18

TOWN OF EAST TROY
WALWORTH COUNTY, WIS.

–for–
Hagen Homes

RECEIVED
JUN 19 2018
By Jan

lot area = 44,814 S.F.

* Verify exact number with Town Engineering Department

top of foundation elevation = 862.15

* outside finish grade = EL 861.50 (advisory only) – top of foundation = EL 862.17 (advisory only) unless otherwise determined in writing by Town Engineering Department

Proposed building field staked true size. Contractor to verify all dimensions before building by same and adhere to drainage plan in effect for this subdivision. Refer to a current title report for easements or restrictions which may affect the use of this site that are not shown on the recorded subdivision plat.

PTHE-43 418-2609