418-276

PLAT OF SURVEY


OF

LOT 8 AND LOT 9 OF FAIRWAY SUBDIVISION, BEING A RESUBDIVISION OF PART OF WILLIAMS PARK SUBDIVISION, LOCATED IN THE SW¼ NE¼ AND THE SE¼ NW¼ OF SEC. 4, T4N-R18E, WALWORTH COUNTY, WISCONSIN

WISCONSIN
THOMAS P. A. JENSEN
S-1084
ELKHORN, WIS.
LAND SURVEYOR

NOTE: ALL PROPERTY CORNERS ALONG HWY. "J" ARE MISSING OR BENT FROM HWY. CONST.

℄ HIGHWAY "J"
66' WIDE

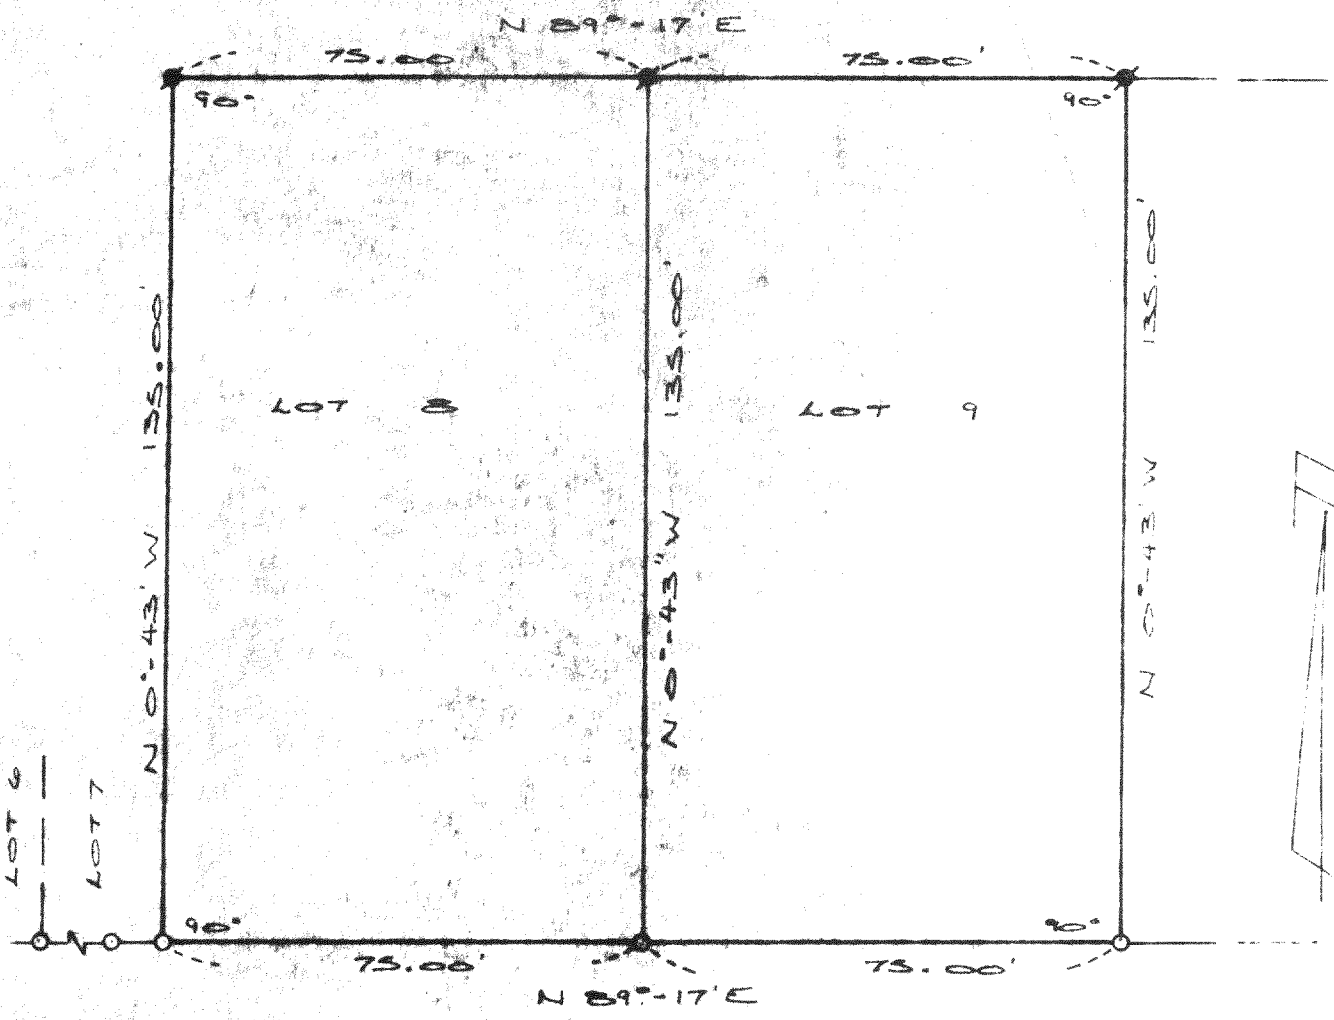

SURVEYED FOR: BIELINSKI REALTY, INC.
2910 N. GRANDVIEW BLVD
WAUKESHA, WIS. 53186

SURVEY AND PLAT BY

JENSEN & JOHNSON, INC.
CIVIL ENGINEERS AND SURVEYORS
Elkhorn, Wisconsin

LEGEND

O — Iron Pipe FOUND
● — Concrete Monument
Scale 1" = 30'
■ - ¾" DIA. x 24" LONG IRON ROD SET

WE CERTIFY: That we have surveyed the above described property and that the plat shown hereon is an accurate survey and a true representation thereof and correctly shows the exterior boundary lines and all divisions of said property.

Date Mar 24, 1976 Thomas P. A. Jensen
[redacted],
Wisconsin Registered Land Surveyor, No. [redacted] 1084

PF-8,9

418-276