
418-277

PLAT OF SURVEY

OF

LOT 9 OF FAIRWAY SUBDIVISION, BEING A RESUBDIVISION OF PART OF WILLIAMS PARK SUBDIVISION, LOCATED IN THE SW¼ NE¼ AND THE SE¼ NW¼ OF SECTION 4, T4N R18E. WALWORTH COUNTY, WISCONSIN.

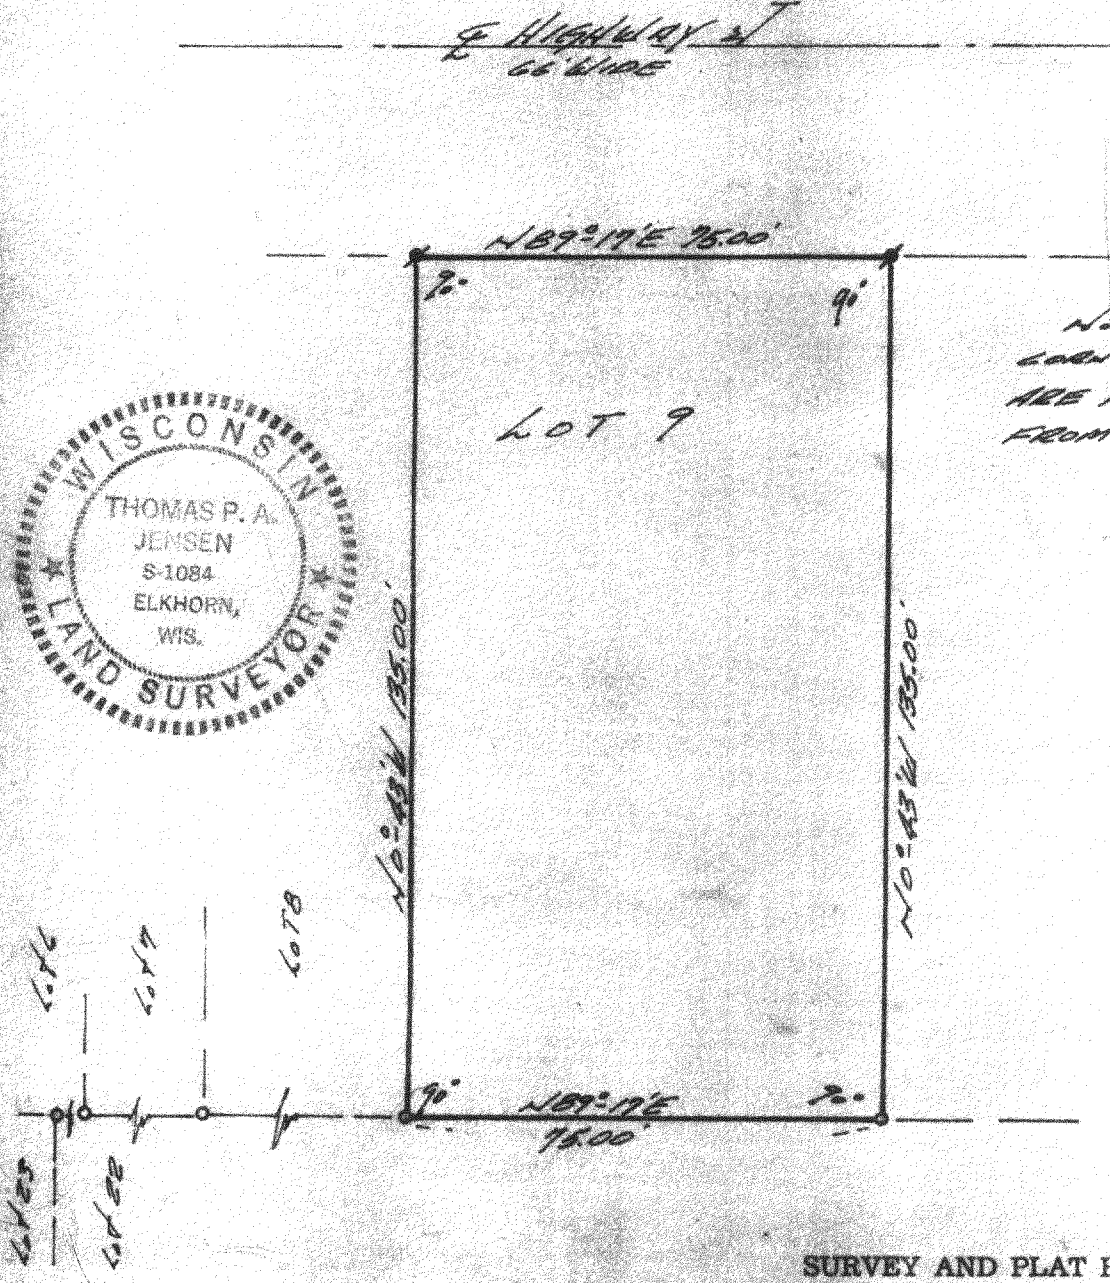

NOTE: ALL PROPERTY CORNERS ALONG HWY "J" ARE MISSING OR BENT FROM HWY CONSTRUCTION.

THOMAS P. A. JENSEN S-1084 ELKHORN, WIS. WISCONSIN LAND SURVEYOR

SURVEY AND PLAT BY

JENSEN & JOHNSON, INC.
CIVIL ENGINEERS AND SURVEYORS
Elkhorn, Wisconsin

SURVEYED FOR: BIELINSKI REALTY, INC.
2910 N. GRANDVIEW BLVD
WAUKESHA, WIS 53186

LEGEND

- ○ — Iron Pipe FOUND
- ● — Concrete Monument
- Scale 1" = 30'
- ▮ — 3/4" DIA x 24" LONG IRON ROD SET

WE CERTIFY: That we have surveyed the above described property and that the plat shown hereon is an accurate survey and a true representation thereof and correctly shows the exterior boundary lines and all divisions of said property.

Date MARCH 18, 1976 Thomas P. A. Jensen [redacted],
Wisconsin Registered Land Surveyor, No. S-[redacted] 1084

PF-9

418-277

X